


HOME OFFICE
109 SOUTH SPRING STREET
BURLINGTON, WISCONSIN 53108
PHONE: 414-763-2652
414-763-7834

ROBERS & BOYD, INC.
CONSULTING ENGINEERS
LAND SURVEYORS

BRANCH OFFICE
809 - 43RD STREET
KENOSHA, WISCONSIN 53140
PHONE: 414-658-4488


PLAT OF SURVEY
For
LYLE ANDRESEN
Of

That part of the Northeast 1/4 of Section 35, Town 1 North, Range 18 East, Village of Genoa City, County of Walworth, State of Wisconsin and more particularly described as follows: Begin at the Northwest corner of Lot 5, Block 4 of Gifford's Addition to the Village of Genoa City, run thence North $0^{\circ}11'30''$ East along the East line of Freeman Street 66.00 feet; thence South $89^{\circ}16'30''$ East 132.00 feet; thence South $0^{\circ}11'30''$ West 66.00 feet to the Northeast corner of said Lot 5, thence North $89^{\circ}16'30''$ West along the North line of said Lot 5 132.00 feet to the point of beginning.

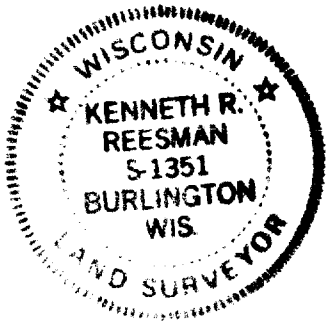

LEGEND

- ▲ SET $\frac{1}{2}$ " REBAR
 - SET $1\frac{1}{8}$ " IRON PIPE
- SCALE - 1" = 30'

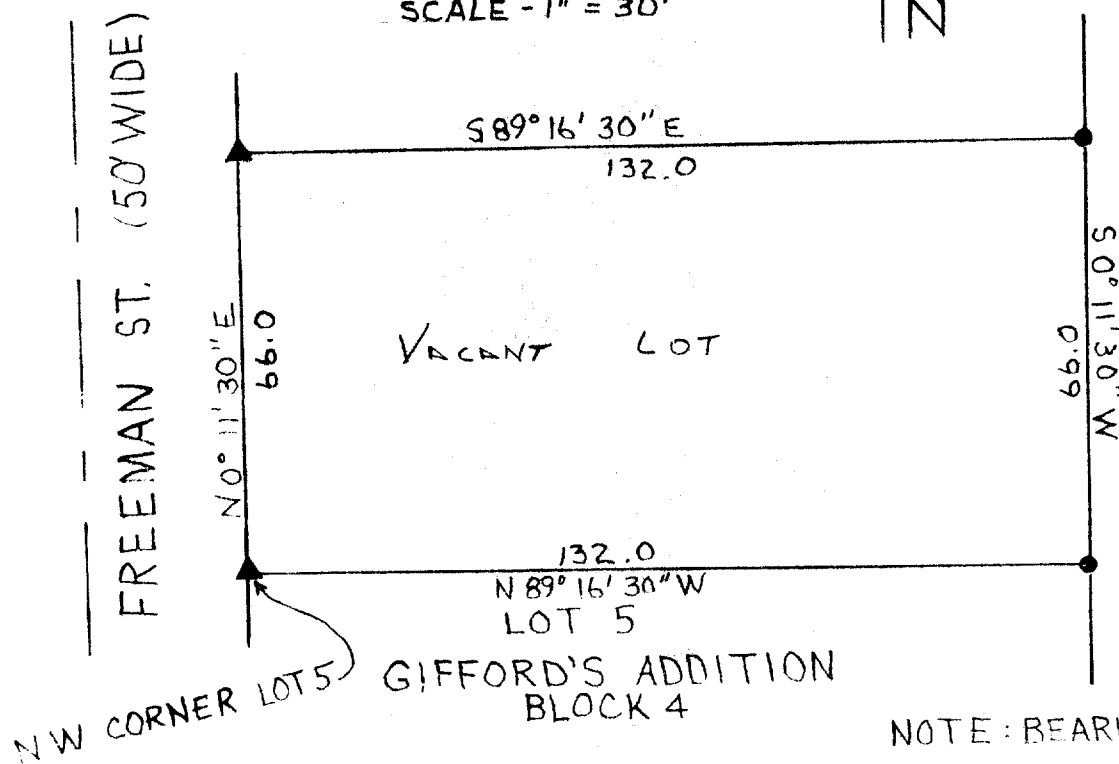

"I CERTIFY THAT I HAVE SURVEYED THE ABOVE DESCRIBED PROPERTY AND THAT THE ABOVE PLAT IS AN ACCURATE SURVEY AND A TRUE REPRESENTATION THEREOF AND CORRECTLY SHOWS THE EXTERIOR BOUNDARY LINES AND LOCATION OF BUILDINGS ON SAID PROPERTY AND THE CORRECT MEASUREMENTS THEREOF."

Kenneth R. Reesman
WISCONSIN REGISTERED LAND SURVEYOR

VGC-11 (part)
7-21-78
DATE

NOTE: BEARINGS ARE
RELATIVE TO THE
EAST LINE OF FREE-
MAN STREET. N $0^{\circ}11'30''$ E

78136-C
JOB NUMBER