


Oak Ridge Lane

(80' 1/4)

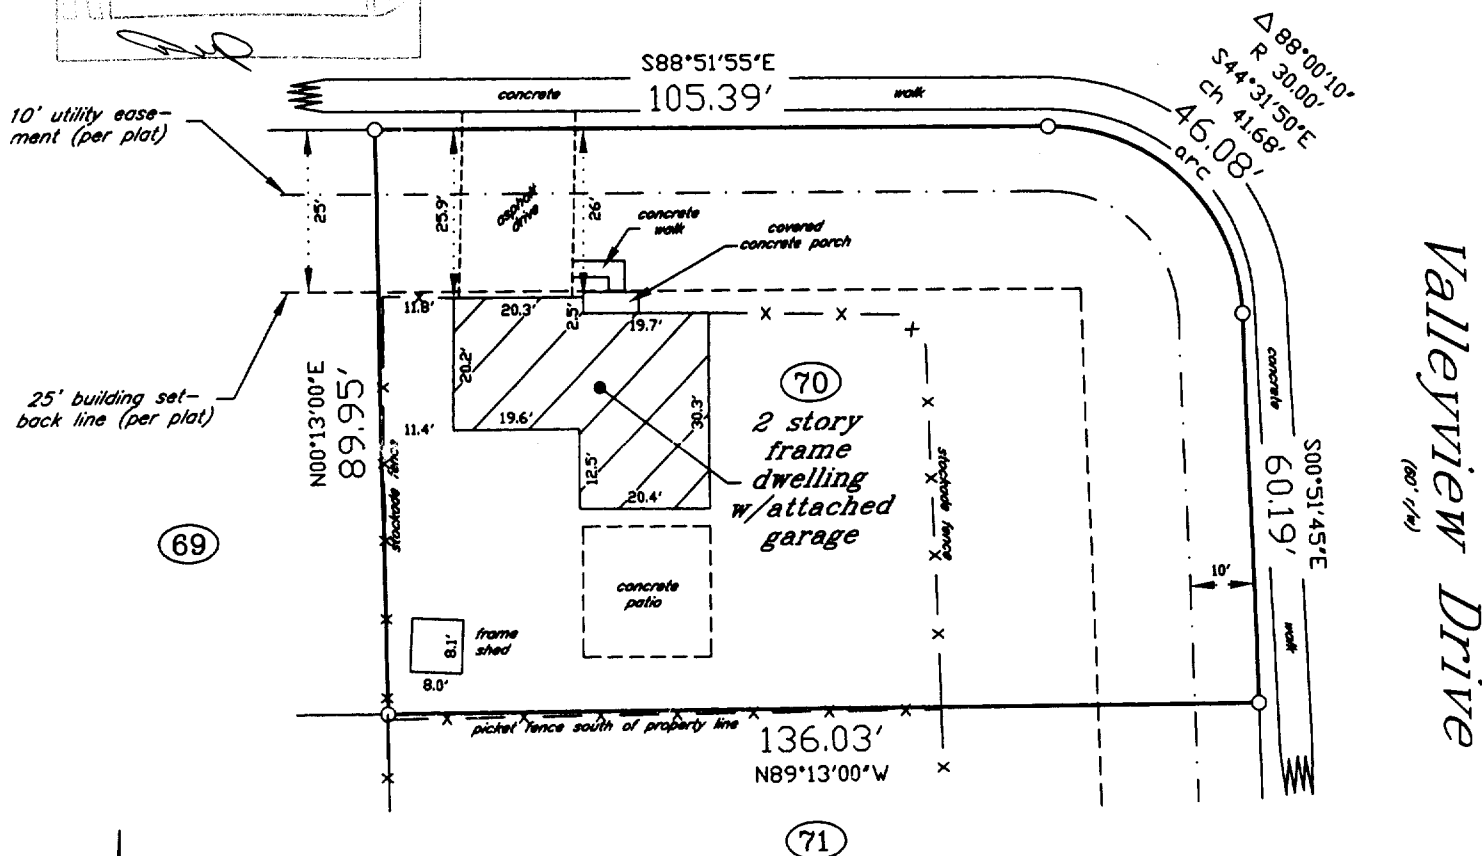

LEGAL DESCRIPTION (AS FURNISHED)

Lot Seventy (70) in RIDGEVIEW SUBDIVISION, located in part of the Northeast One-quarter (1/4), Northwest One-quarter (1/4) and Southeast One-quarter (1/4) of the Southwest One-quarter (1/4) of Section Thirty-five (35), in Township One (1) North, Range Eighteen (18) East, in the Village of Genoa City, County of Walworth, State of Wisconsin.

Scale
1" = 30'

SELLER: Bank of New York, as Trustee under the Pooling and Servicing Agreement Series 1997-4

BUYER: Frederick and Dorothy Diedrich

MARESCALCO COUNTYWIDE SURVEYING, INC.
1120 80TH STREET KENOSHA, WI 53143
(262) 654 6809 FAX (262) 654 1120

tax key parcel no.: TRID 00070

address: 917 Oakridge Lane

I hereby certify that the above described property was surveyed under my direction and that this plat is a true representation thereof and shows the size and location of the property, its exterior boundaries, the location and dimensions of all visible structures thereon, fences, apparent easements and roadways and visible encroachments, if any.

This survey is made for the exclusive use of the present owners of the property, and those who purchase, mortgage or guarantee the title thereto, within one (1) year from the date hereof.



SURVEYOR
May 1, 2003

Plat of Survey of
LOT 70
RIDGEVIEW SUBDIVISION

in SW1/4 Section 35-1-18

VILLAGE OF GENOA CITY
WALWORTH COUNTY, WIS.

-for-
Rondon Realty / Angel Rondon-Roach

006-1098