


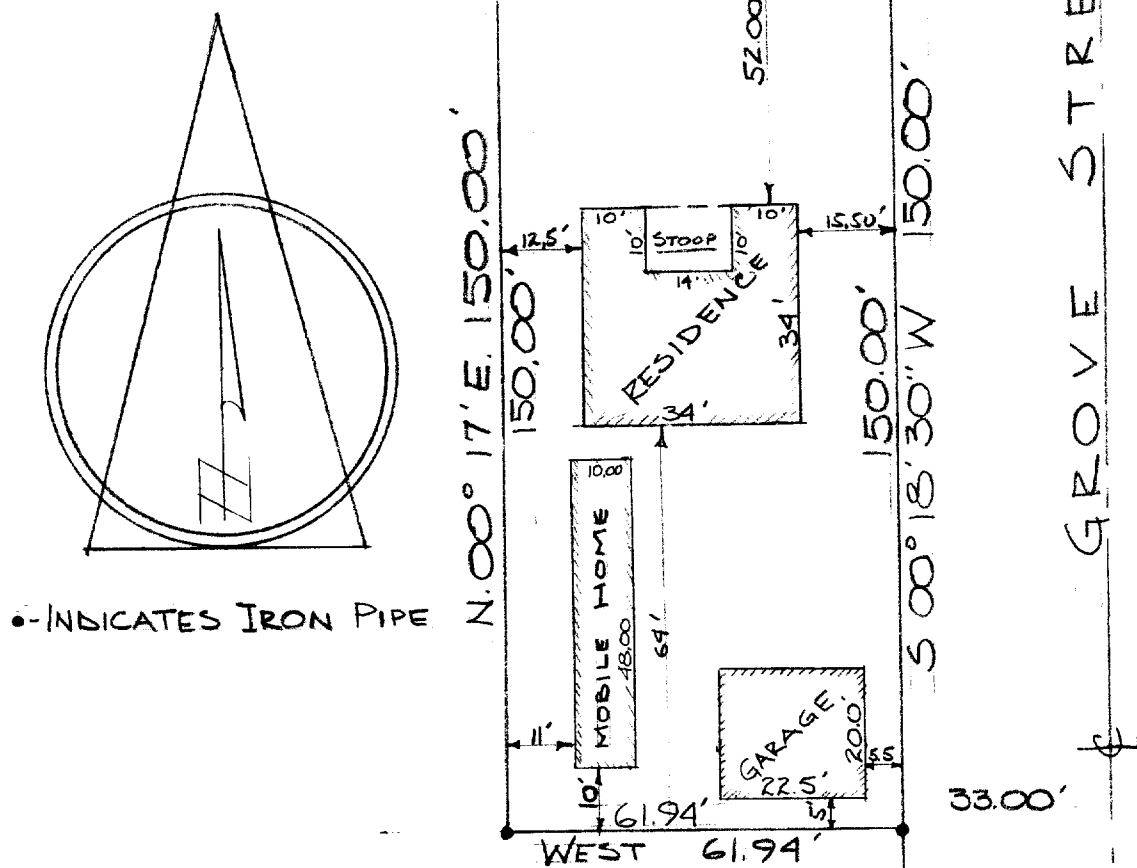

DESCRIPTION:

Lot 5, Zarnstorff Subdivision of a portion of Genoa City,
Walworth County, Wisconsin.

CERTIFICATE:

I, James F. Biagi, surveyor, hereby certify that I have surveyed the property hereon described and the location of the improvements are as shown.

May 23rd 1963.

JAMES F.
BIAGI
MILWAUKEE,
WIS.

James F. Biagi. RLS 272
Elkhorn, Wisconsin.