


HAROLD H. KOLB
 REGISTERED PROFESSIONAL LAND SURVEYOR
 LAKE GENEVA, WISCONSIN

KOSSUTH STREET
 82.50' WIDE

STREET
 WIDE

FREEMAN
 66'

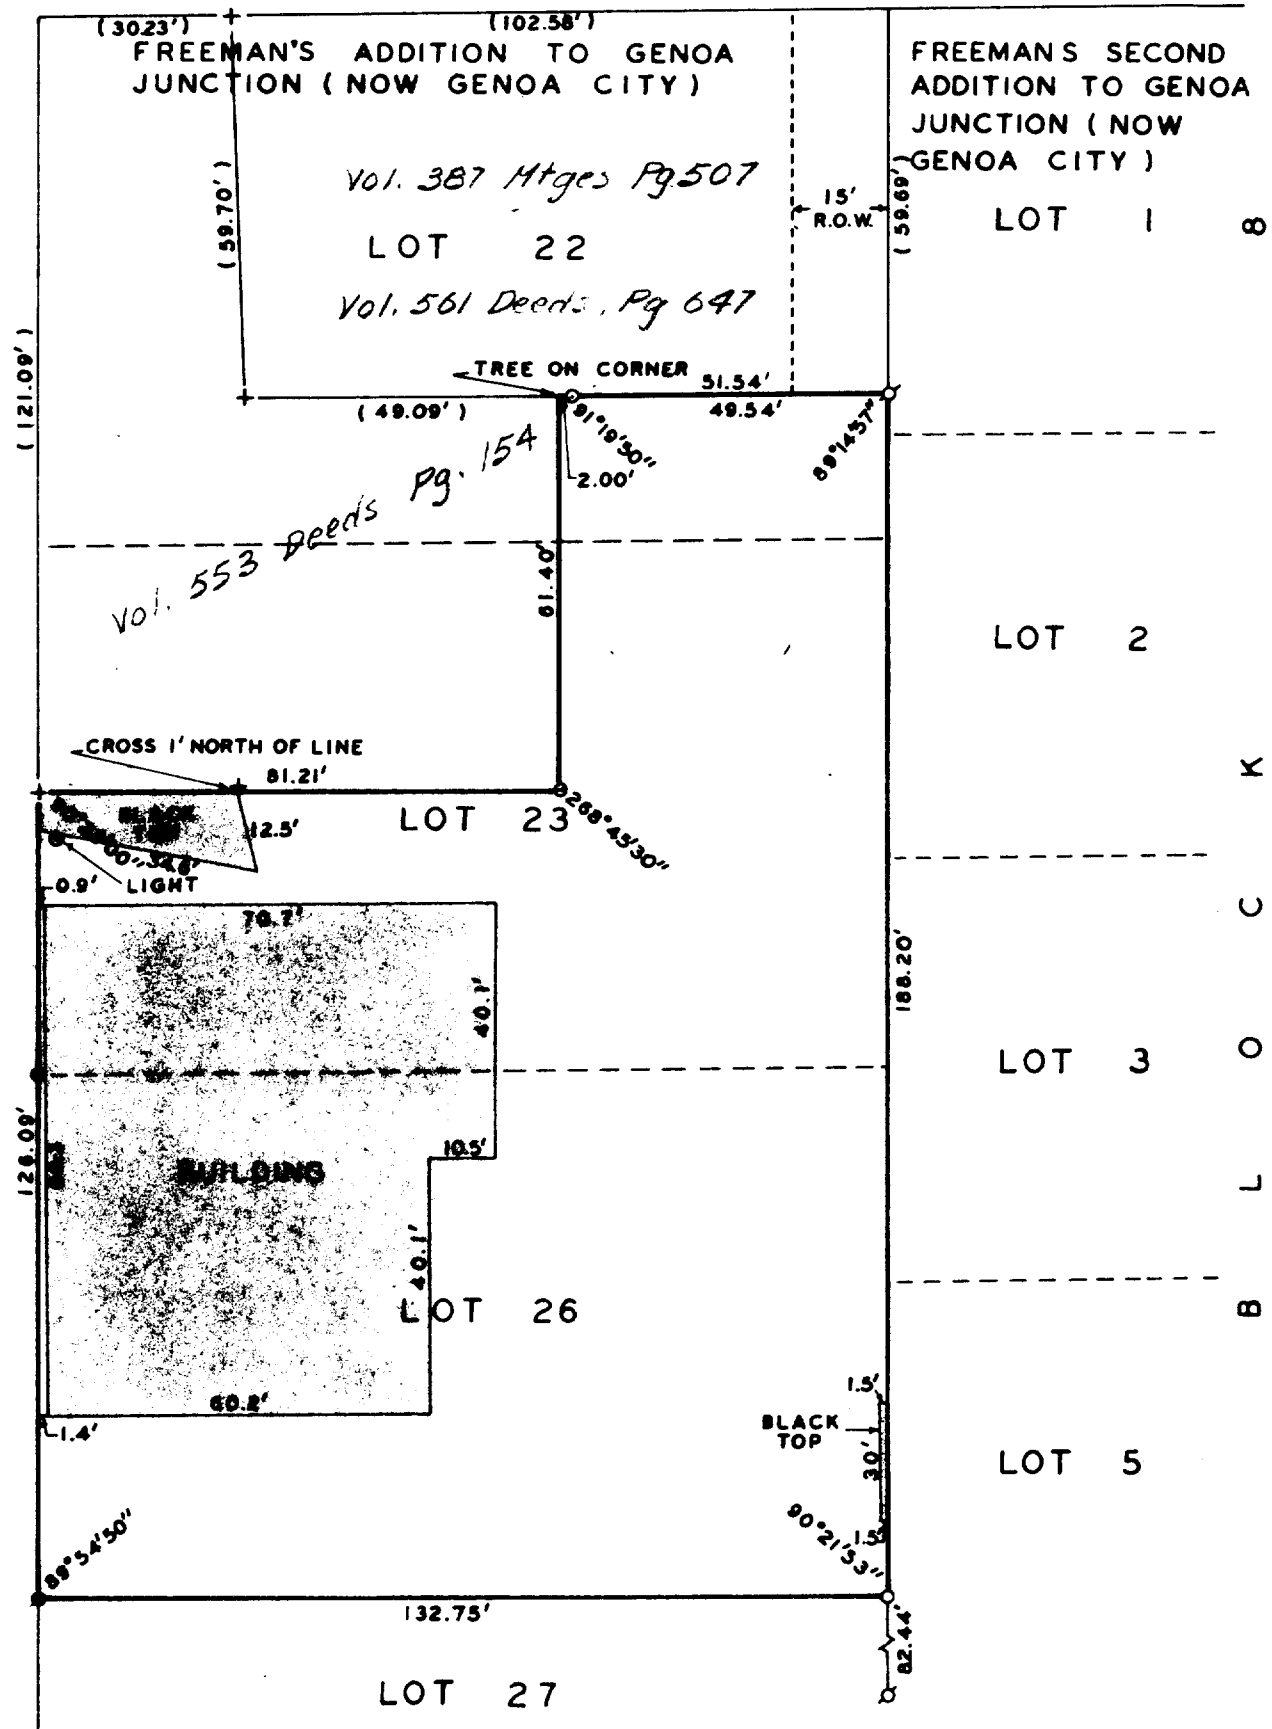

PLAT OF SURVEY OF

PART OF LOTS 22, 23, AND LOT 26 OF FREEMAN'S ADDITION TO GENOA JUNCTION (NOW GENOA CITY), WALWORTH COUNTY, WISCONSIN.

ORDERED BY: JOHN O. OLSON
 401 BROAD STREET
 LAKE GENEVA, WI. 53417

N



SCALE 1"=30'

LEGEND

- φ — IRON PIPE FOUND
- — IRON PIPE PLACED
- — CONCRETE MONUMENT
- x — SPIKE
- + — CUT CROSS FOUND
- ⊙ — BRASS PLUG IN CONC.
- ⊖ — IRON ROD FOUND
- () — AS PLATTED



I, HAROLD H. KOLB, DO HEREBY CERTIFY THAT I HAVE SURVEYED THE PROPERTY HEREON DESCRIBED ACCORDING TO THE OFFICIAL RECORDS, AND THAT THE PLAT HEREON IS A CORRECT REPRESENTATION OF THE LOT LINES.

Harold H. Kolb

HAROLD H. KOLB
 WISCONSIN REGISTERED LAND SURVEYOR, S-187

DATE JUNE 23, 1975

TFP-19 + TFP-25