


PLAT OF SURVEY OF PART OF LOTS 3 & 4 OF BLOCK 5 OF J. H. ROWE'S ADDITION, VILLAGE OF GENOA CITY,
WALWORTH COUNTY, WISCONSIN

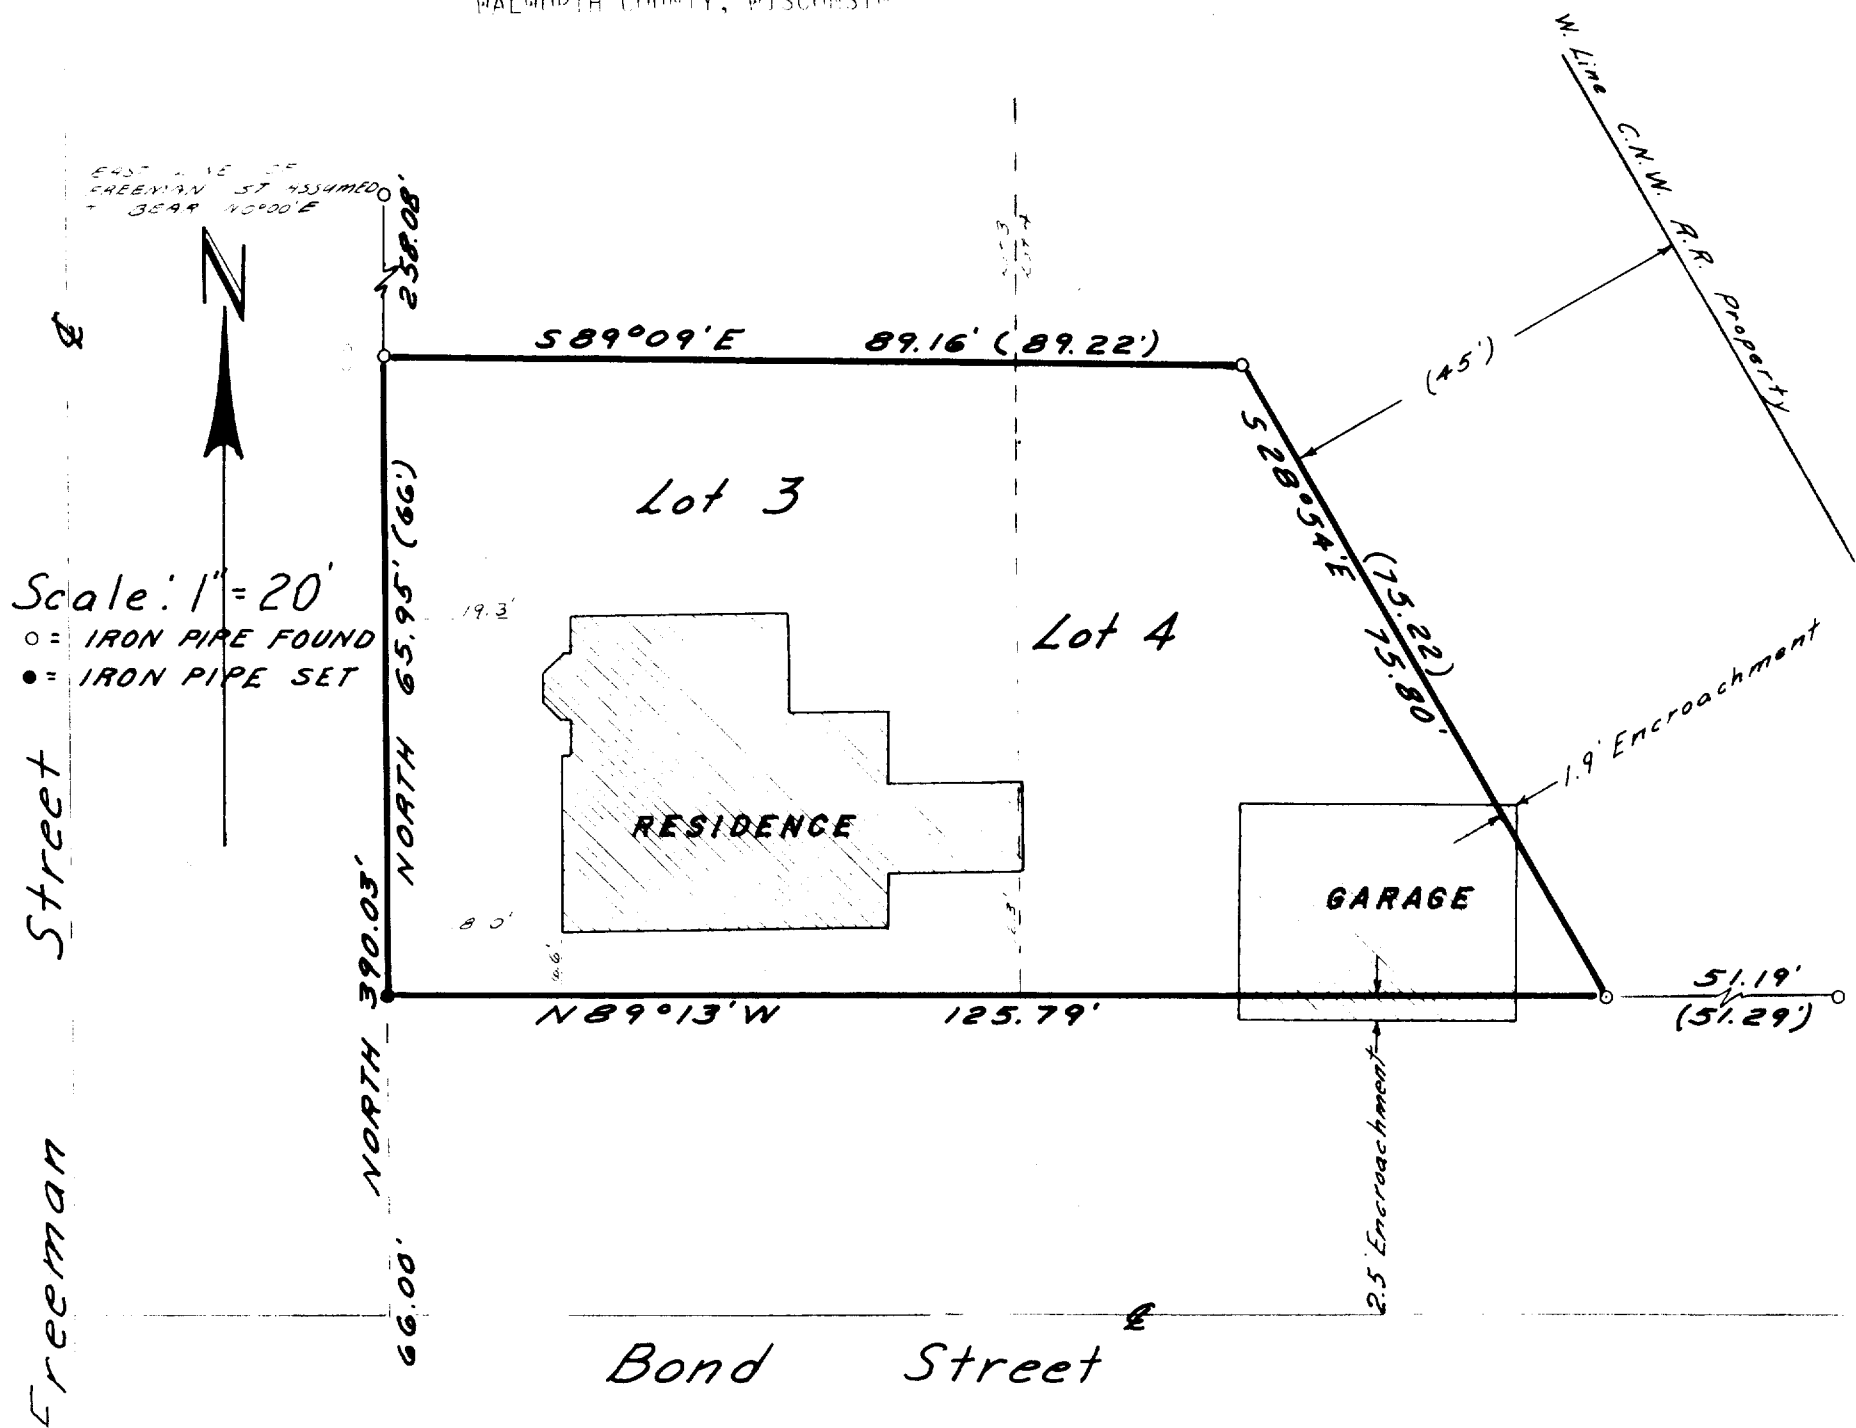

Legal description of land surveyed: Lots 3 & 4 of Block 5 of J.H. Rowe's Addition to the Village of Genoa City, (formerly Genoa Junction), excepting therefrom the following described real estate: Beginning at the Northwest corner of said Lot 3; thence South on the West line of said Lot 3 a distance of 66 feet to an iron pipe in said West line of said Lot 3; thence S 89° 09' E 89.22 feet to an iron pipe located 45 feet from the west line of the Chicago and Northwestern Railroad property; thence S 28° 54' E parallel to and 45 feet from said West line of the railroad property 75.80 feet to an iron pipe in the South line of said Lot 4; thence Easterly on the South line of said Lot 4 to the West line of said railroad property; thence Northwesterly along said West line of the railroad property to the South line of Lot 2; thence Westerly on the South line of said Lot 2 to the Northwest corner of Said Lot 3 and the point of beginning.

Note: Dimensions shown hereon in () are shown on a Plat of Survey of the remainder of Block 5 Dated October 17, 1964. Said survey is on file in the Walworth County Surveyors Office.

I HEREBY CERTIFY that I have surveyed the property hereon described and that this Plat of Survey is a true and accurate representation of the Lot lines and of the buildings located thereon to the best of my professional knowledge and belief.

Dated this 6th Day of October 1978

Robert A. Farris PLS



Work Ordered by: Joan Ecklund
520 Freeman St.
Genoa City, Wisconsin

This Work Prepared by:
FARRIS, HANSEN & COOPER, INC.
Engineering, Surveying and Land Planning
715 W. Walworth St. P.O. Box 487
Elkhorn, Wisconsin 53121