


KOLB LAND CONSULTING, INC.

LAKE GENEVA, WISCONSIN

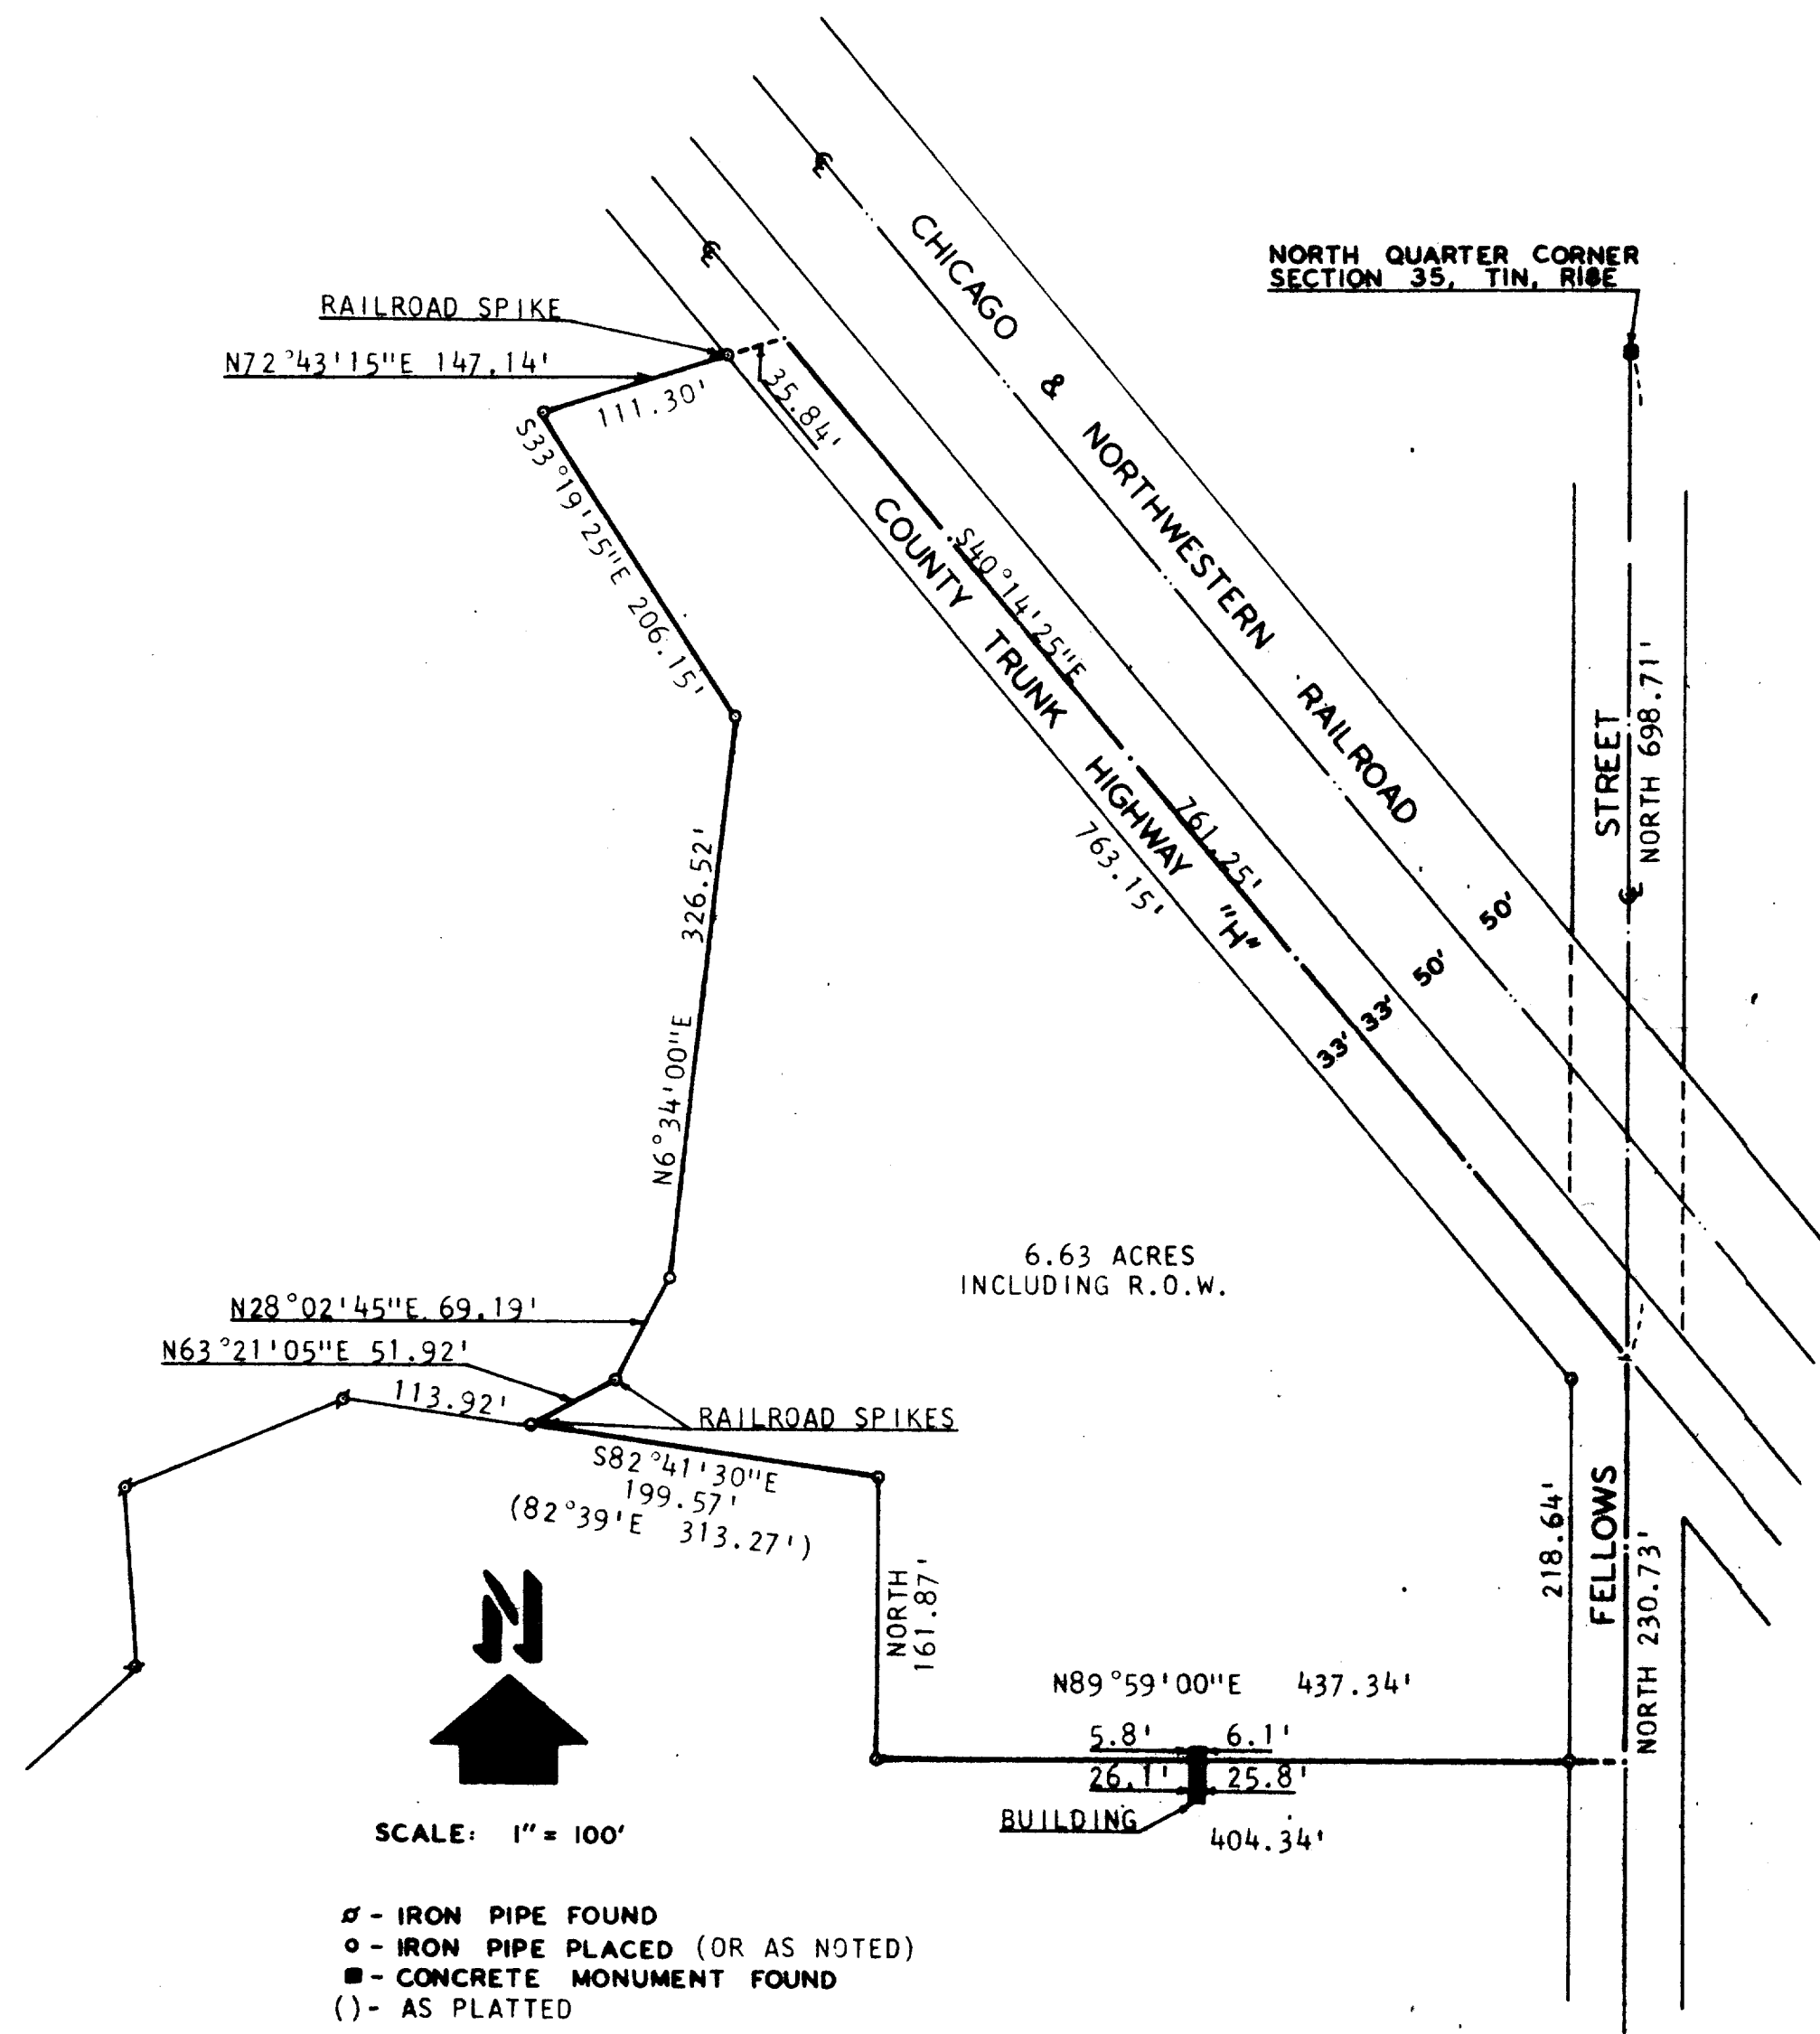


PLAT OF SURVEY OF

A PARCEL OF LAND LOCATED IN THE NORTHWEST $\frac{1}{4}$ OF SECTION 35, T 1 N, R 18 E, VILLAGE OF GENOA CITY, WALWORTH COUNTY, WISCONSIN, AND DESCRIBED AS FOLLOWS: COMMENCING AT THE NORTH $\frac{1}{4}$ CORNER OF SAID SECTION 35, THENCE SOUTH 698.71 FEET TO THE PLACE OF BEGINNING; THENCE CONTINUE SOUTH 230.73 FEET; THENCE S89°59'00"W 437.34 FEET; THENCE NORTH 161.87 FEET; THENCE N82°41'30"W 199.57 FEET; THENCE N63°21'05"E 51.92 FEET; THENCE N28°02'45"E 69.19 FEET; THENCE N6°34'00"E 326.52 FEET; THENCE N33°19'25"W 206.15 FEET; THENCE N72°43'15"E 147.14 FEET; THENCE S40°14'25"E 761.25 FEET TO THE PLACE OF BEGINNING. CONTAINING 6.63 ACRES INCLUDING ROAD RIGHT-OF-WAY.

I, HAROLD H. KOLB, DO HEREBY CERTIFY THAT I HAVE SURVEYED THE PROPERTY HEREON DESCRIBED ACCORDING TO THE OFFICIAL RECORDS, AND THAT THE PLAT HEREON IS A CORRECT REPRESENTATION OF THE LOT LINES.

Harold H. Kolb
 HAROLD H. KOLB
 S-187
 LAKE GENEVA, WIS.
 WISCONSIN REGISTERED LAND SURVEYOR, S-187

DATE Dec. 21, 1978

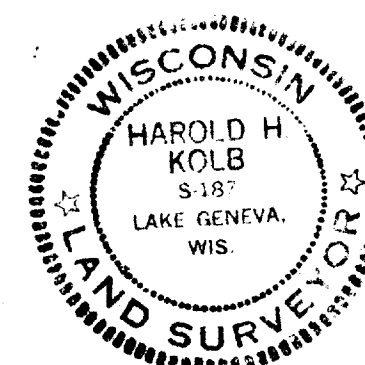

TUGC-413

TUGC-4 (part of)