
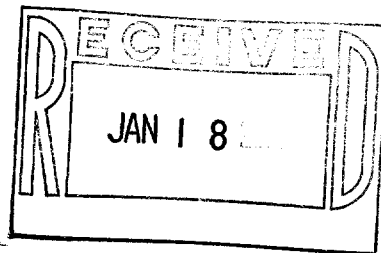


AMBIT LAND SURVEYING
P. O. BOX 42
Bassett, WI. 53101

PLAT OF SURVEY OF

PHONE 262-537-4874
FAX 262-537-4221

Lot 197 in HUNTERS RIDGE SUBDIVISION, located in the Southwest Quarter of Section 25, Town 1 North, Range 18 East of the 4th Principal Meridian, according to the recorded plat thereof. Said land being in the Village of Genoa City, Walworth County, Wisconsin.

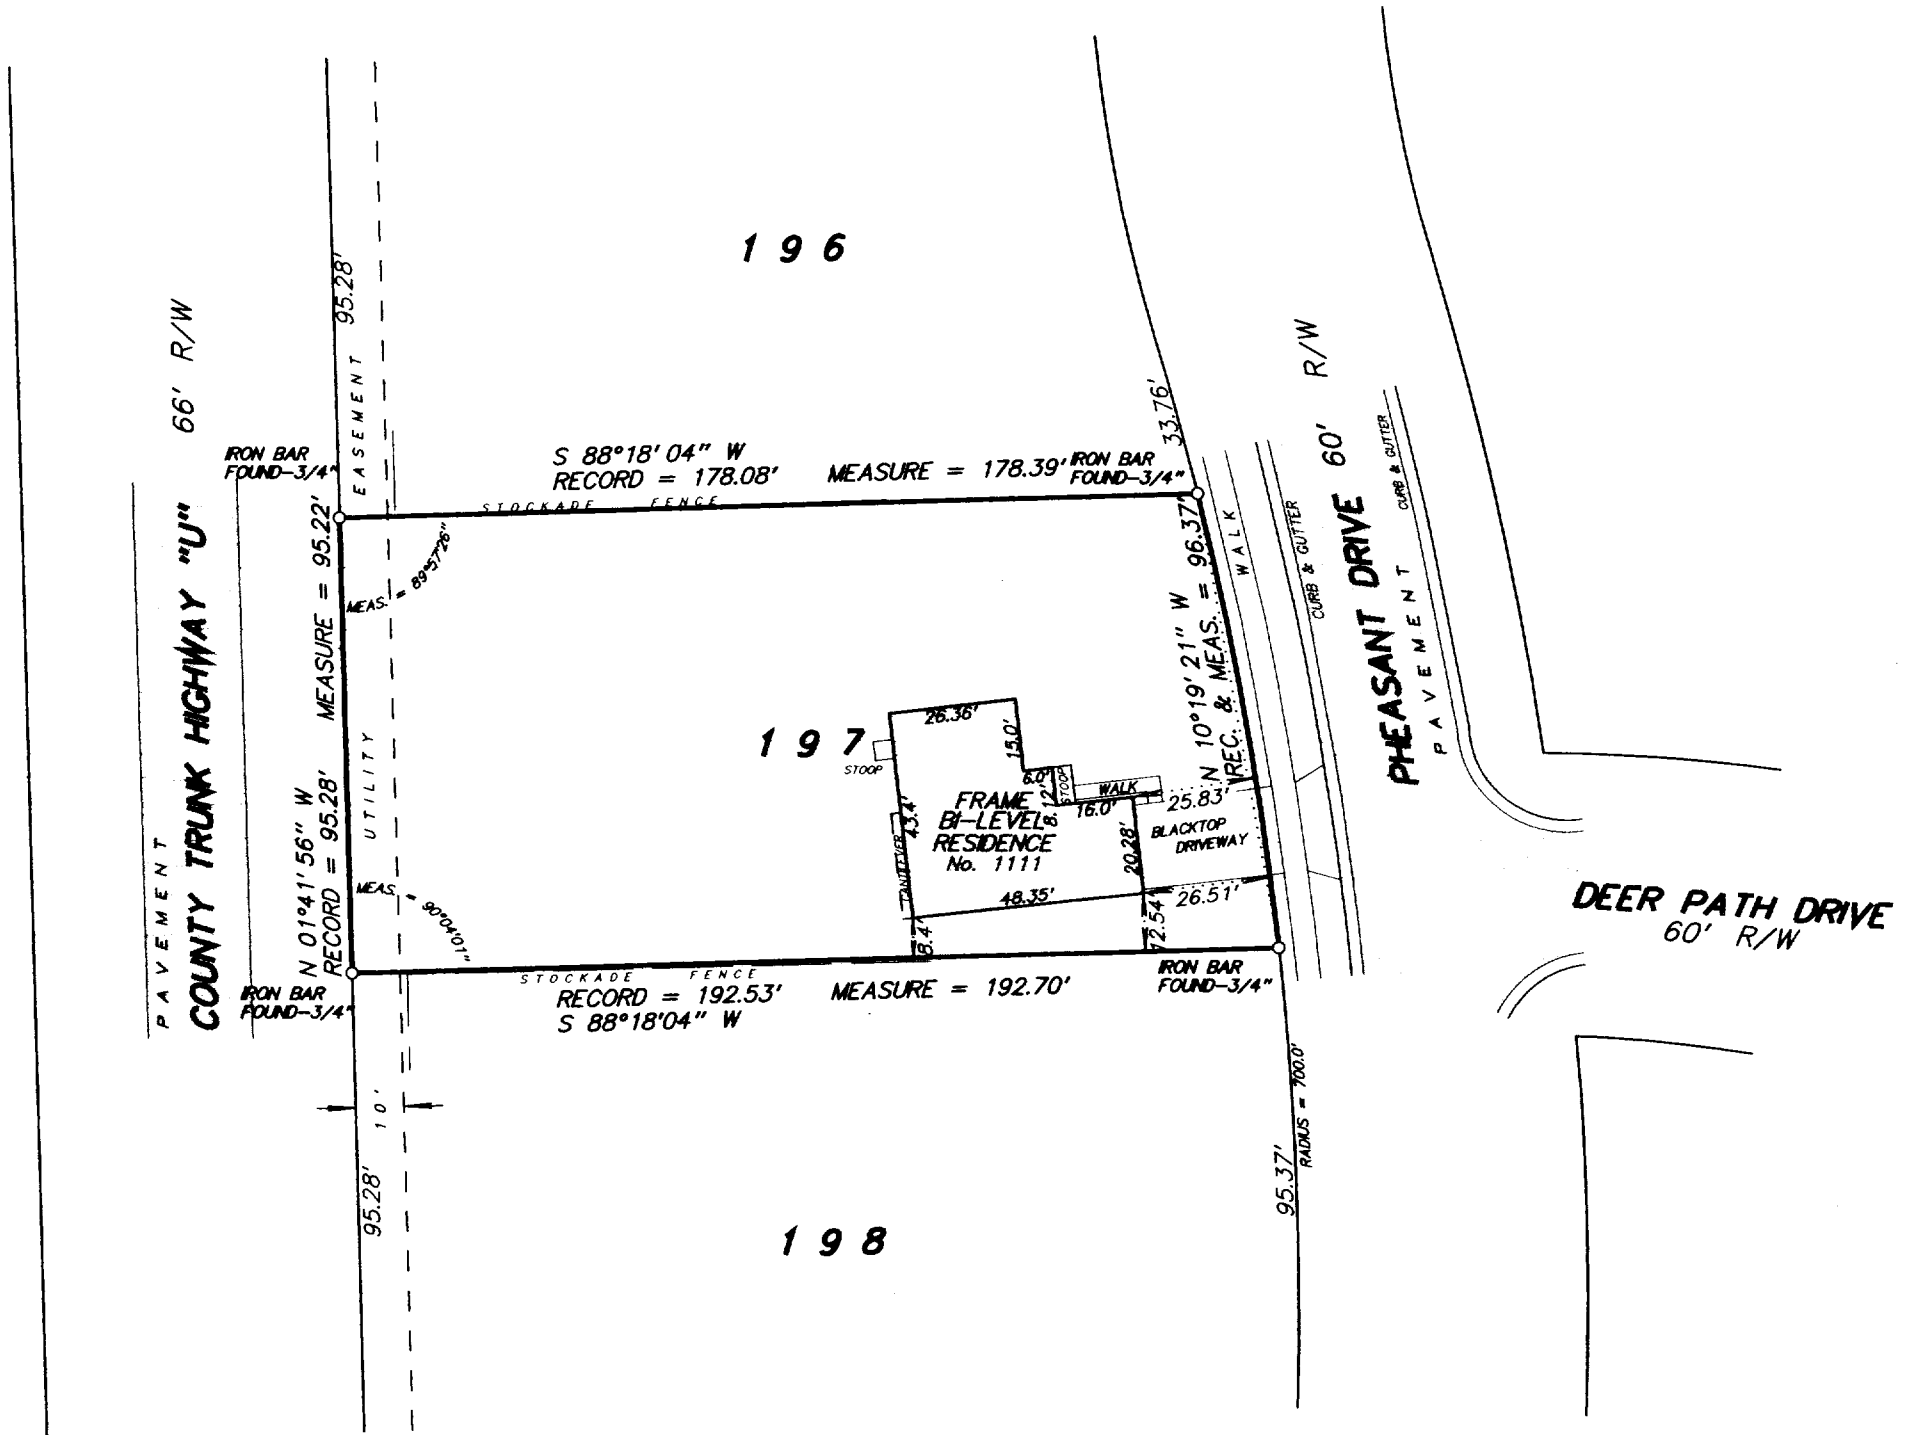

I hereby certify that I have surveyed the above described property and the above plat is a true representation thereof and shows the size and location of the property, its exterior boundaries, the location and dimensions of all visible structures thereon, boundary fences, apparent easements and roadways and visible encroachments, if any.

This survey is made for the exclusive use of the present owners of the property, and also those who purchase, mortgage, or guarantee the title thereto within one year from the date hereof.

Dated at Bassett, Wisconsin this _____ day of _____ 2004.

Mark A. Bolender
Wisconsin Registered Land Surveyor S - 1784

SCALE 1 inch = 40 feet

ORDERED BY M. Gantar / Gantar & DeMartini, LTD.
Attorney's at Law

JOB NO. 04287