


PLAT OF SURVEY

-OF-

A PARCEL OF LAND LOCATED IN THE VILLAGE OF GENOA CITY, IN THE SOUTHEAST QUARTER OF SECTION 35, TOWN 1 NORTH, RANGE 18 EAST OF THE FOURTH PRINCIPAL MERIDIAN, WALWORTH COUNTY, WISCONSIN, DESCRIBED AS FOLLOWS. TO-WIT: COMMENCING AT THE SOUTHEAST CORNER OF ZARNSTORFF'S ADDITION, ACCORDING TO THE PLAT THEREOF ON RECORD IN THE OFFICE OF THE REGISTER OF DEEDS IN AND FOR WALWORTH COUNTY, WISCONSIN: THENCE SOUTH 205 FEET TO THE PLACE OF BEGINNING: THENCE CONTINUING SOUTH 180 FEET TO THE PIPE: THENCE WEST 95 FEET TO A PIPE: THENCE NORTH 180 FEET TO A PIPE; THENCE EAST TO THE PLACE OF BEGINNING, ALL IN THE VILLAGE OF GENOA CITY, WALWORTH COUNTY, WISCONSIN.

SURVEY FOR: Remax Southern Lakes/Mike

SE CORNER OF
ZARNSTORFF'S ADDITION

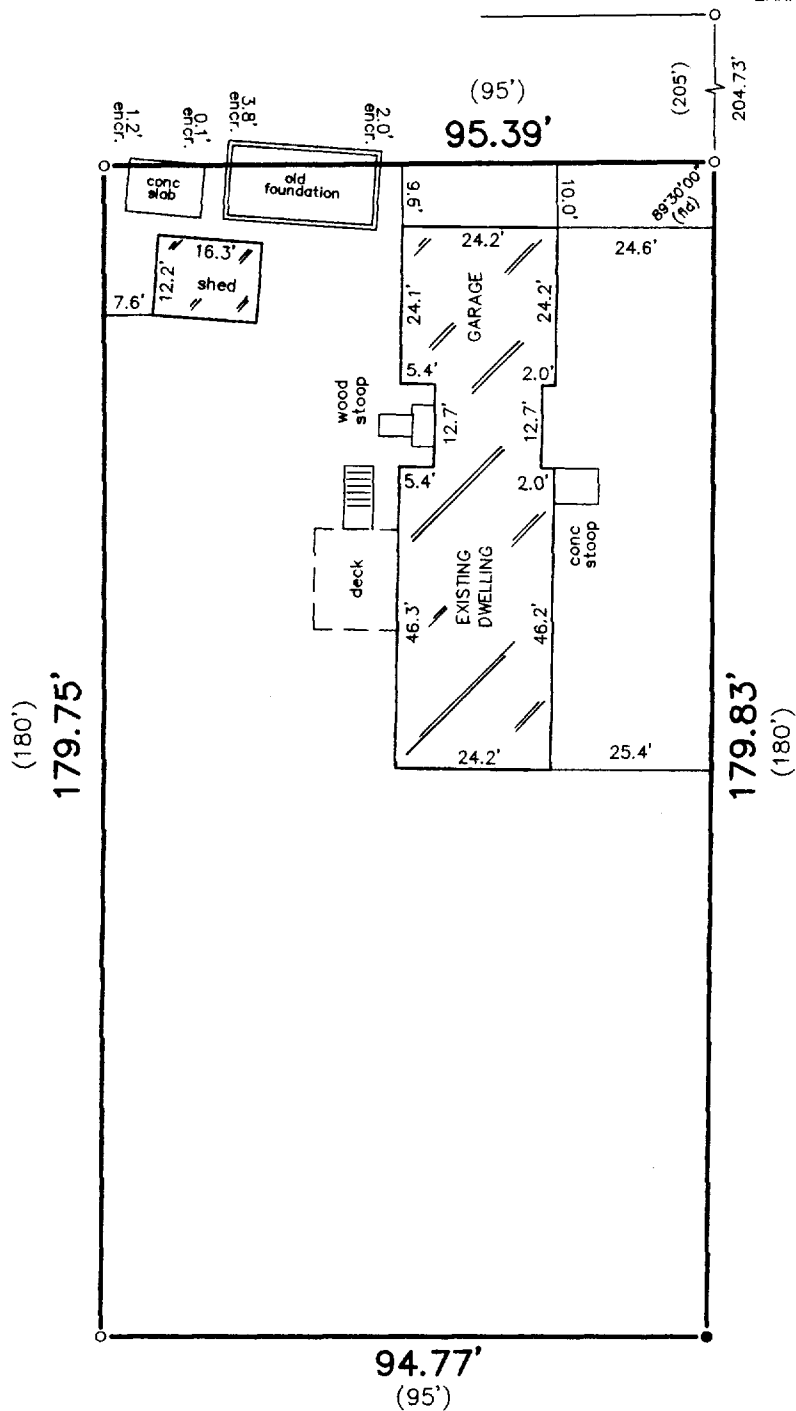

STREET

66' WIDE


GROVE

SCALE 1" = 30'

- FOUND IRON PIPE
- SET IRON PIPE
- () RECORDED AS

"I hereby certify that I have surveyed the above described property and that the above map is a correct representation thereof and shows the size and location of the property, its exterior boundaries, the location of all visible structures and dimensions of all principal buildings thereon, boundary fences, apparent easements, roadways and encroachments, if any."

"This survey is made for the use of the present owners of the property, and those who purchase, mortgage, or guarantee the title thereto within one year from date hereof."

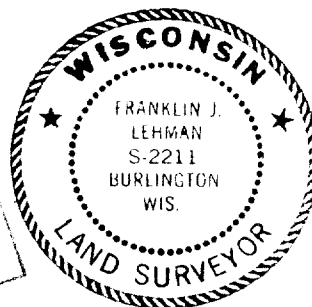

THIS IS NOT AN ORIGINAL PRINT
UNLESS THIS SEAL IS RED.

B.W. SURVEYING, INC.

412 N. PINE STREET
BURLINGTON, WI 53105
(262)-767-0225

Franklin J. Lehman
FRANKLIN J. LEHMAN S-2211

JUNE 17, 2005
DATE

6897
JOB NUMBER



006-1217