

PLAT OF SURVEY -OF-


LOT 117 IN HUNTERS RIDGE SUBDIVISION, LOCATED IN THE SOUTHWEST 1/4 OF SECTION 25, TOWN 1 NORTH, RANGE 18 EAST, VILLAGE OF GENOA CITY, WALWORTH COUNTY, WISCONSIN.

SURVEY FOR: MICHAEL MUSTELL

SURVEY LOCATION: 274 HIGHLAND AVENUE


JUL 10 2006

8MF

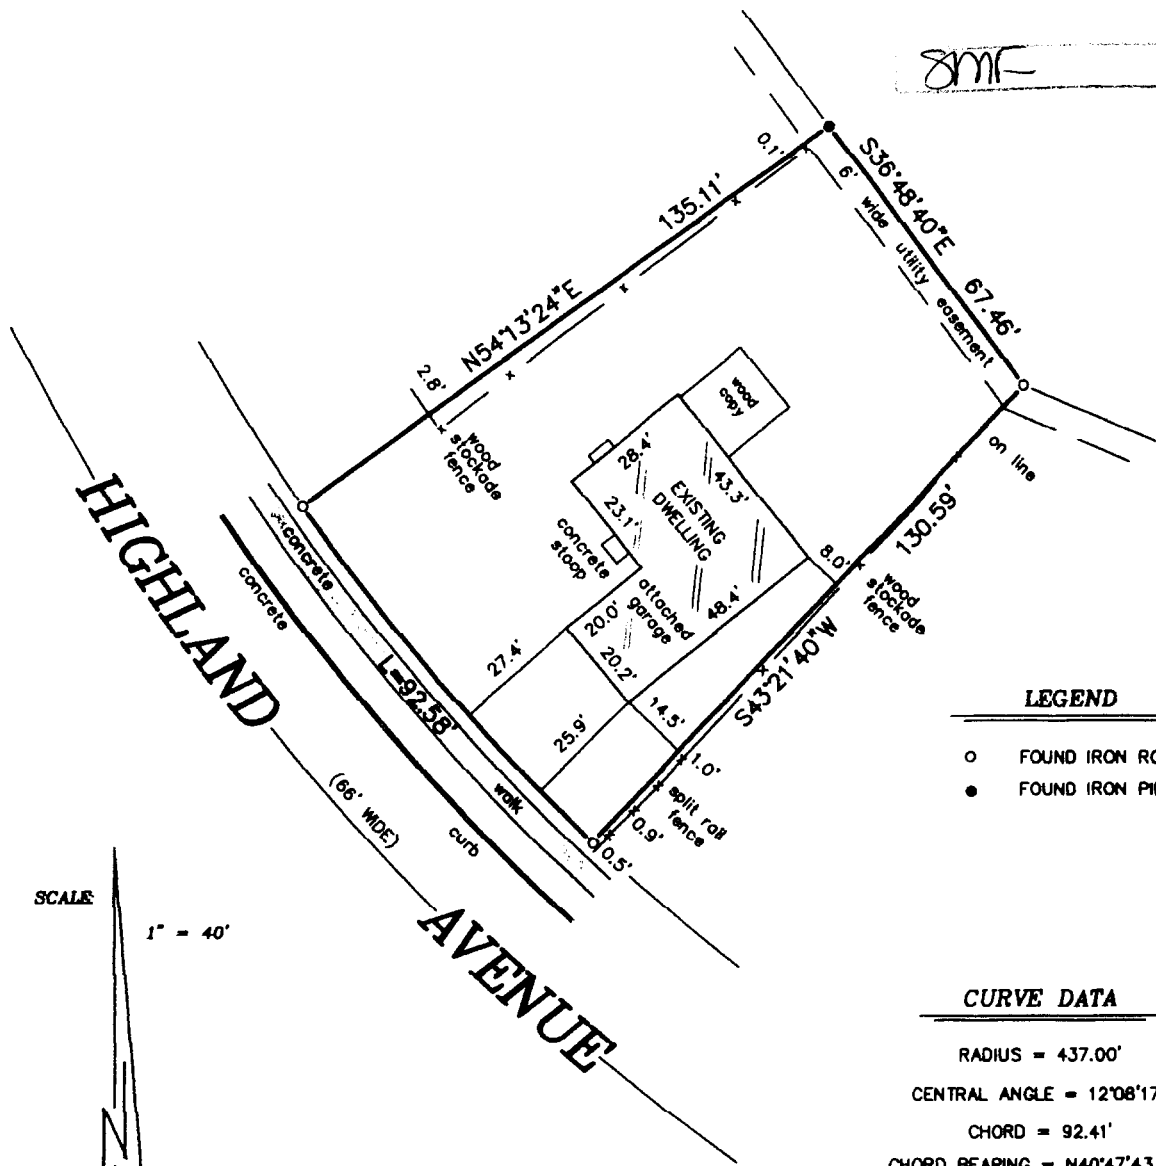

"I hereby certify that I have surveyed the above described property and that the above map is a correct representation thereof and shows the size and location of the property, its exterior boundaries, the location of all visible structures and dimensions of all principal buildings thereon, boundary fences, apparent easements, roadways and encroachments, if any."

"This survey is made for the use of the present owners of the property, and those who purchase, mortgage, or guarantee the title thereto within one year from date hereof."

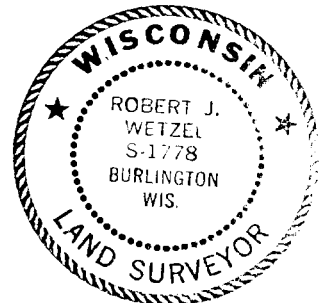

THIS IS NOT AN ORIGINAL PRINT
UNLESS THIS SEAL IS RED.

B.W. SURVEYING, INC.

412 N. PINE STREET
BURLINGTON, WI 53105
(262)-767-0225

Robert J. Wetzel
ROBERT J. WETZEL S-1778

APRIL 7, 2006
DATE

7233

DATE

JOB NUMBER

006-1230



THR-117