


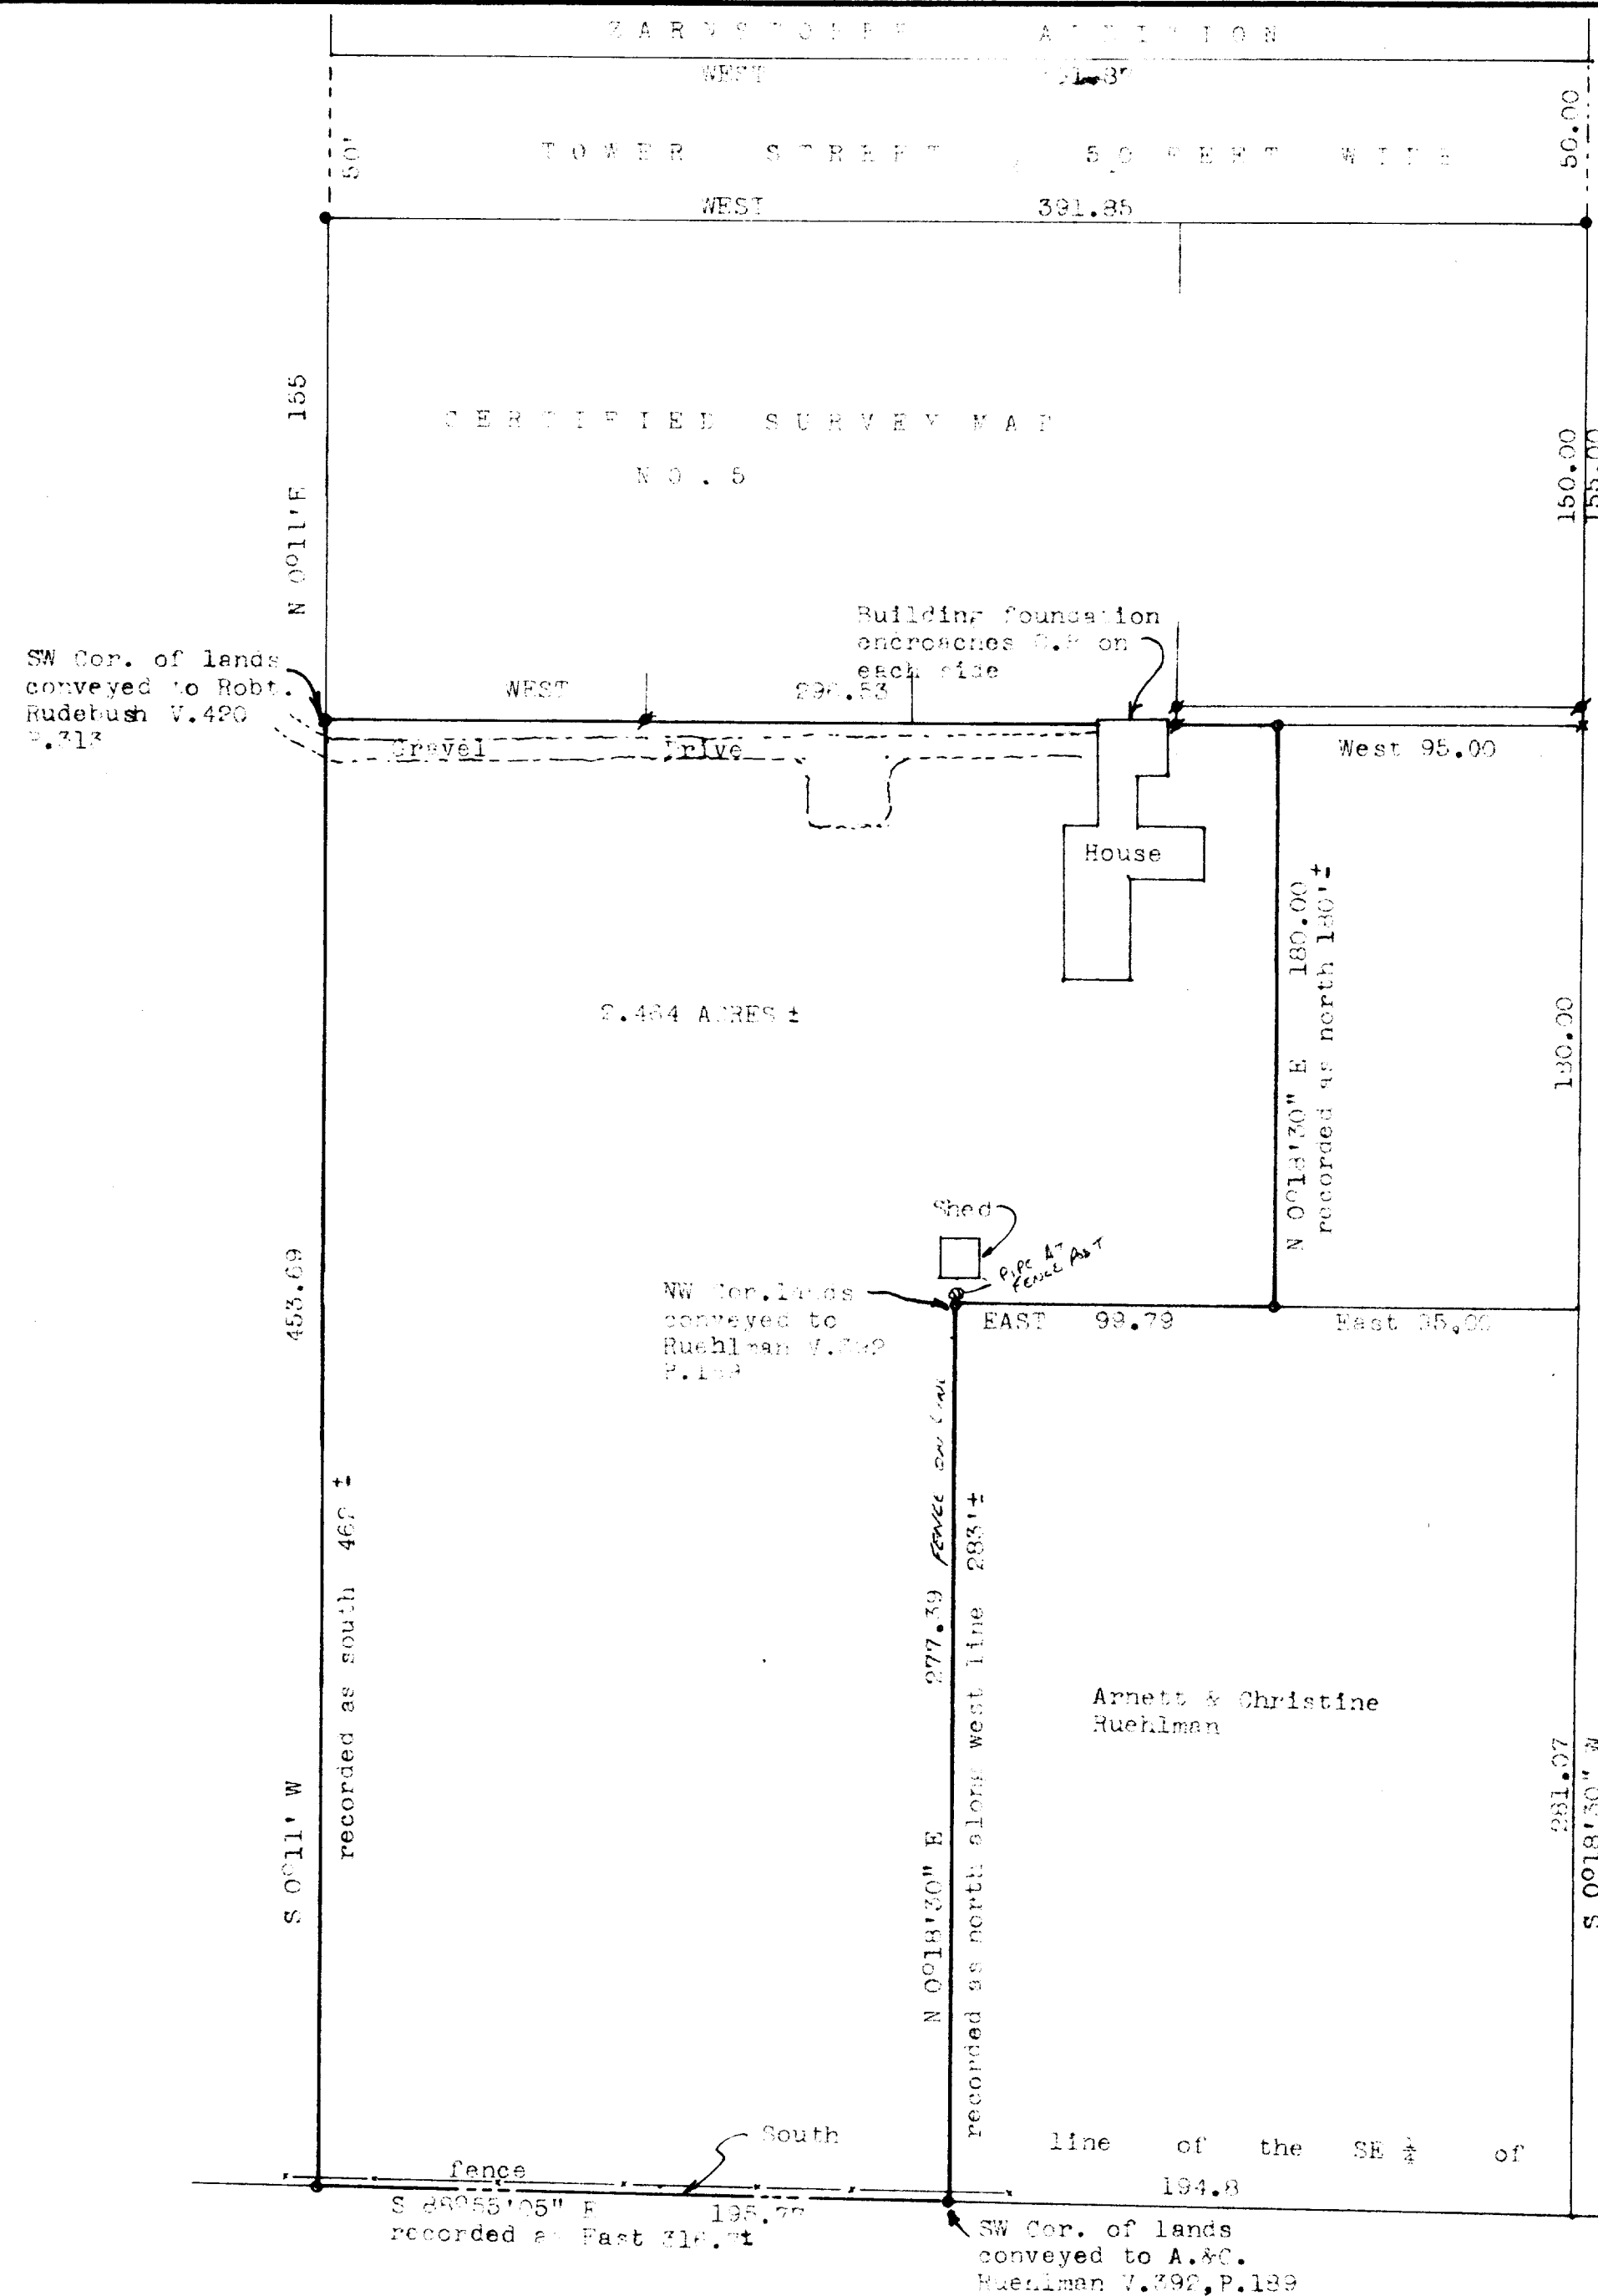


SE Corner of
Zarnstorff Addition

PLAT OF SURVEY AND HOUSE LOCATION
For
CENTURY 21
OF

Parcel 1:

Beginning at the SE corner of Zarnstorff's Addition, according to a plat thereof on record in the office of the Register of Deeds in and for Walworth County, Wisconsin, thence S 205 feet; thence W 95 feet to a pipe and the place of beginning of this description; thence continuing W to the SW corner of the lands conveyed to Robert R. Rudebusch and Marcella Rudebusch, his wife, by deed dated October 10, 1950 and recorded October 13, 1950 in Volume 420 of Deeds on page 313; thence S 462 feet more or less to the SW corner of the Zarnstorff land; thence E on the Southern Boundary of the Zarnstorff land 318.7 feet more or less to the SW corner of the lands conveyed to Arnett Ruehlman and Christine Ruehlman, his wife, by deed dated November 13, 1948 and recorded November 16, 1948 in Volume 392 of Deeds on page 189; thence N on the Western Boundary line of the Ruehlman property 283 feet to the NW corner thereof; thence E on the Ruehlman Northern Boundary line to a point 95 feet W of the Eastern boundary line of the Ruehlman property; thence N 180 feet, more or less to the place of beginning, all in the Village of Genoa City, Walworth County, Wisconsin.

Bearings are based on the
plat of Zarnstorff Addition
to the Village of Genoa City
West line of Grove Avenue
S 0°18'30" W.

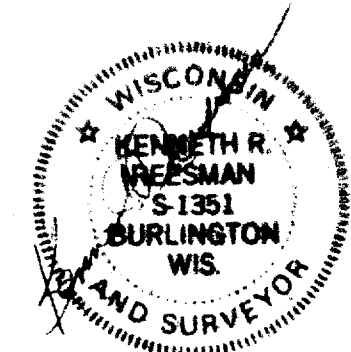

- * LEGEND *
- Found 2" Iron Pipe
 - Found 1-5/8" Iron Pipe
 - Set 1" Iron Pipe

"I have surveyed the above-described property, and the above map is a true representation thereof and shows the size and location of the property, its exterior boundaries, the location and dimensions of all visible structures thereon, fences, apparent easements and roadways and visible encroachments, if any.

This survey is made for the exclusive use of the present owner of the property, and also those who purchase, mortgage, or otherwise acquire the title thereto, within one year from date hereof.

Dated at Wauwatosa, this 22 day
of SEPTEMBER, 19 78.

Kenneth R. Reesman
Surveyor

PLAT OF SURVEY AND HOUSE LOCATION for CENTURY 21 of		
Part of the Southeast 1/4 of Section 35, T1N., R18E Village of Genoa City, Walworth County, Wisconsin		
DATE 9-28-78	ROBES & BOYD, INC. CONSULTING ENGINEERS 109 S. SPRING ST. BURLINGTON, WIS. (414) 763-2652	JOB NO. 78239
SCALE 1" = 50'		CHECKED MS
DRAWN Krr		REVIEWED 1 1
REVISED		