

PANEL "A": DESCRIPTION - LOT 12, BEING THE SOUTH HALF OF LOT 8, IN THE VILLAGE OF CHESA, A PLAT OF RECORD, AND LOCATED IN THE VILLAGE OF CHESA, WISCONSIN.

PANEL "B": DESCRIPTION - THE SOUTH HALF OF LOT 8 AND PART OF THE NORTH HALF OF LOT 8 DESCRIBED AS FOLLOWS: BEGINNING AT THE SOUTHWEST CORNER OF THE NORTH HALF OF LOT 8, THENCE WEST 87 FEET; THENCE NORTH 25 FEET; THENCE EAST 87 FEET TO EAST LINE OF LOT 8; THENCE SOUTH 25 FEET TO PLACE OF BEGINNING. ALL BEING PART OF THE PLAT OF VILLAGE OF CHESA, LOCATED IN THE VILLAGE OF CHESA CITY, WAUSAU COUNTY, WISCONSIN.

FOR: ROBERT PATON AND THE VILLAGE OF CHESA CITY.

SCALE 1" = 30'

o - IRON PIPE STAKE SET

Δ - IRON PIPE STAKE FOUND

• - CONCRETE MONUMENT FOUND.


X - RAILROAD SPIKE SET OVER TIPPED CONCRETE MONUMENT FOUND.

I have surveyed the above-described property, and the map hereon is a true representation thereof and shows the size and location of the property, its exterior boundaries, the location and dimensions of all visible structures thereon, fences, apparent easements and roadways and visible encroachments, if any.


This survey is made for the exclusive use of the present owners of the property, and also those who purchase, mortgage, or guarantee the title thereto, within one year from date hereof.

Dated at Burlington, this 4th day of November 1982

John F. Degen, Land Surveyor S 242

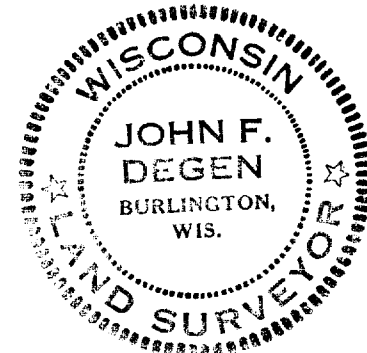

WALWORTH ST.

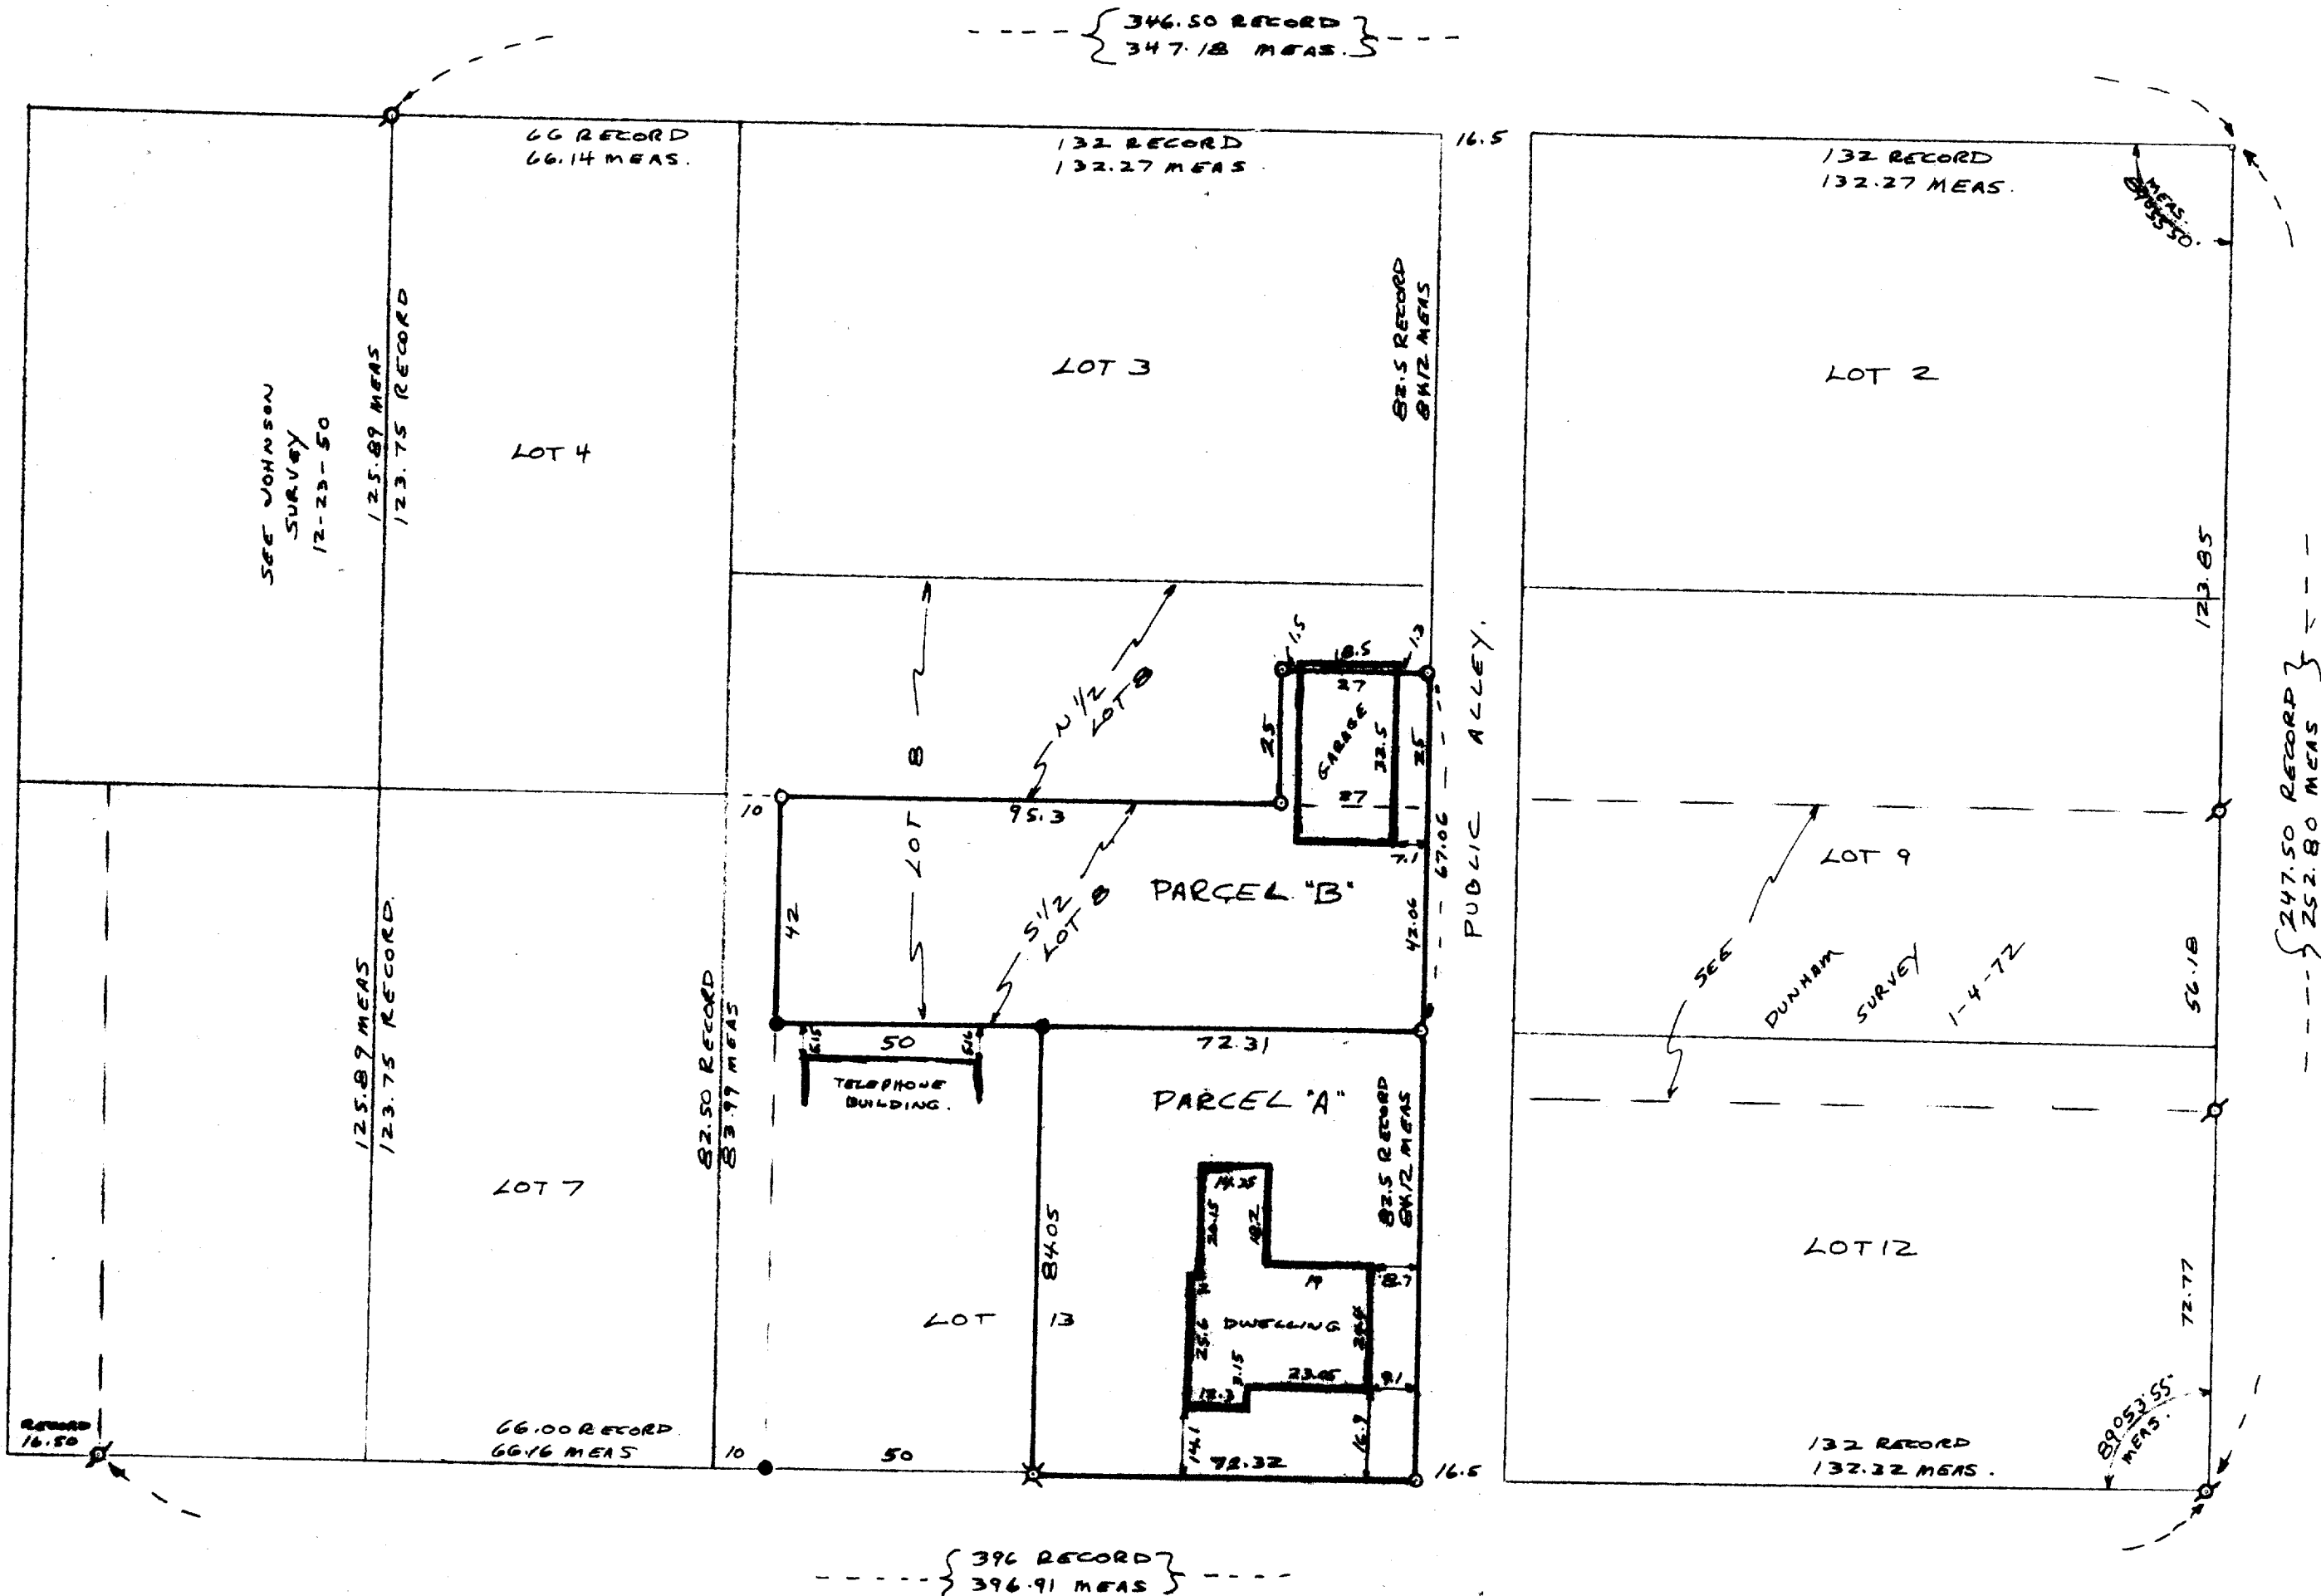

MAIN ST.