


PREPARED FOR
DEBBY MILLER
CENTURY 21 LARRY HODGES REALTY
143 MAIN ST. P.O. BOX 939
TWIN LAKES, WI 53181

PLAT OF SURVEY

- OF -

LOT 6 OF GENOA TRAILS SUBDIVISION LOCATED IN THE NORTHWEST 1/4
OF THE SOUTHWEST 1/4, SECTION 36, TOWN 1 NORTH, RANGE 18 EAST,
VILLAGE OF GENOA CITY, WALWORTH COUNTY, WISCONSIN.

PATHFINDER SURVEYING INC.
W2888 KRUEGER RD. UNIT "D"
LAKE GENEVA WI. 53147
(262) 248-3697

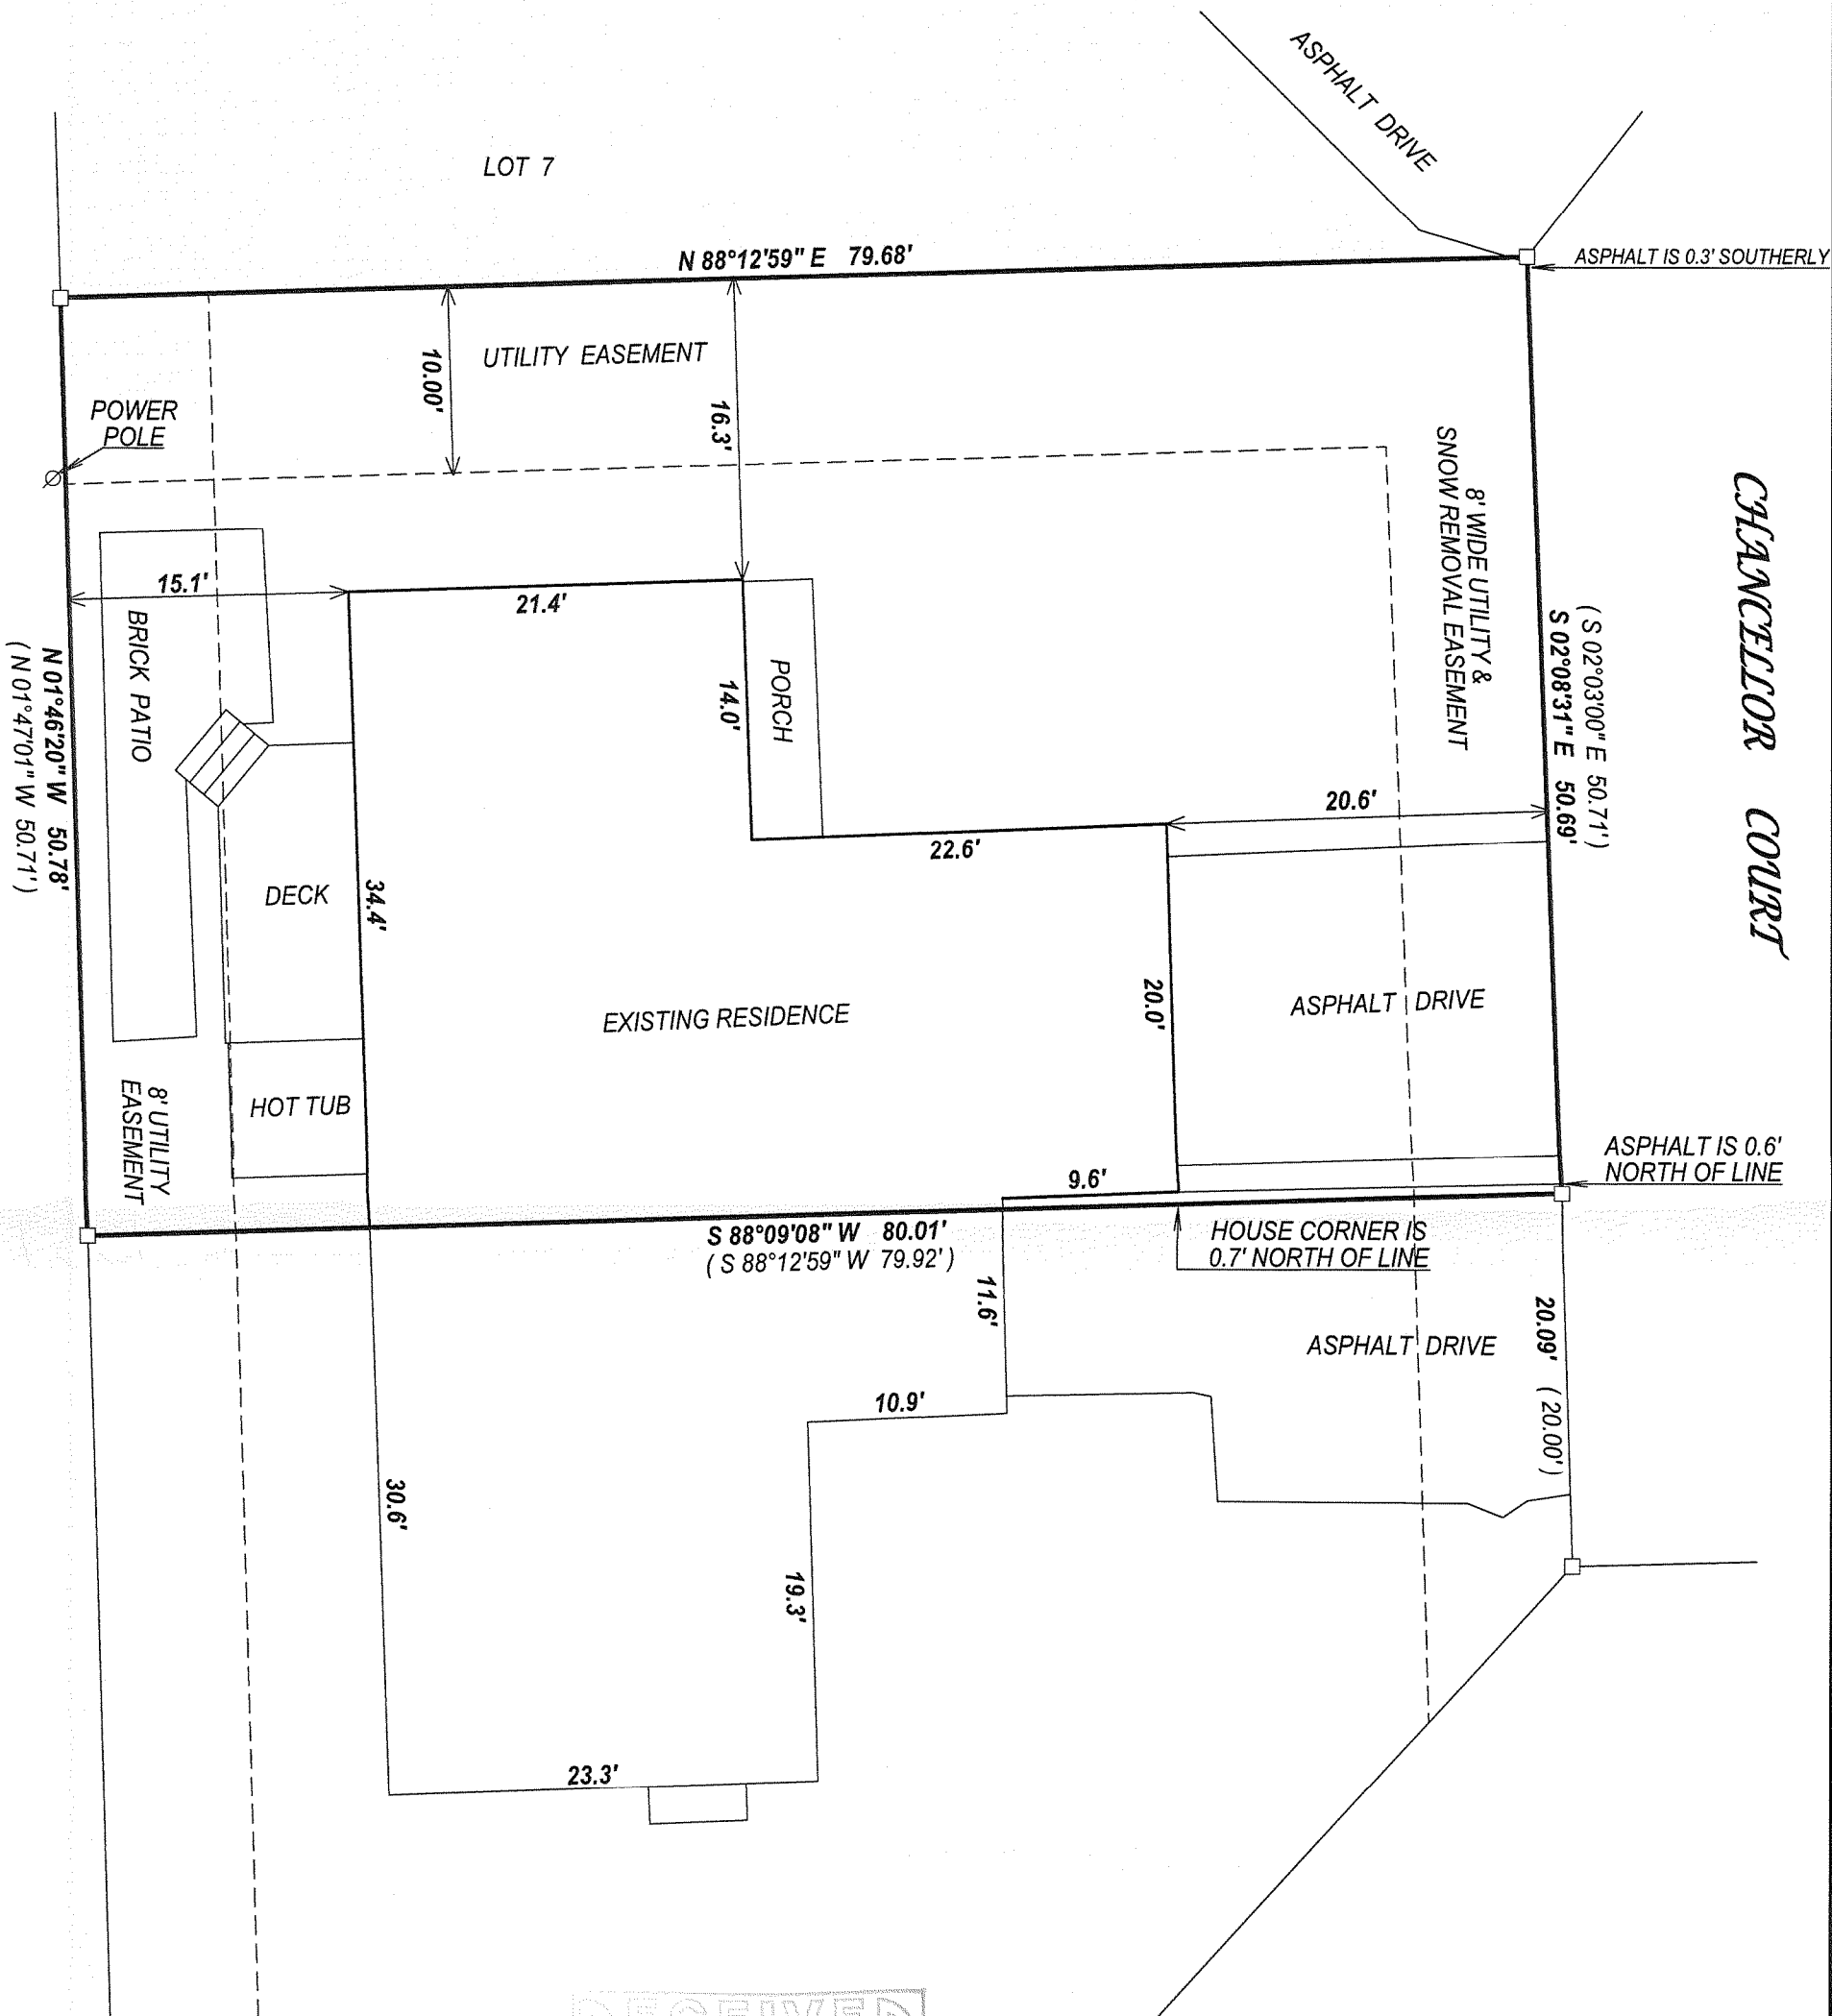

() = recorded as


□ = found iron bar

○ = found iron pipe

● = set iron pipe


■ = set iron bar

SCALE 1" = 10'

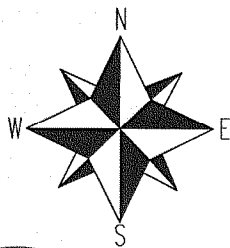

JOB # 07-249


TAX ID # TGT00006

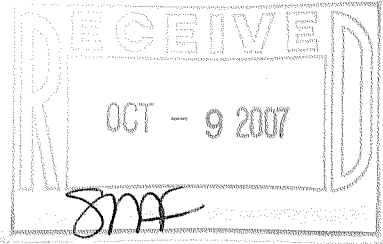

COMPARE LEGAL DESCRIPTION ABOVE AND DRAWING WITH DEED. FOR BUILDING RESTRICTIONS AND EASEMENTS NOT SHOWN REFER TO DEED, ABSTRACT SOURCES AND LOCAL MUNICIPAL CODES. NOTIFY THE SURVEYOR IMMEDIATELY OF ANY DISCREPANCY.

"I hereby certify that I have surveyed the above described property and that the above map, to the best of my knowledge and belief, is a true representation thereof and shows the size and location of all visible structures, apparent easements and encroachments if any."

This survey is made for the present owners of the property, and those who purchase, mortgage, or guarantee the title thereto, within one year from the date hereof.

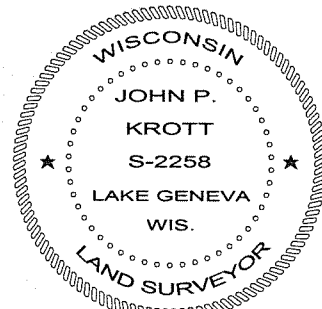

John P. Krott

JOHN KROTT S - 2258
Wisconsin Registered Land Surveyor
(original if signed in red)

DATED THIS THE 21st DAY OF JUNE 2007.

006-1257