

PREPARED FOR:
WILLIAM ANTTI
219 WALWORTH ST.
GENOA CITY, WI 53128

PLAT OF SURVEY

-OF-



KROTT SURVEYING INC.

N3705 WILLOW BEND LANE
LAKE GENEVA WI. 53147
PHONE # (262)248-3697
FAX # (262)249-0639

PART OF THE SOUTHWEST 1/4 OF THE SOUTHWEST 1/4 OF SECTION 36, TOWNSHIP 1 NORTH, RANGE 18 EAST DESCRIBED AS FOLLOWS: TO WIT: BEGINNIG AT A POINT ON THE SOUTH LINE OF THE HIGHWAY RUNNING EAST AND WEST ALONG THE NORTH SIDE OF THE SOUTHWEST 1/4 OF THE SOUTHWEST 1/4 OF SECTION 36, TOWNSHIP 1 NORTH, RANGE 18 EAST AT A POINT 533.94 FEET EAST OF THE SECTION LINE ; THENCE EAST ALONG THE SOUTH LINE OF SAID HIGHWAY 66 FEET; THENCE SOUTH 132 FEET; THENCE WEST 137.90 FEET ; THENCENORTH 132 FEET TO THE SOUTH LINE OF THE AFORESAID HIGHWAY; THENCE EAST 71.9 FEET TO THE PLACE OF BEGINNING.

ALSO: PART OF THE SOUTHWEST 1/4 OF THE SOUTHWEST 1/4 OF SECTION 36 TOWN 1 NORTH, RANGE 18 EAST, DESCRIBED AS BEGINNING AT A POINT ON THE SOUTHLINE OF THE HIGHWAY RUNNING EAST AND WEST ALONG THE NORTH SIDE OF THE SOUTHWEST 1/4 OF THE SOUTHWEST 1/4 OF SECTION 36, TOWN 1 NORTH, RANGE 18 EAST, AT A POINT 462.04 FEET EAST OF THE SECTION LINE, THENCE WEST 75 FEET, THENCE SOUTH 132 FEET; THENCE EAST 75 FEET; THENCE NORTH 132 FEET TO THE PLACE OF BEGINNING. ALL OF SAID LAND LYING AND BEING IN THE VILLAGE OF GENOA CITY, COUNTY OF WALWORTH, STATE OF WISCONSIN.

WALWORTH STREET
WIDTH VARIES

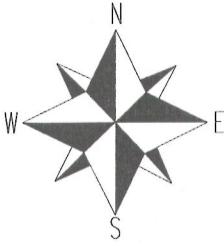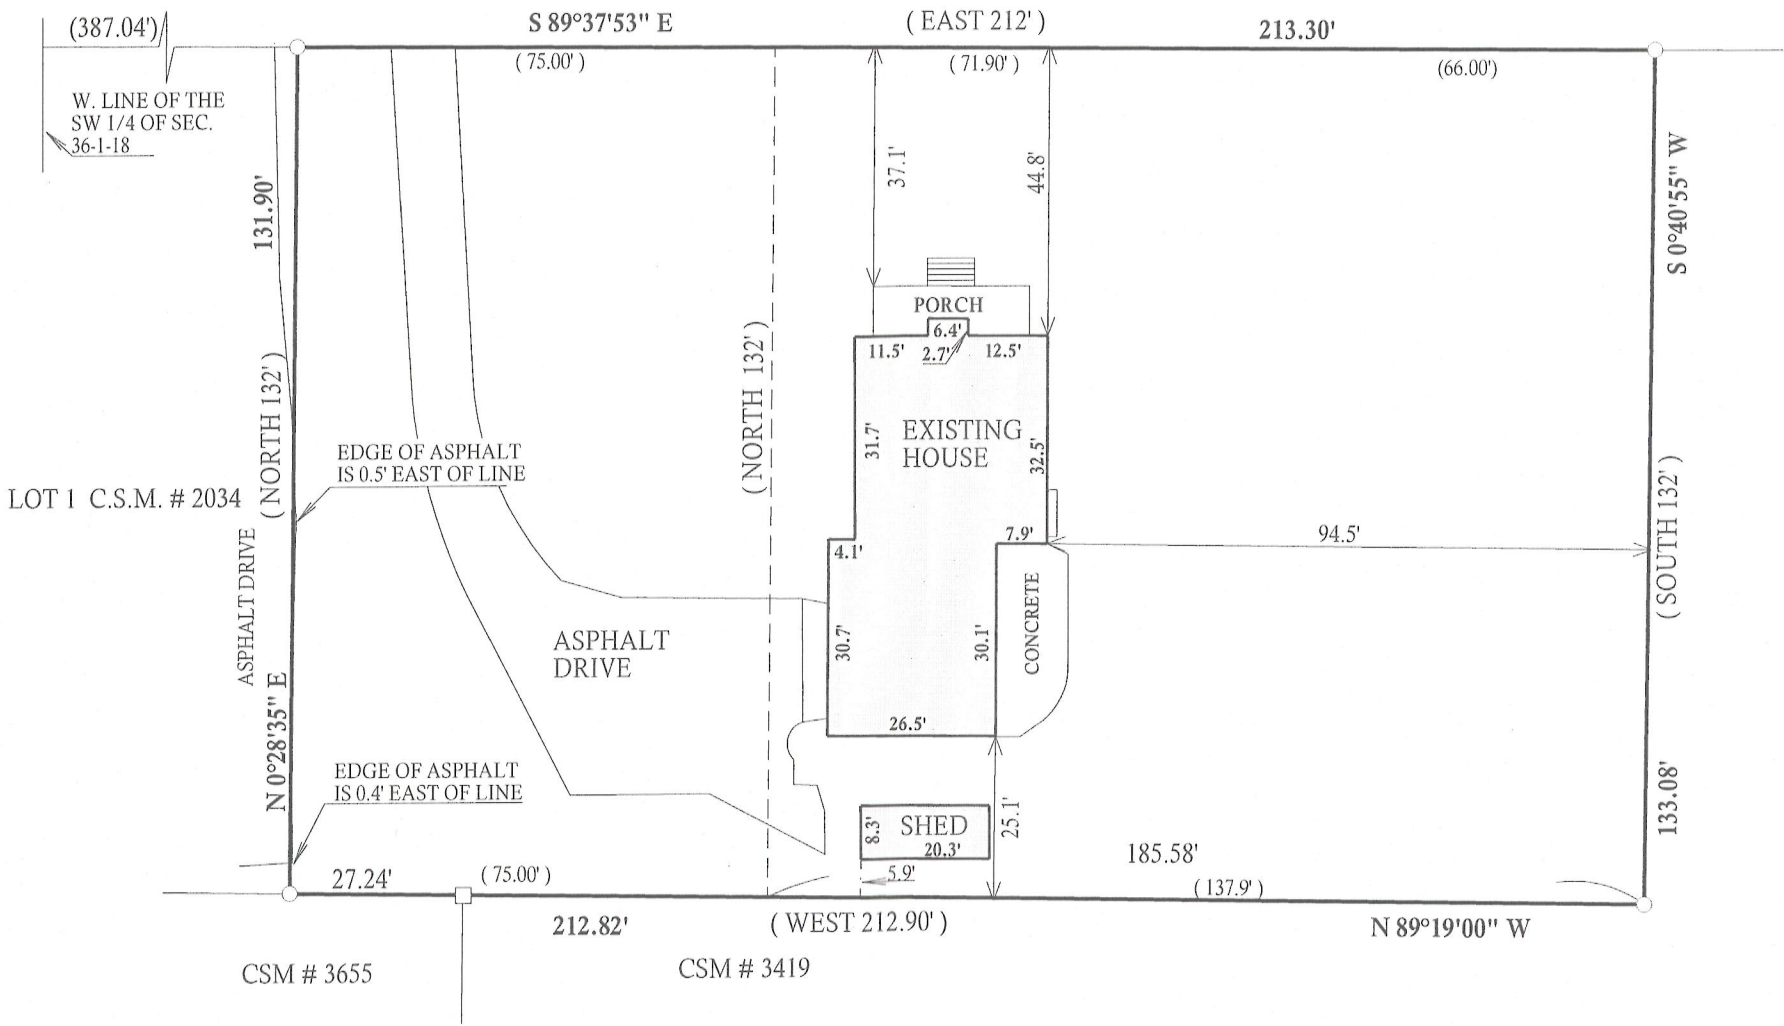

SCALE 1" = 30'

BEARINGS ARE REFERENCED TO CERTIFIED SURVEY MAP NO. 2034




LEGEND

- FOUND IRON PIPE
- FOUND IRON BAR

(xx) RECORDED AS
TAX ID# TVGC00090
JOB # 12-134

I have surveyed the above-described property and the above map is a true representation thereof and shows the size and location of the property, its exterior boundaries, the location and dimensions of all structures thereon, fences apparent easements and roadways and visible encroachments, if any.

This survey is made for the exclusive use of the present owners of the property, and also those who purchase, mortgage, or insure the title thereto within one (1) year from date hereof; and as to them I warrant the accuracy of said survey map.

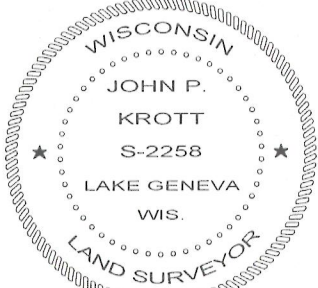

DATED THIS 11th, DAY OF OCTOBER, 2012

John P. Krott

JOHN KROTT S - 2258
Wisconsin Registered Land Surveyor
(original if signed in red)

006 - 1291