


PREPARED FOR
CHRISTINA GIVER
19 GROVE ST.
GENOA CITY WI. 53128


PLAT OF SURVEY OF

BEGINNING AT THE SOUTHEAST CORNER OF ZARNSTORFF'S ADDITION, ACCORDING TO A PLAT THEREOF ON RECORD IN THE OFFICE OF THE REGISTER OF DEEDS IN AND FOR WALWORTH COUNTY, STATE OF WISCONSIN; THENCE SOUTH 205 FEET TO THE PLACE OF BEGINNING; THENCE CONTINUING SOUTH 180 FEET TO A PIPE; THENCE WEST 95 FEET TO A PIPE; THENCE NORTH 180 FEET TO A PIPE; THENCE EAST TO THE PLACE OF BEGINNING, LYING AND BEING IN THE SOUTHEAST 1/4 OF SECTION 35, TOWNSHIP 1 NORTH, RANGE 18 EAST, ALL IN THE VILLAGE OF GENOA CITY, WALWORTH COUNTY AND STATE OF WISCONSIN.

KROTT SURVEYING INC.
(262) 248-3697
N 3705 WILLOW BEND LANE
LAKE GENEVA WI. 53147

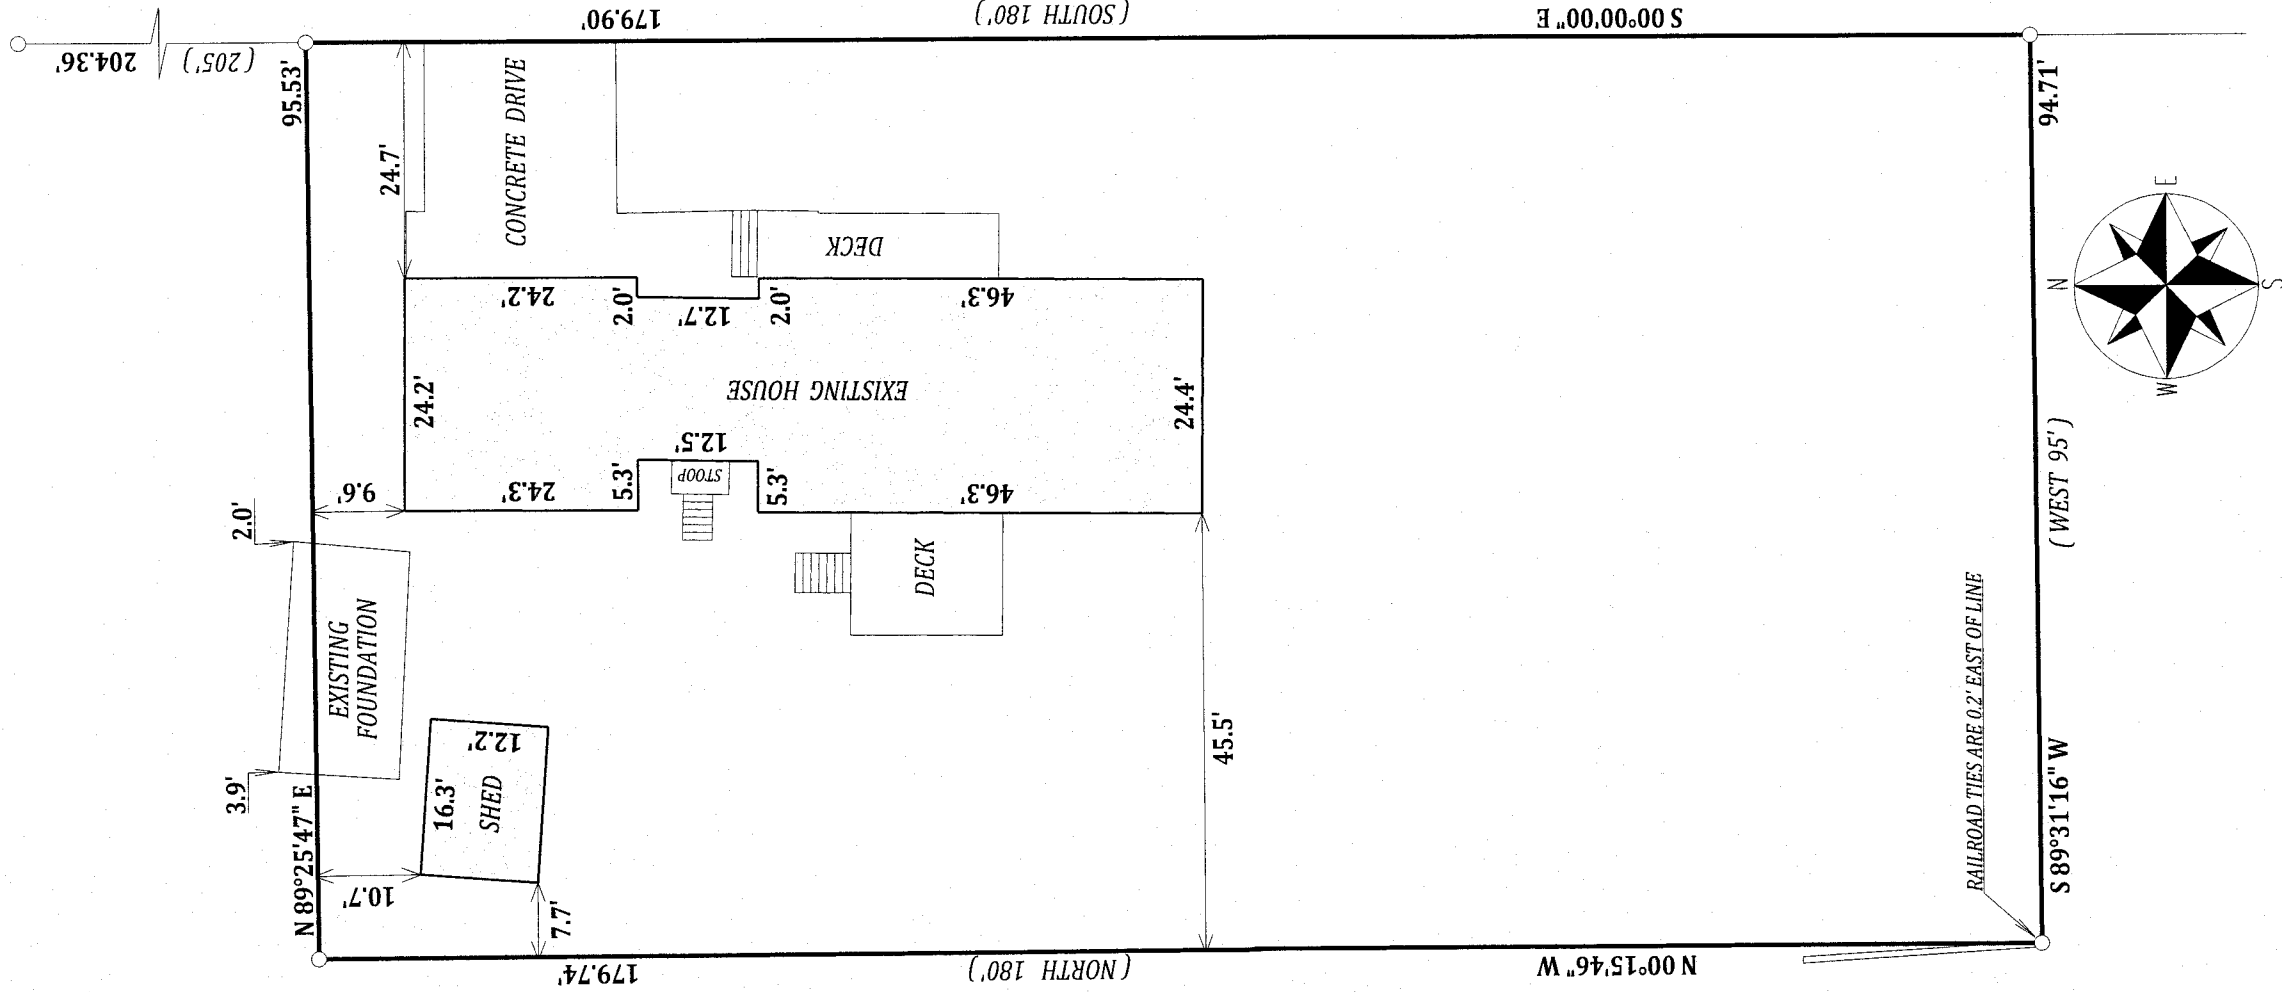

SCALE 1" = 20'
NOTE: BEARINGS ARE REFERENCED TO PREVIOUS SURVEY RECORDS

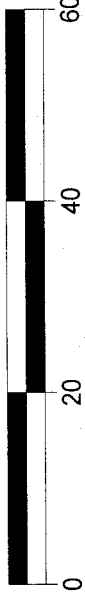

I have surveyed the above-described property and the above map is a true representation thereof and shows the size and location of the property, its exterior boundaries, the location and dimensions of all structures thereon, fences apparent easements and roadways and visible encroachments, if any.

This survey is made for the exclusive use of the present owners of the property, and also those who purchase, mortgage, or insure the title thereto within one (1) year from date hereof, and as to them I warrant the accuracy of said survey map.



LEGEND

○ FOUND IRON PIPE

(XX) RECORDED AS

TAX ID # TVGC00079C

JOB # 13-186

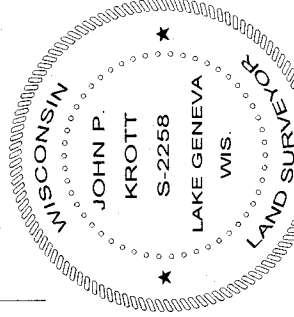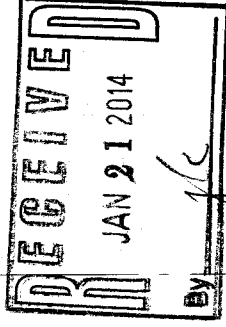

DATED THIS 10th DAY OF DECEMBER 2013

John P. Krott

JOHN P. KROTT S-2258
WISCONSIN REGISTERED LAND SURVEYOR
(NOTE: THIS IS NOT A CERTIFIED COPY
UNLESS SIGNED IN RED INK)

TVGC -79C 006-1299