


ALLEY

82.5'

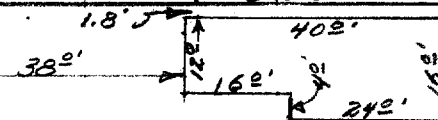

Lot 14 Carey's Add.
Village of Genoa City
Walworth County, Wis.

0 Iron Stakes.

W I S C O N S I N S T R E E T

DESCRIPTION:

Lot 14 of Carey's Addition, located in the Village of Genoa City, Town 1 north, Range 18 east, Walworth County, Wisconsin.

CERTIFICATE:

I, James F. Biagi, surveyor, do hereby certify that I have surveyed the property hereon described and that the improvements are as shown.

Date: December 11th 1968.

James F. Biagi, RLS 272
Elkhorn, Wisconsin.