


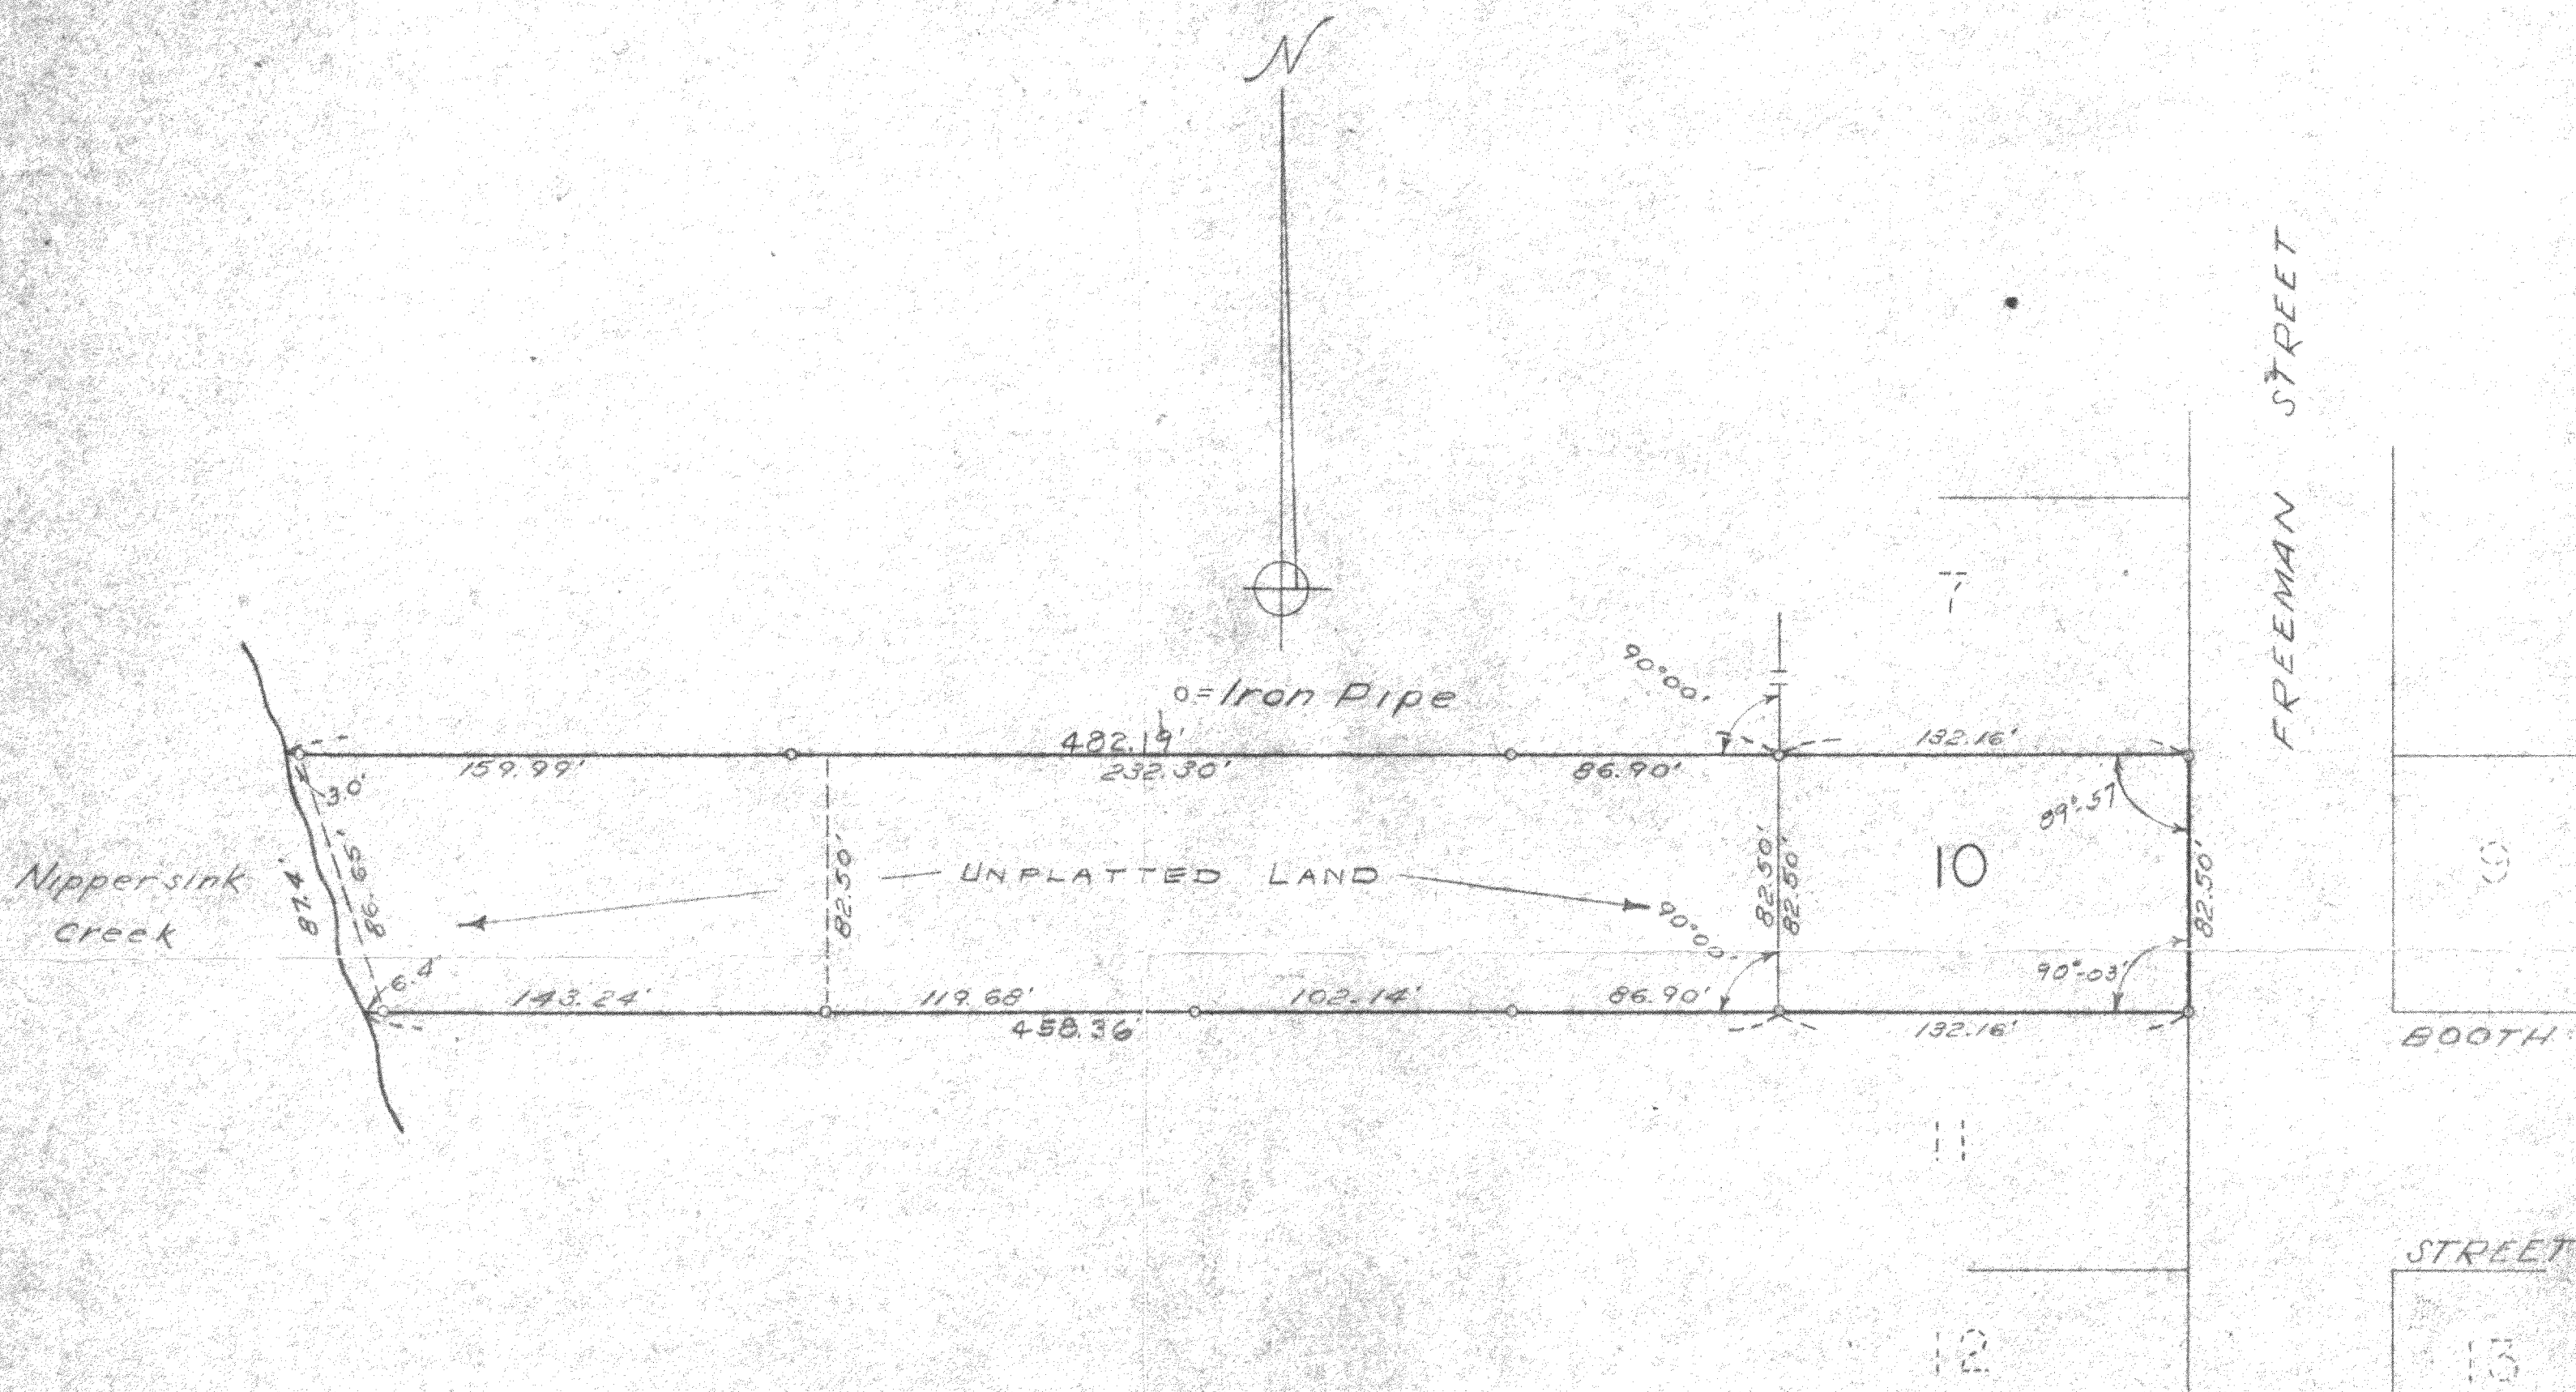

PLAT OF SURVEY OF

Lot 10 of Freeman Addition, in
the Village of Genoa City, in
Walworth County, Wisconsin,
and unplatted land lying West
of Lot 10.

Lloyd L. Jensen
SURVEYOR

SCALE 1" = 50'

DATE Sept. 13, 1958