
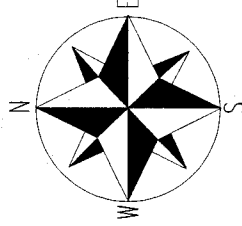


PREPARED FOR
TAMMY HAASE
KEEFE REAL ESTATE
751 GENEVA PARKWAY
LAKE GENEVA WI 53147

PLAT OF SURVEY OF



KROTT SURVEYING INC.
(262) 248-3697
N 3705 WILLOW BEND LANE
LAKE GENEVA WI. 53147

LOT 1 OF CERTIFIED SURVEY MAP NO. 3419 AS RECORDED IN VOLUME 19 OF
CERTIFIED SURVEYS ON PAGE 287 AS DOCUMENT NO. 506421 AND LOCATED
IN THE SOUTHWEST 1/4 OF SECTION 36, TOWN 1 NORTH, RANGE 18 EAST,
VILLAGE OF GENOA CITY, WALWORTH COUNTY, WISCONSIN.

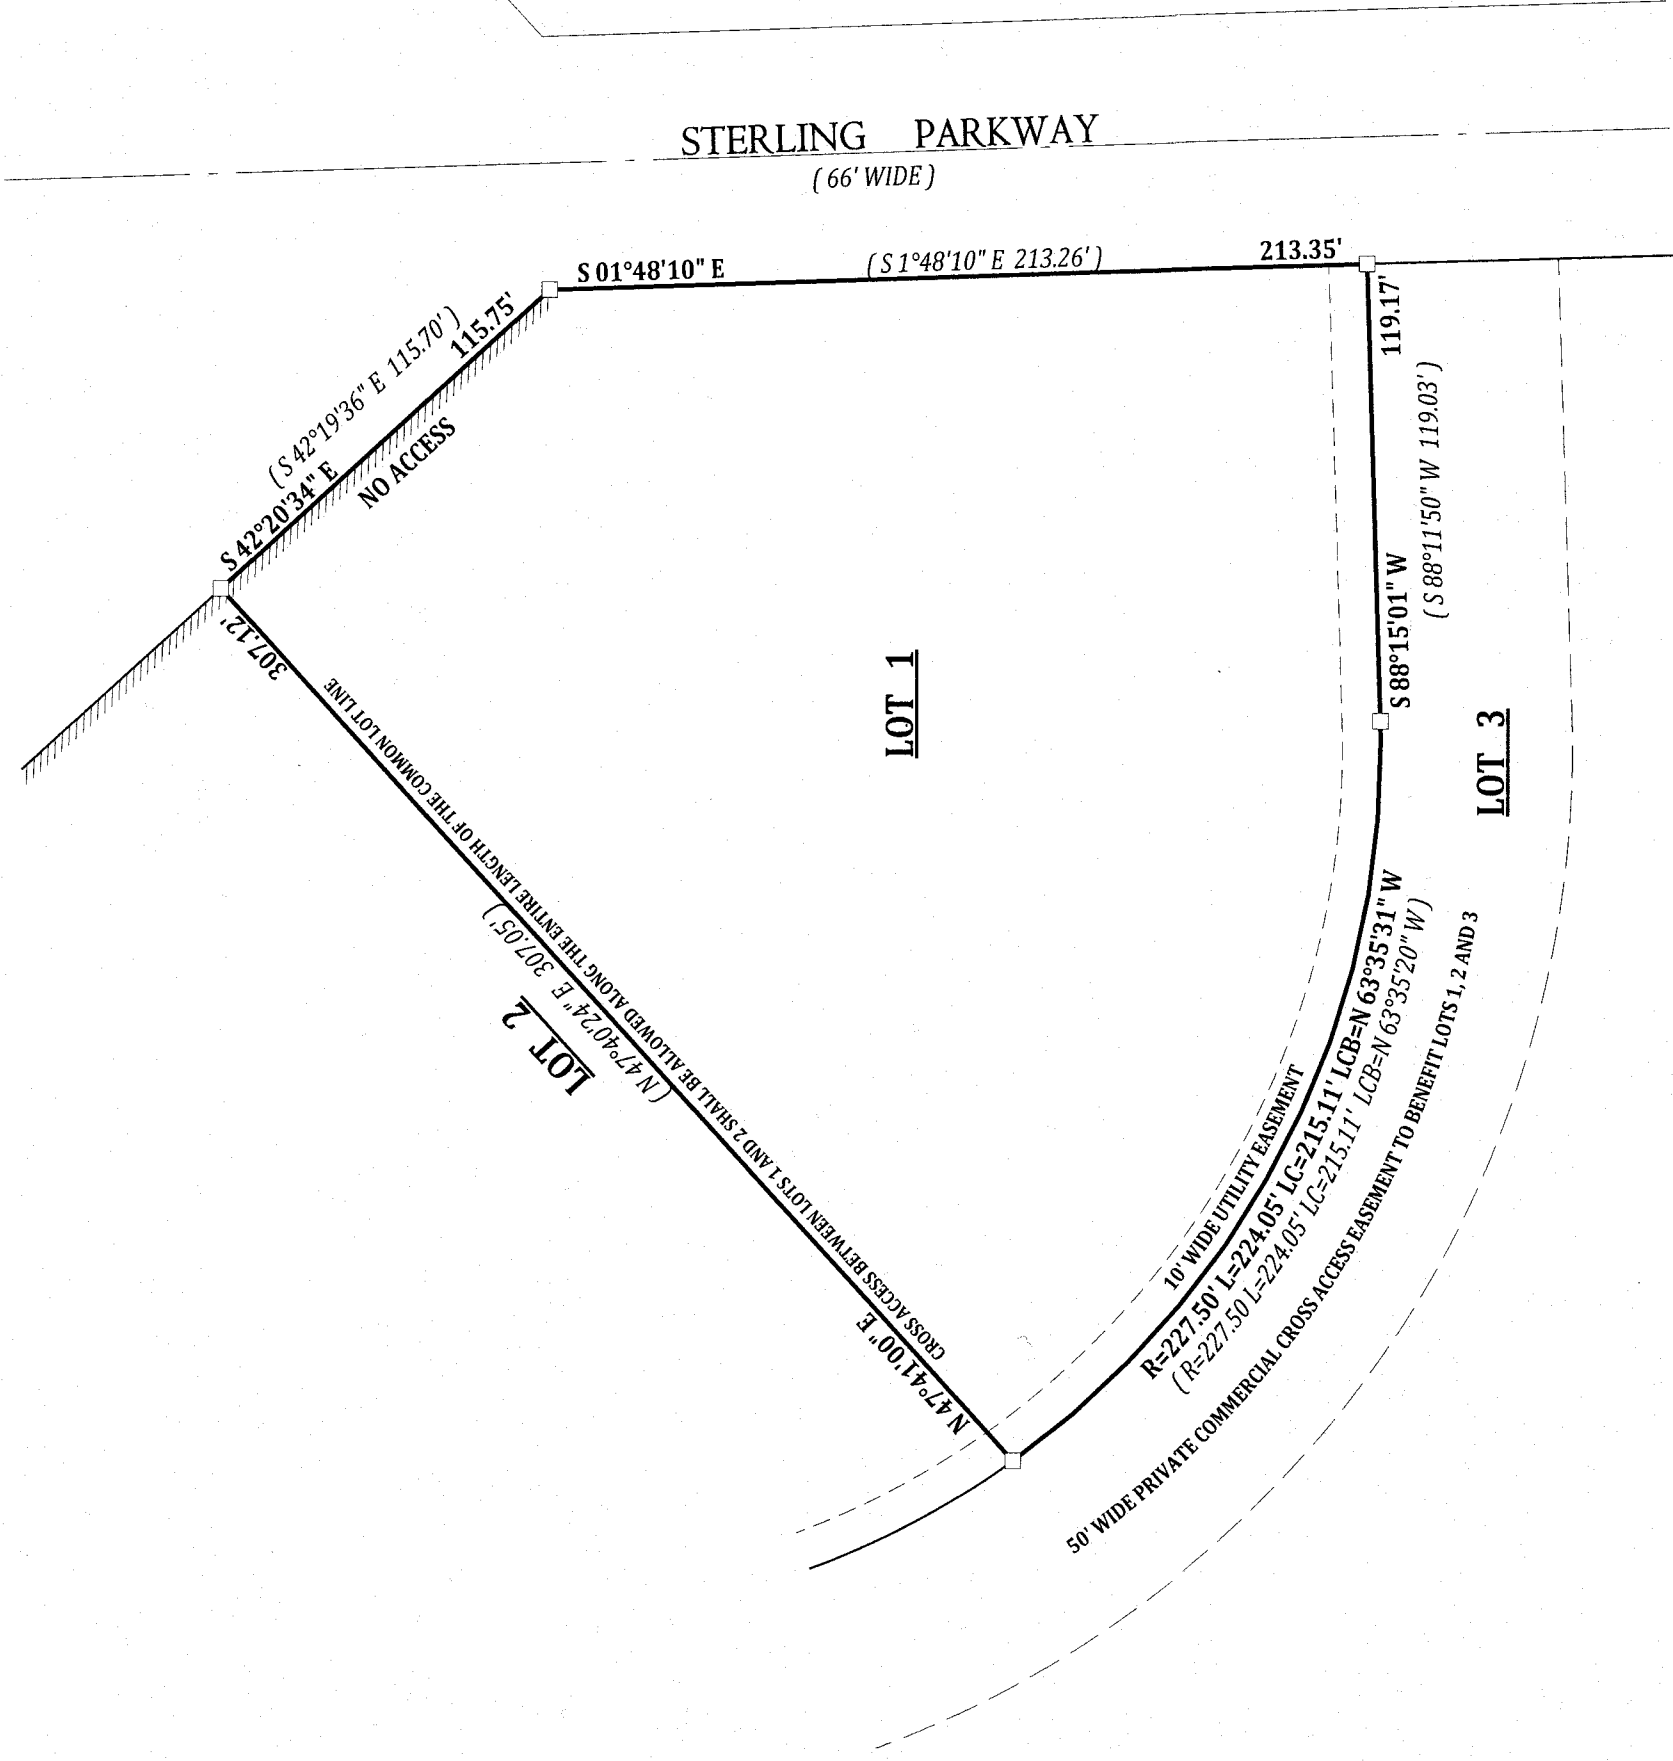

SCALE 1" = 50'

NOTE: BEARINGS ARE REFERENCED TO C.S.M. # 3419.

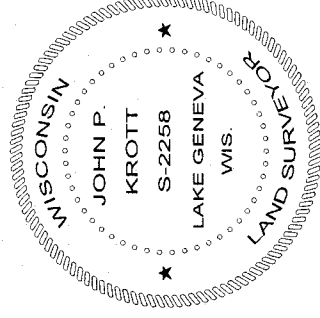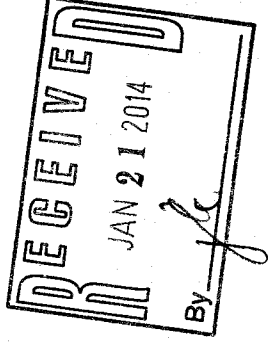

LEGEND

□ FOUND IRON BAR

(XX) RECORDED AS

TAX ID # TA341900001

JOB # 13-187

I have surveyed the above-described property and the above map is a true representation thereof and shows the size and location of the property, its exterior boundaries, the location and dimensions of all structures thereon, fences apparent easements and roadways and visible encroachments, if any.

This survey is made for the exclusive use of the present owners of the property, and also those who purchase, mortgage, or insure the title thereto within one (1) year from date hereof; and as to them I warrant the accuracy of said survey map.

DATED THIS 11th DAY OF DECEMBER 2013

John P. Krott
JOHN P. KROTT S-2258
WISCONSIN REGISTERED LAND SURVEYOR
(NOTE: THIS IS NOT A CERTIFIED COPY
UNLESS SIGNED IN RED INK)

TA3419-1 006-1300