

AMBIT LAND SURVEYING
P. O. Box 42
Bassett, Wisconsin 53101
Licensed Professionals in
both Illinois & Wisconsin

PLAT OF SURVEY OF

PHONE: 262-537-4874


FAX: 262-537-4221

EMAIL: ambit@tds.net

the South 75 feet of Lot 1 of WALWORTH COUNTY CERTIFIED SURVEY MAP NO. 1632, according to the recorded plat thereof, recorded in Volume 7 of Certified Surveys on Page 320, as Document Number 154108, located in the Southeast Quarter of Section 35, Township 1 North, Range 18 East of the 4th Principal Meridian, said land being in the Village of Genoa City, County of Walworth and State of Wisconsin.


PARCEL IDENTIFICATION NO.: TA 163200001

OFFICE COPY

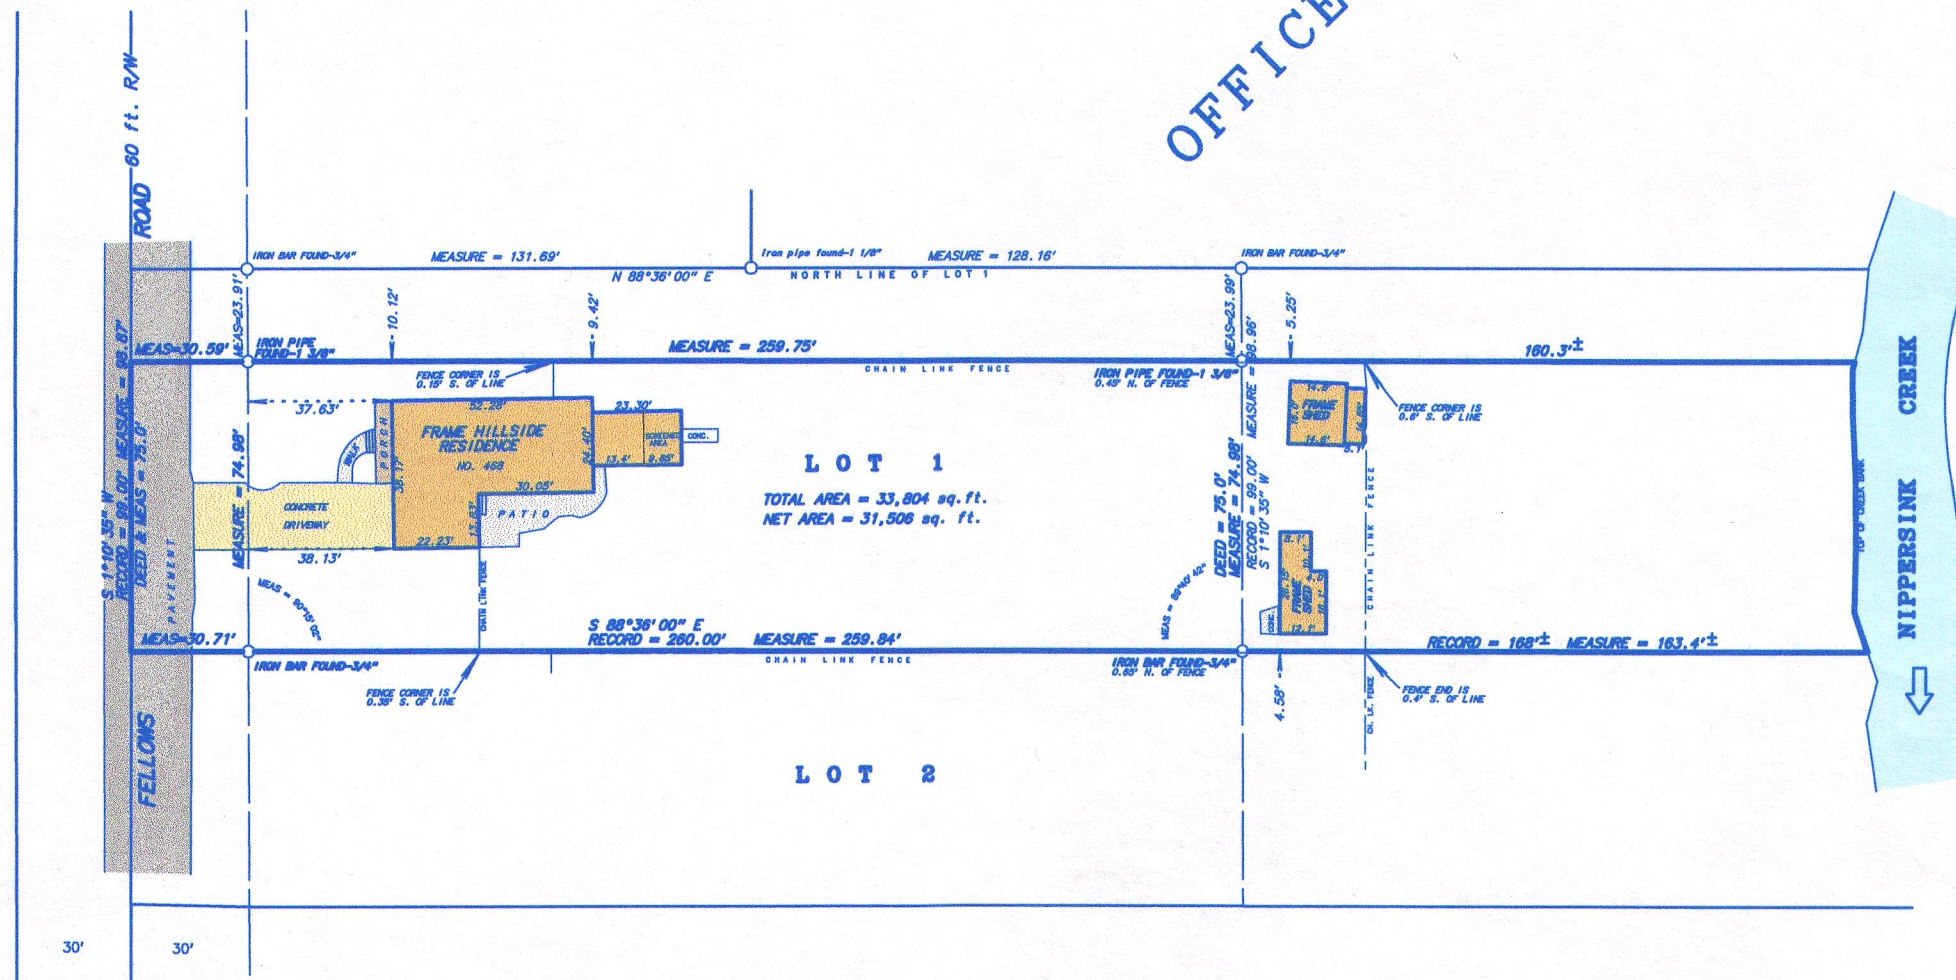

NOT TO SCALE
1 inch = 30 feet

SCALE: 1 inch = 30 feet
ORDERED BY: B. Goodnough / BEAR Realty
JOB NO.: 13082

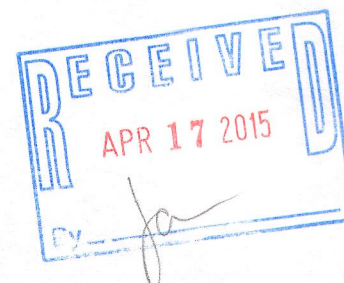

Fieldwork completed on and date of certification: July 27, 2013
I hereby certify that I have surveyed the above described property and the above plat is a true representation thereof and shows the size and location of the property, its exterior boundaries, the location and dimensions of all visible structures thereon, boundary fences, apparent easements and roadways and visible encroachments, if any.
This survey is made for the exclusive use of the present owners of the property, and also those who purchase, mortgage or guarantee the title thereto within ONE YEAR from the date hereof.
Dated at Bassett, Wisconsin this _____ day of _____, 2013.
Mark A. Bolender
Mark A. Bolender
Wisconsin Professional Land Surveyor 1784

TA 1632-1

006-1309