




Vanderstappen
Land Surveying, Inc.
www.vandersinc.com
1316 N. Madison St.
Woodstock, Illinois 60098
ph. 815-337-8310 fax 815-337-8314
"Always faithful to the property line"

PLAT OF SURVEY

Lot 2, Block 4, in J.H. Rowe Subdivision, (except that part being described as follows; beginning at the Southeast corner of said Lot 2, thence North 52 feet, thence West 5 Feet, thence South 52 feet, thence East 5 feet to the point of beginning,) said land being located in the Village of Genoa City, Walworth County, Wisconsin.

FRANKLIN STREET

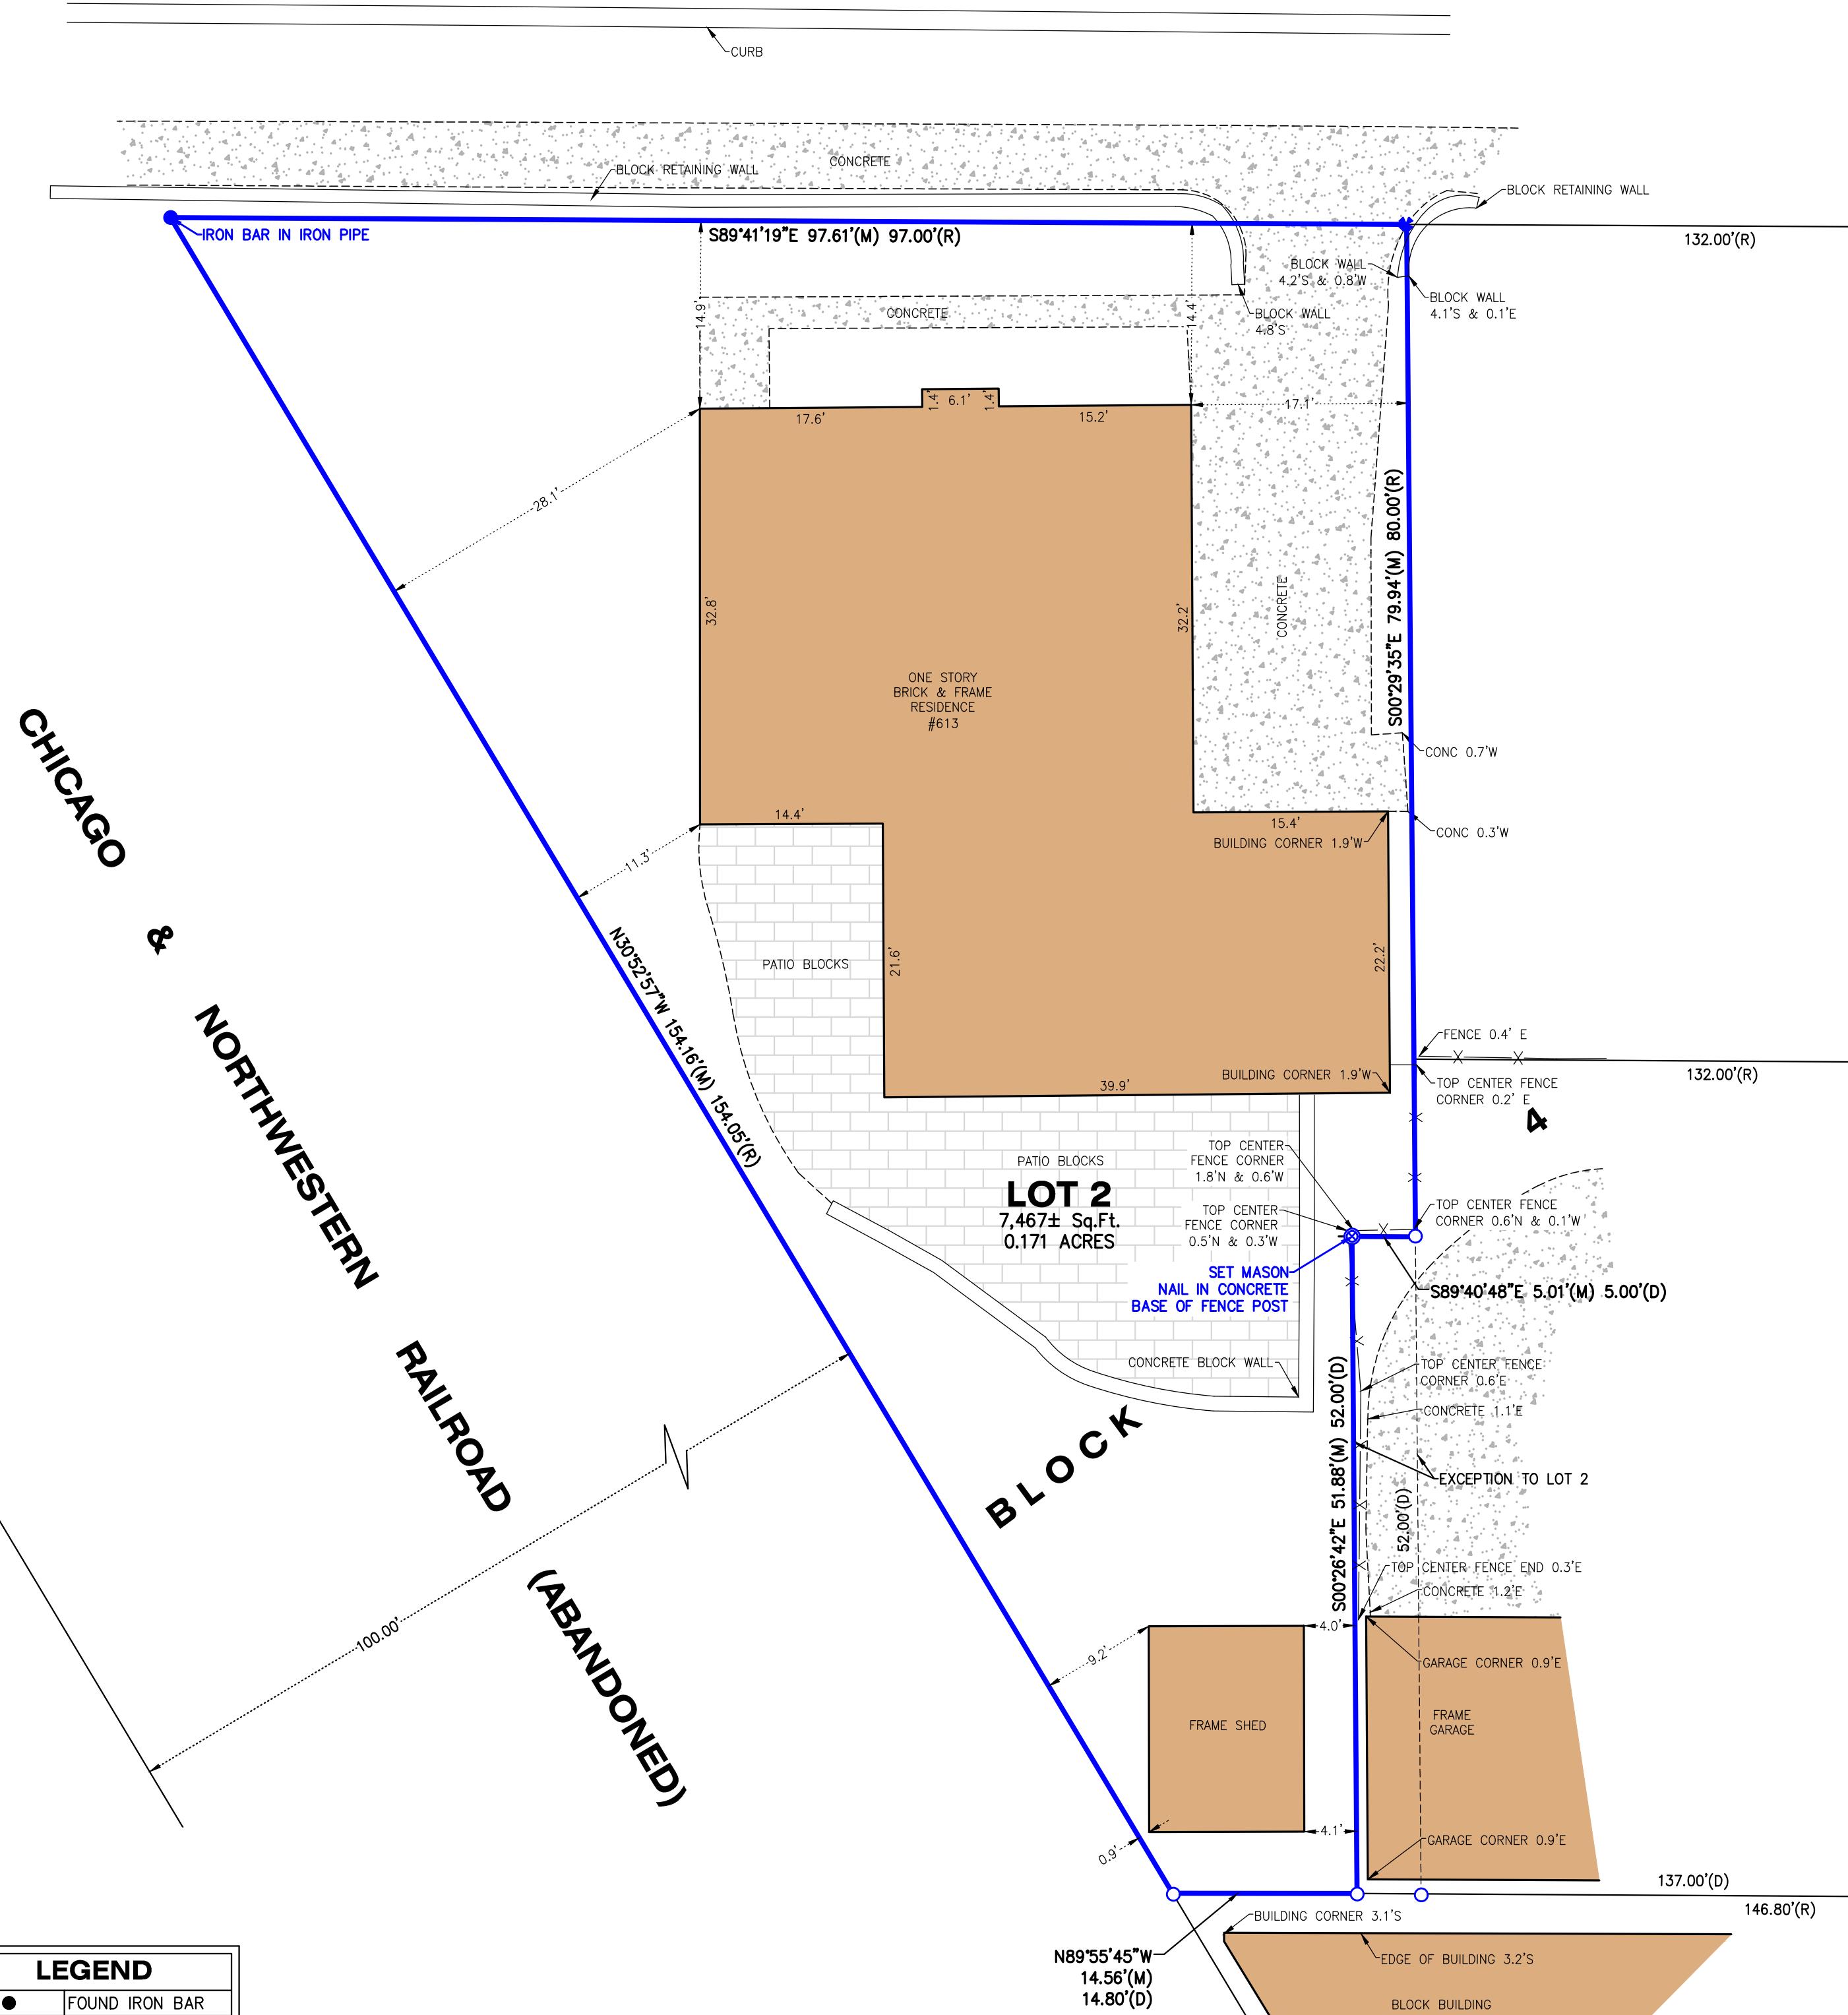

LEGEND	
●	FOUND IRON BAR
○	FOUND IRON PIPE
⊛	SET CROSS
●	SET IRON BAR
†	SIGN
(M)	MEASURED
(D)	DEED
(R)	RECORD

NOTE: Only those Building Line Restrictions or Easements shown on a Recorded Subdivision Plat are shown hereon unless the description ordered to be surveyed contains a proper description of the required building lines or easements.

- * No distance should be assumed by scaling.
- * No underground improvements have been located unless shown and noted.
- * No representation as to ownership, use, or possession should be hereon implied.
- * This Survey and Plat of Survey are void without original embossed or colored seal and signature affixed.

STATE OF ILLINOIS)
COUNTY OF McHENRY) S.S.

In my professional opinion, and based on my observations, I hereby certify that the above described property has been surveyed under my direction and that the above map is a true representation thereof and shows the size and location of all visible structures, and dimensions of all principle buildings thereon, boundary fences, apparent easements, roadways, and visible encroachments, if any. This survey is made for the use of the present owners of the property, and also those who purchase, mortgage, or guarantee the title thereto within one year from the date hereof.

Dated at Woodstock, McHenry Co.
Vanderstappen Land Surveying, Inc.
Design Firm No. 184-002792

By: Arthur Spitzack

Wisconsin Registered Land Surveyor No. S3021

CLIENT: APRIL TUDOR
DRAWN BY: CKV CHECKED BY: APG
SCALE: 1"=10' SEC. 35 T. 01 R. 18 E
BASIS OF BEARING: ASSUMED
P.I.N.: TR 00033
JOB NO.: 200777-A I.D. UPD
FIELDWORK COMP.: 11/04/22 BK. PG.
ALL DISTANCES SHOWN IN FEET AND DECIMAL REF:

Compare your description and site markings with this plat and AT ONCE report any discrepancies which you may find.