



LOT 3, BLOCK 1, J. H. ROWE'S ADDITION TO GENOA JUNCTION, LOCATED IN THE VILLAGE OF GENOA CITY,
WALWORTH COUNTY, WISCONSIN.

O = IRON PIPE STAKE FOUND.

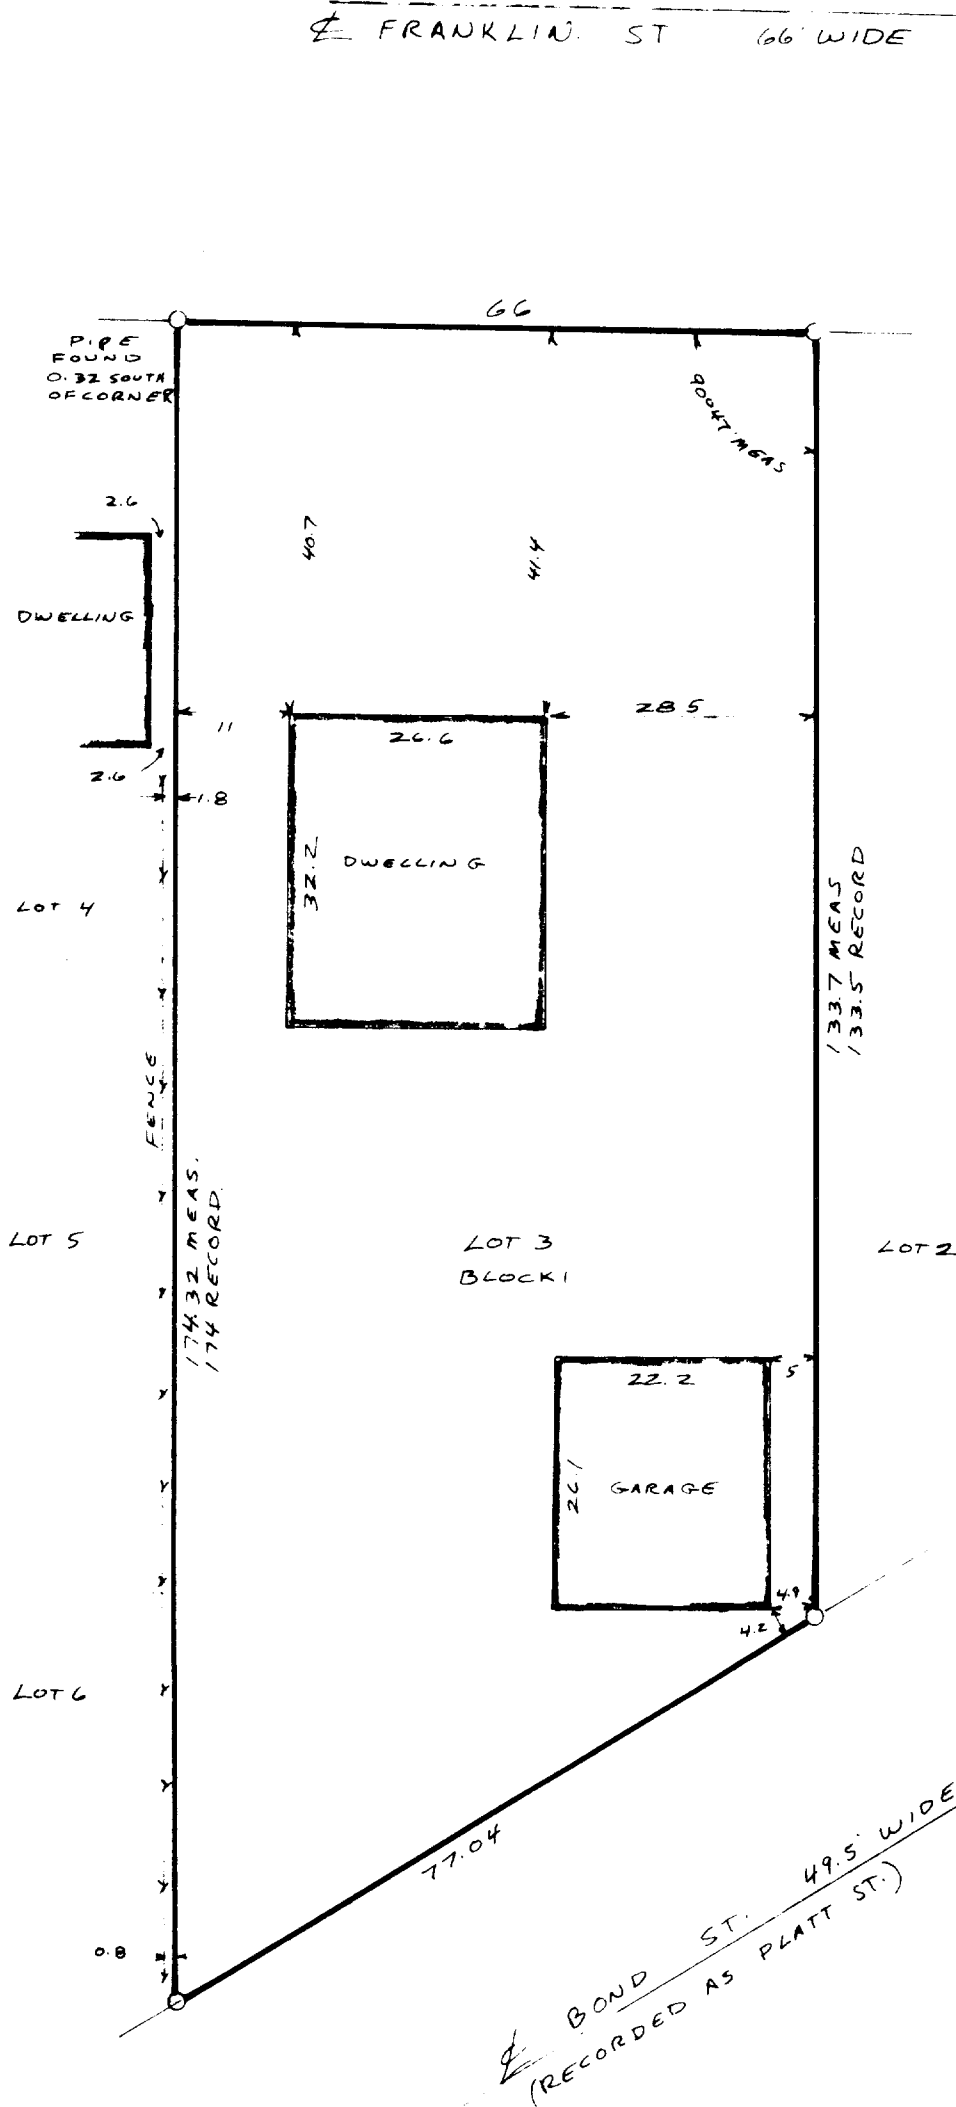

MARCH 17th
83
John F. Deegan

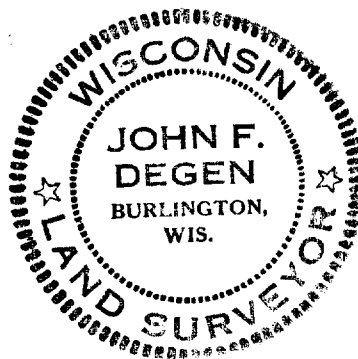

TR-3
12-0-1 #38

6-138-JD