


PLAT OF SURVEY -OF-

LOT 128, HUNTERS RIDGE SUBDIVISION, LOCATED IN THE SOUTHWEST 1/4 OF SECTION 25, TOWN 1 NORTH, RANGE 18 EAST, VILLAGE OF GENOA CITY, WALWORTH COUNTY, WISCONSIN.

SURVEY FOR: KELLER WILLIAMS
SURVEY ADDRESS: 263 DEER PATH DRIVE

NOTE: DOCUMENT NO. 380041 UTILITY AND STORM WATER EASEMENT DOES NOT AFFECT THIS PROPERTY.
NOTE: DOCUMENT NO. 323367 WATER AND SANITARY SEWER EASEMENT DOES NOT AFFECT THIS PROPERTY.

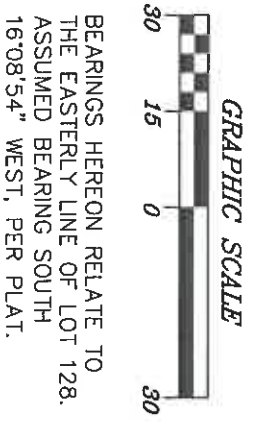

BEARINGS HEREON RELATE TO THE EASTERLY LINE OF LOT 128. ASSUMED BEARING SOUTH 16°08'54" WEST, PER PLAT.

"I hereby certify that I have surveyed the above described property and that the above map is a correct representation thereof and shows the size and location of the property, its exterior boundaries, the location of all visible structures and dimensions of all principal buildings thereon, boundary fences, apparent easements, roadways and encroachments, if any."

"This survey is made for the use of the present owners of the property, and those who purchase, mortgage, or guarantee the title thereto within one year from date hereof."



THIS IS NOT AN ORIGINAL PRINT
UNLESS THIS SEAL IS RED.

B.W. SURVEYING, INC.

412 N. PINE STREET
BURLINGTON, WI 53105
(262)-767-0225

Robert J. Wetzel
ROBERT J. WETZEL
S-1778

DECEMBER 22, 2022
DATE

10779
JOB NUMBER

