


PLAT OF SURVEY
OF

LOTS 1 AND 4, BLOCK 2 OF J. H. ROWE'S ADDITION TO GENEVA JUNCTION, A SUBDIVISION
LOCATED IN THE VILLAGE OF GENEVA CITY, WALWORTH COUNTY, WISCONSIN.


FOR: AUDREY BUEHN REALTY

SCALE 1" = 30'

o = IRON PIPE STAKE SET.

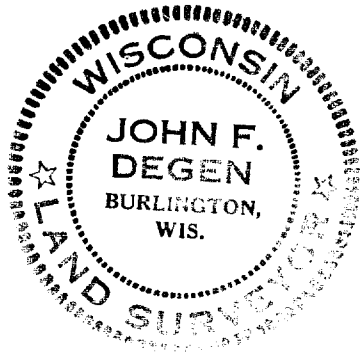

20th.
APRIL 83
John F. Degen

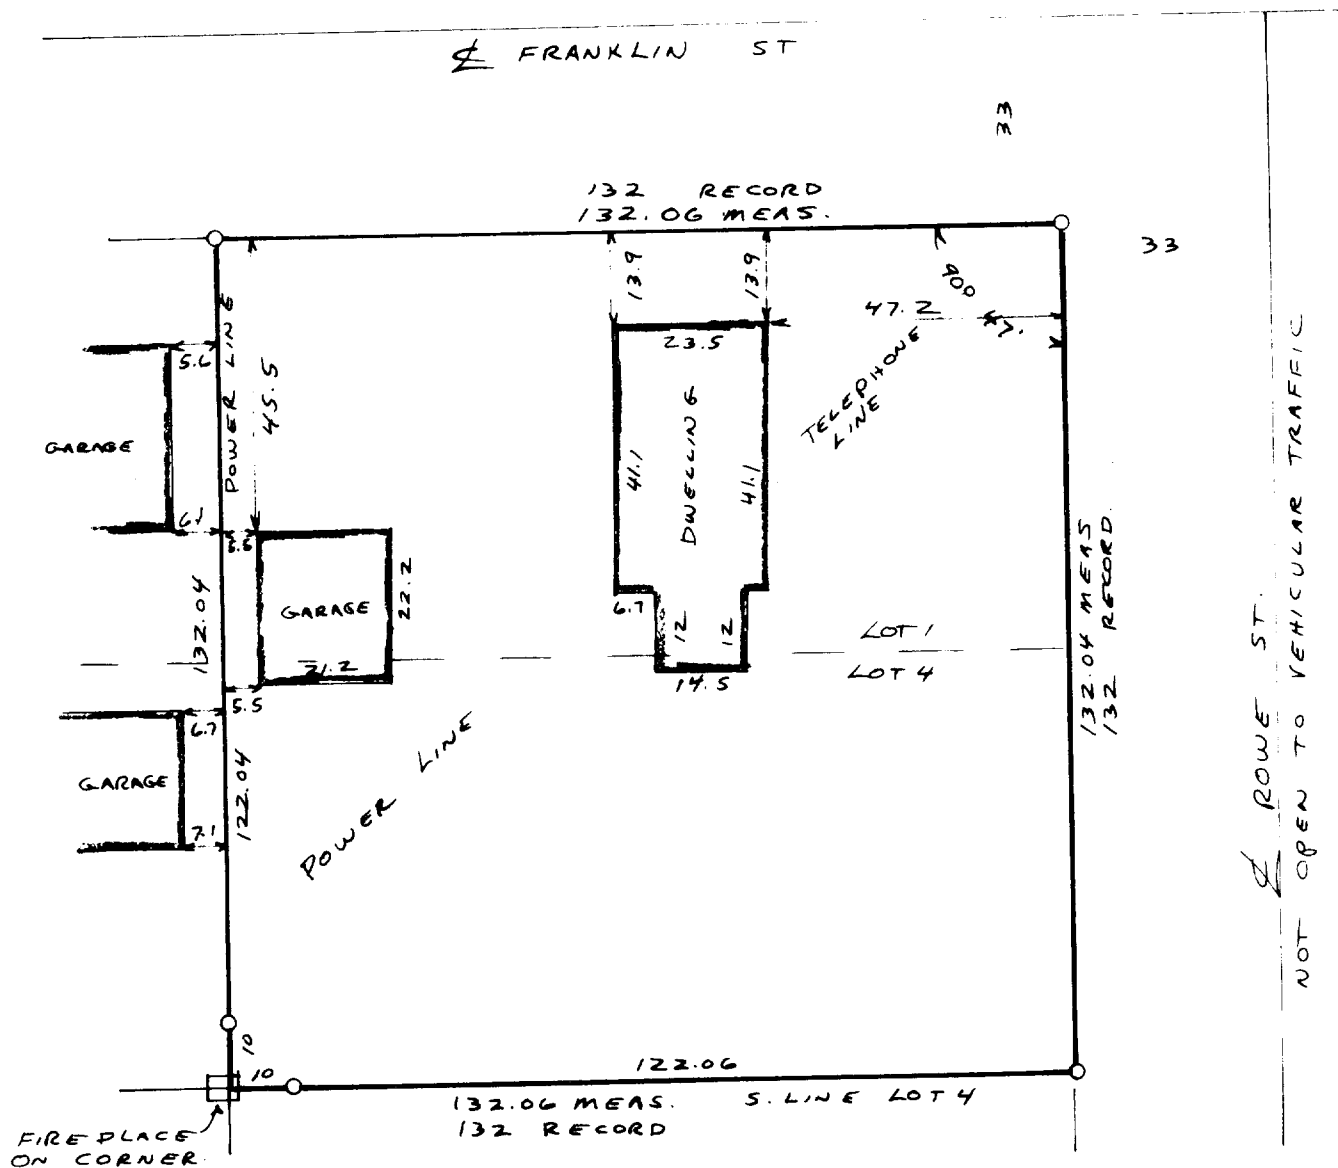

#6-142