

HOME OFFICE
108 SOUTH SPRING STREET
BURLINGTON, WISCONSIN 53108
PHONE: 414-763-2652
414-763-7834


ROBERS & BOYD, INC.
CONSULTING ENGINEERS
LAND SURVEYORS

BRANCH OFFICE
809 - 43RD STREET
KENOSHA, WISCONSIN 53140
PHONE: 414-658-4488

PLAT OF SURVEY
FOR
SUBURBAN COASTAL CORP.
OF

Lot 5, except the North 1/2 rod thereof, in Freeman's Addition to the Village of Genoa City, Walworth County, Wisconsin

SURVEY FOR: Owner-Diane M. Pawloski and John C. Ostrander, Jr.
SURVEY ADDRESS: 462 Freeman Street, Genoa City, WI

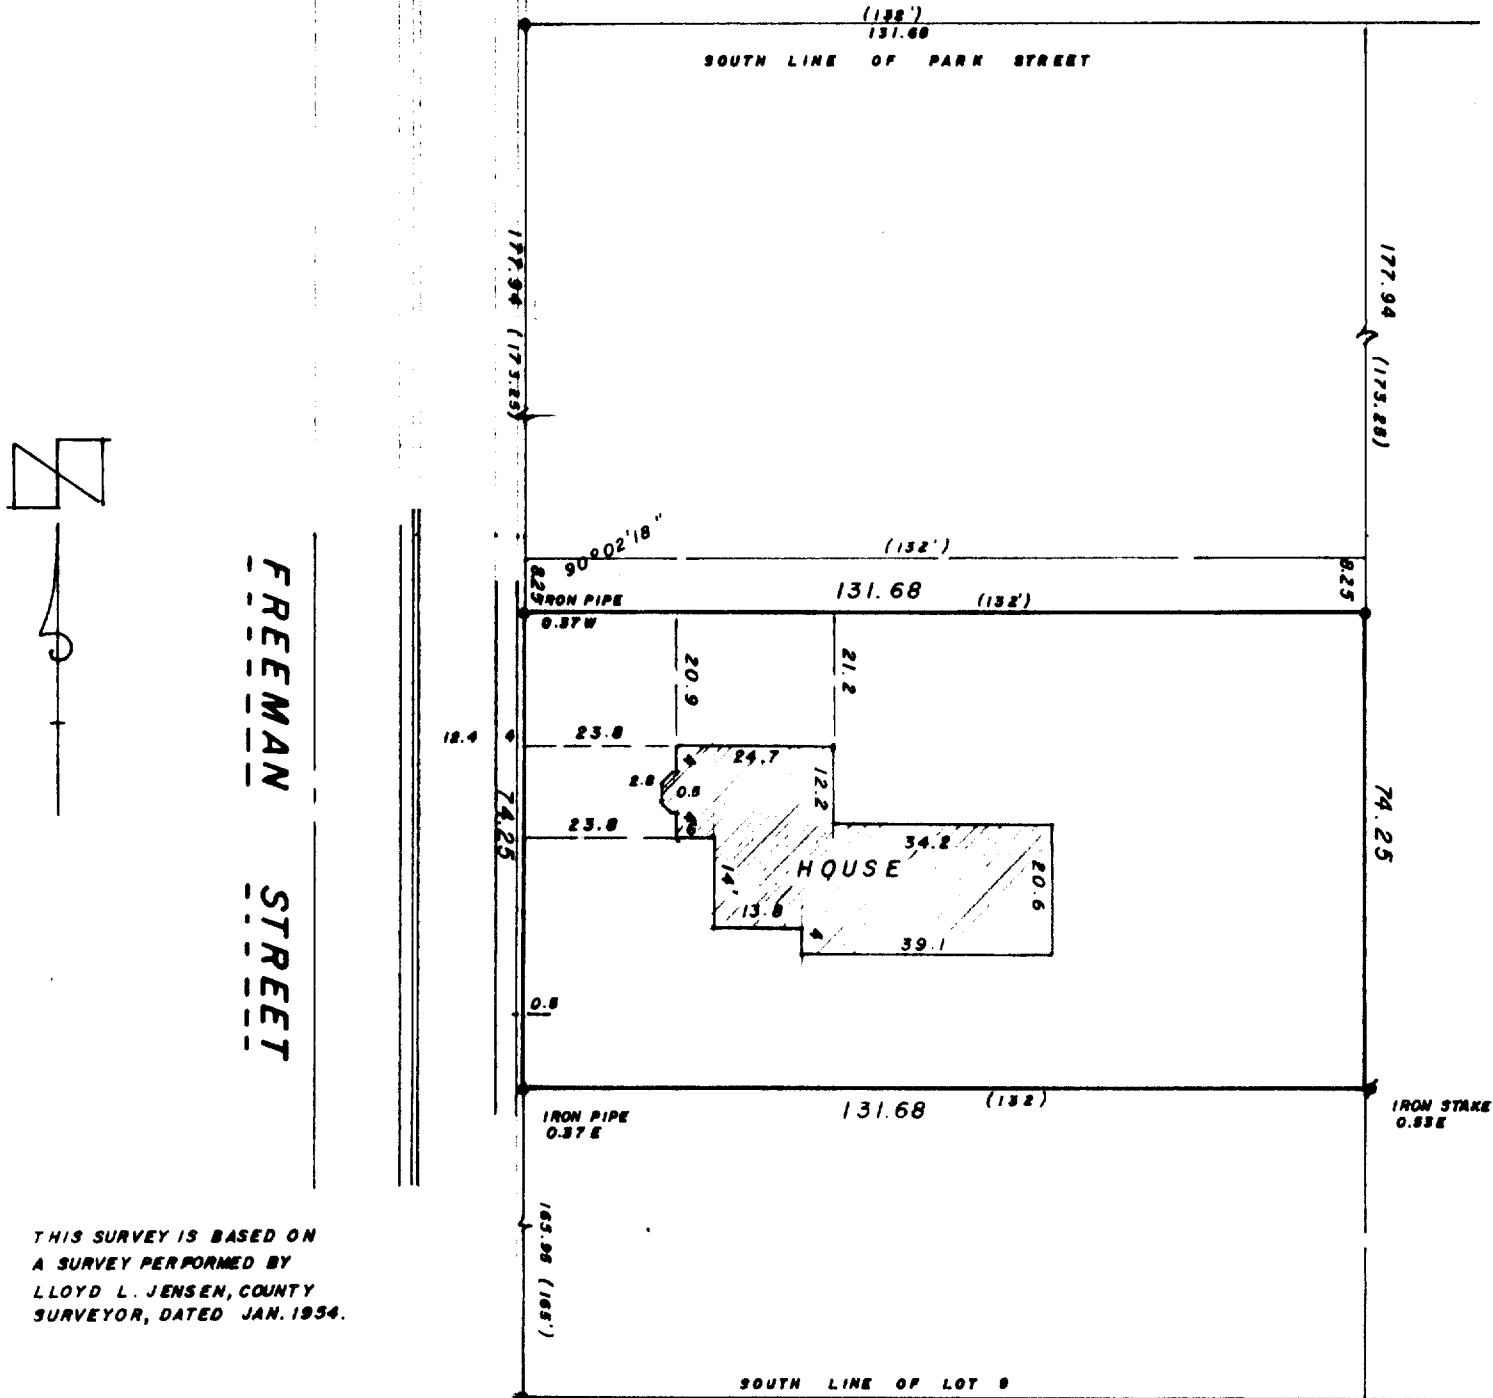

THIS SURVEY IS BASED ON
A SURVEY PERFORMED BY
LLOYD L. JENSEN, COUNTY
SURVEYOR, DATED JAN. 1934.

"I hereby certify that I have surveyed the above described property and that the above map is a true representation thereof and shows the size and location of the property, its exterior boundaries, the location of all visible structures and dimensions of all principal buildings thereon, boundary fences, apparent easements, roadways and visible encroachments, if any.

"This survey is made for the use of the present owners of the property, and also those who purchase, mortgage, or guarantee the title thereto within one year from date hereof."

NO MONUMENTATION HAS BEEN WAIVED IN ACCORDANCE WITH A-E 5.01(b) OF THE WISCONSIN ADMINISTRATIVE CODE.



- LEGEND**
- x PK NAIL FOUND
 - PK NAIL SET
 - FOUND IRON PIPE - 1-1/4"
 - FOUND IRON STAKE - 1"
 - SET IRON PIPE - 1"
 - FOUND BRASS CAPPED MONUMENT
 - FOUND CONCRETE MONUMENT
 - FENCE
 - () RECORDED AS EXISTING GROUND ELEVATION

SCALE - 1" = 30'

Kenneth R. Reesman
WISCONSIN REGISTERED LAND SURVEYOR

7-10-81
DATE

FIELD WORK BY Krr, gja

DRAWN BY Krr

81101
JOB NUMBER