

PLAT OF SURVEY OF

PART OF THE NORTHEAST 1/4 OF SECTION 35, T. 1 N., R. 18 E. OF THE 4TH P.M., VILLAGE OF GENOVA WYI, COUNTY OF WALWORTH, STATE OF WISCONSIN, AND MORE PARTICULARLY DESCRIBED AS FOLLOWS: BEGINNING AT THE CENTER OF SAID SECTION 35, RUN THENCE NORTH ON THE WEST LINE OF THE NORTHEAST 1/4 OF SECTION 35, 428.17 FEET TO THE PLACE OF BEGINNING OF PARCEL OF LAND HEREINAFTER DESCRIBED: THENCE CONTINUE NORTH ON THE WEST LINE OF THE NORTHEAST 1/4 OF SECTION 35, 80.00 FEET; THENCE N. 89°58' E., 180.00 FEET; THENCE SOUTH, PARALLEL WITH THE WEST LINE OF THE NORTHEAST 1/4 OF SECTION 35, 80.00 FEET; THENCE S. 89°58' W., 180.00 FEET TO THE PLACE OF BEGINNING.

FOR: RICHARD L. AND DONNA L. ECKLUND
AND THE SOUTHEASTERN SAVING AND LOAN

SCALE 1" = 30'

♂ = IRON PIPE STAKE FOUND.

O = IRON PIPE STAKE SET.

BEARINGS RELATE TO THE WEST LINE
OF THE NORTHEAST 1/4 OF SECTION
35-1-18 WHICH WAS USED AS NORTH
PER CALL OF DEED.

ST. ADDRESS OF SITE:

546 and 548 FELLOWS ROAD.

WEST 33 FEET OF LAND SURVEYED IS
SUBJECT TO RIGHTS OF PUBLIC
FOR ROAD.


PARCEL CONTAINS 11760 SQUARE FEET
OF LAND EXCLUSIVE OF ROAD.

As surveyed the above-described property and the map herein is a true representation thereof and shows the size and location of the property as aforesaid bounded by the location and dimensions of the structures therein, as shown on the map, and highways and adjoining lands as shown.

the experiment, and the use of the data for use of the experiment, and also the use of the data for use of the experiment.


25th
NOVEMBER 83

NOVEMBER 83
John F. Degen

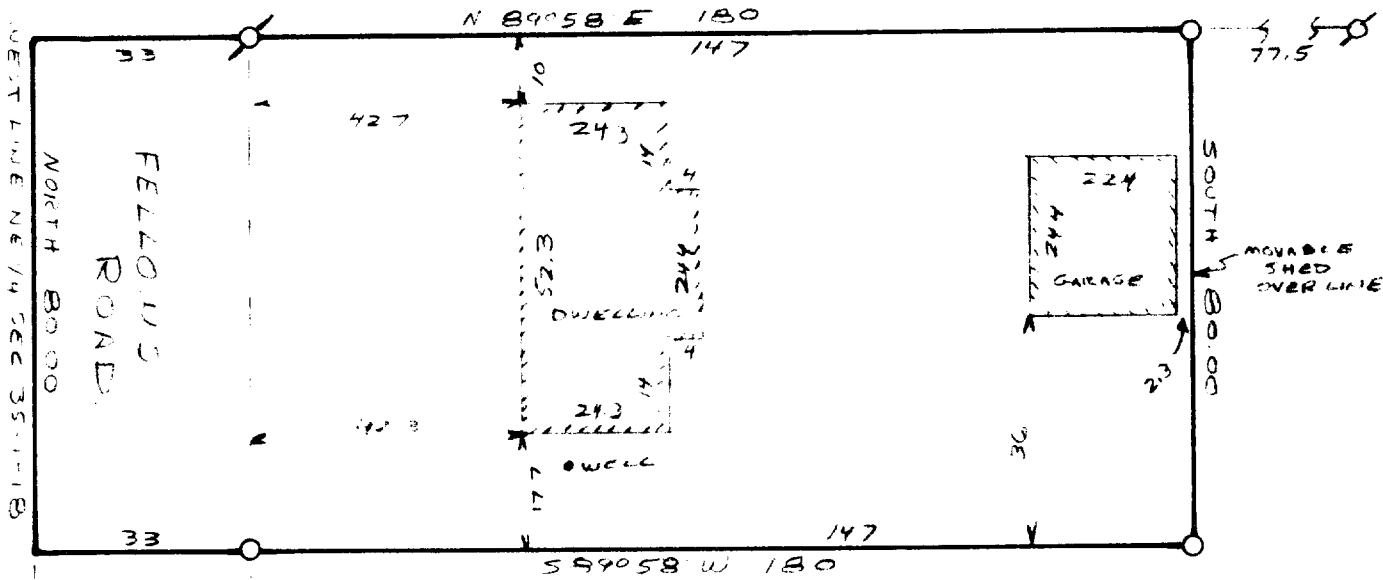

(428.17 REC.)
T
(428.00 MEA.)

ENTER
SEC. 35-1-18

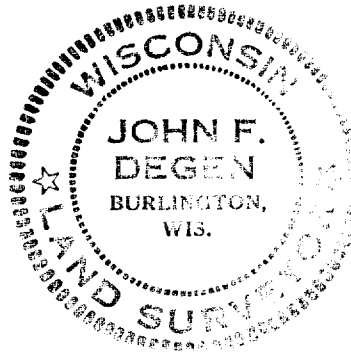

VGC-26B

6-146