


LOT 2, BLOCK 2, GIFFORD'S ADDITION TO GENOA JUNCTION, LOCATED IN THE VILLAGE OF GENOA CITY, WALWORTH COUNTY, WISCONSIN.

SCALE 1" = 30'

o = IRON PIPE STAKE SET.


σ = IRON PIPE STAKE FOUND.

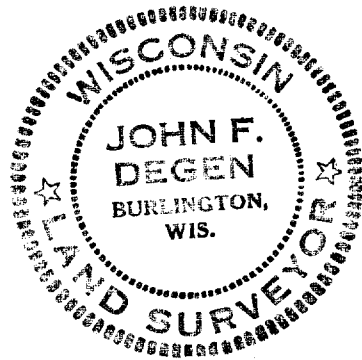

the court surmised the owner had been negligent and the road became a source of contamination. The court also considered the location of the property, its size, and the length and density of the road. The court then determined the appropriate level of liability, and awarded damages for the property damage and the cost of the road, and the value of the property.

The results suggest that the higher use of the credit card is associated with higher income and also those with higher education. The use of a guaranteed line of credit is also associated with higher income and higher education.

DATE: 12/21/83 21ST 10Y
DECEMBER 83
John F. Leagen
Agent and Surveyor S 242

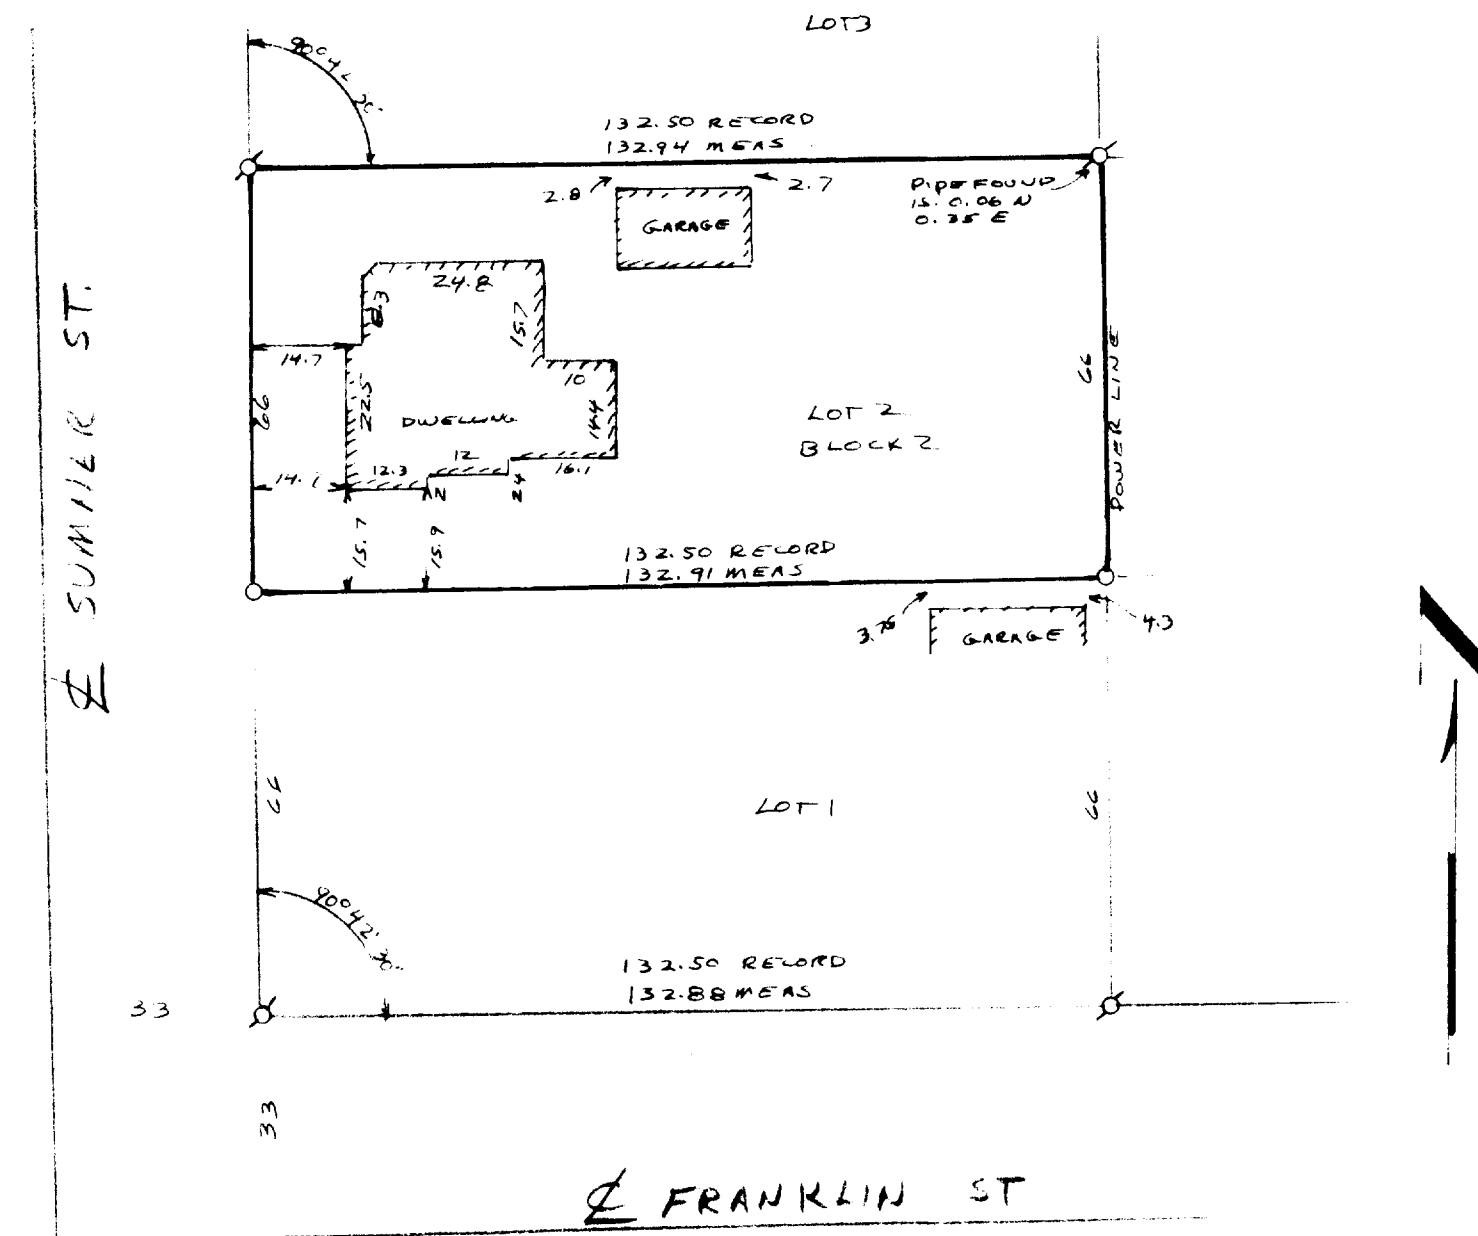

6-150✓

11-1-40