

PLAT OF SURVEY
OF

LOT 8 AND THE SOUTH $\frac{1}{2}$ OF LOT 7 IN BLOCK 2 OF GIFFORD'S ADDITION TO THE VILLAGE OF GENOVA CITY,
WALWORTH COUNTY, WISCONSIN.


SCALE 1" = 30

o = IRON PIPE STAKE FOUND.

FOR: SELLERS: KIM AND KIM MOHRBACHER
BUYERS: RANDY AND KAREN VOLBRECHT.

I have surveyed the above described property and the map hereon is a true representation thereof and shows the size and location of the property, its exterior boundaries, the location and dimensions of all visible structures thereon, fences, apparent easements, and railways and visible encroachments thereon.


This survey is made for the exclusive use of the present owner and does not constitute any warranty or guarantee of title by me or my firm, and I do not warrant the title thereto, which can be determined by deed.

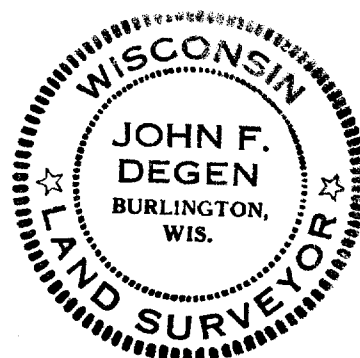

Dated at Burlington, this 17th day
of APRIL 1984

John F. Degen
John F. Degen, Land Surveyor # 742

REVISED 4-29-84
TO CHANGE CAPTION

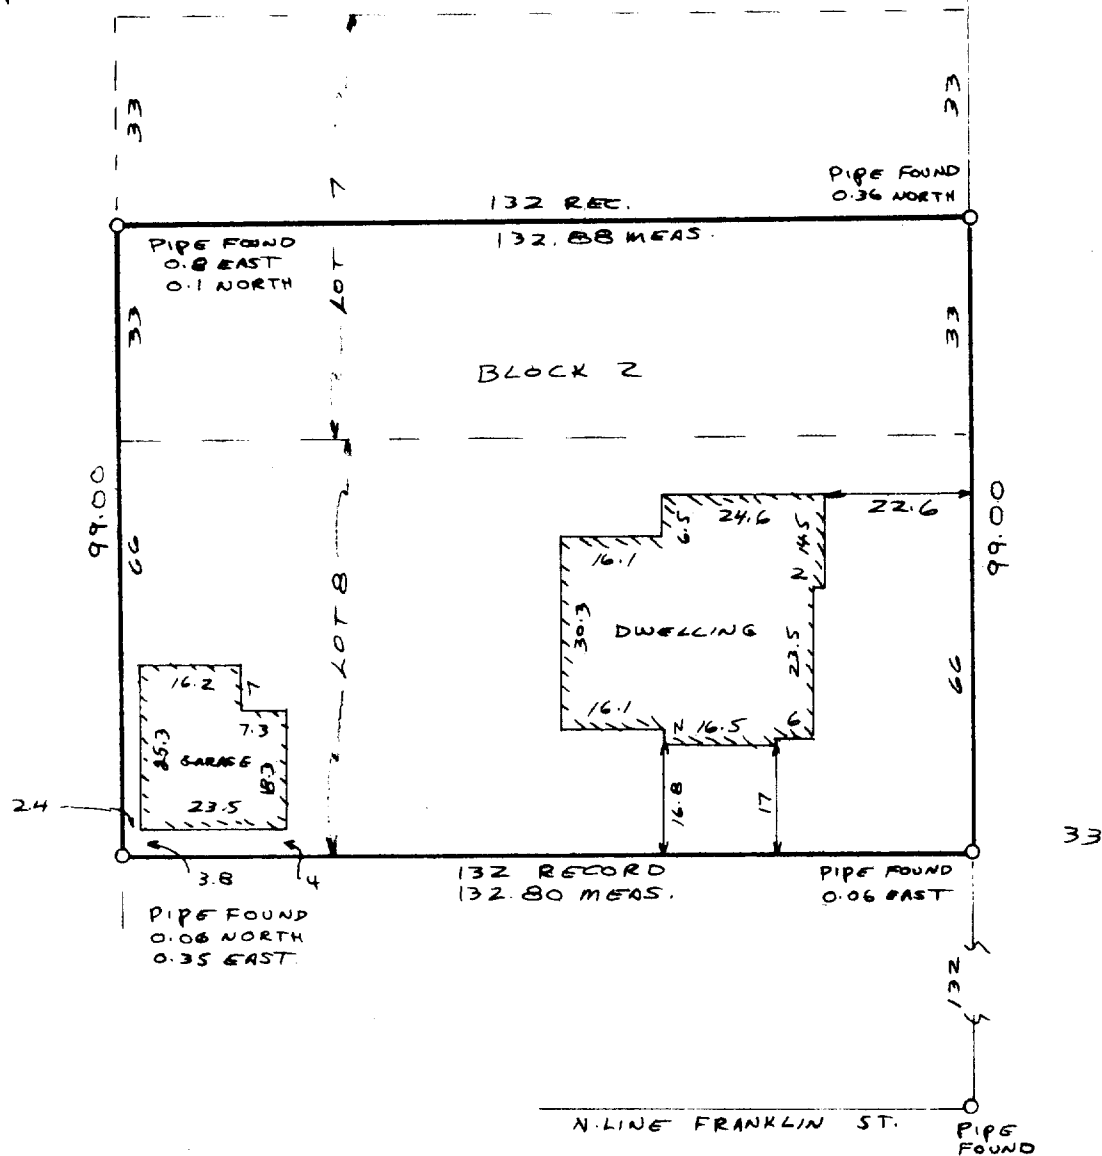

WISCONSIN ST.

6-152

11-13-1 #17

PLAT OF SURVEY
OF

LOT 8 AND THE SOUTH HALF OF LOT 7, BLOCK 2, IN GIFFORD'S ADDITION TO GENEVA JUNCTION, A PLAT OF RECORD, LOCATED IN THE VILLAGE OF GENEVA CITY, COUNTY OF WALWORTH, STATE OF WISCONSIN.


SCALE 1" = 30'

o = IRON PIPE STAKE FOUND.

FOR: SELLERS: KEN AND KIM MOHRBACHEN
BUYERS: RANDY AND KAREN VOLBRECHT.


I have surveyed the above-described property, and the map hereon is a true representation thereof and shows the size and location of the property, its exterior boundaries, the location and dimensions of all visible structures thereon, fences, apparent easements and roadways and visible encroachments, if any.

This survey is made for the exclusive use of the present owners of the property, and also those who purchase, mortgage, or guarantee the title thereto, within one year from date hereof.

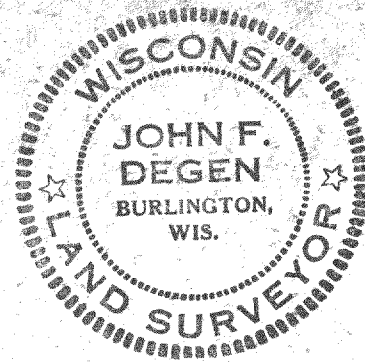

Dated at Burlington, this 17th day
of April, 1984

John F. Degen
John F. Degen, Land Surveyor # 242

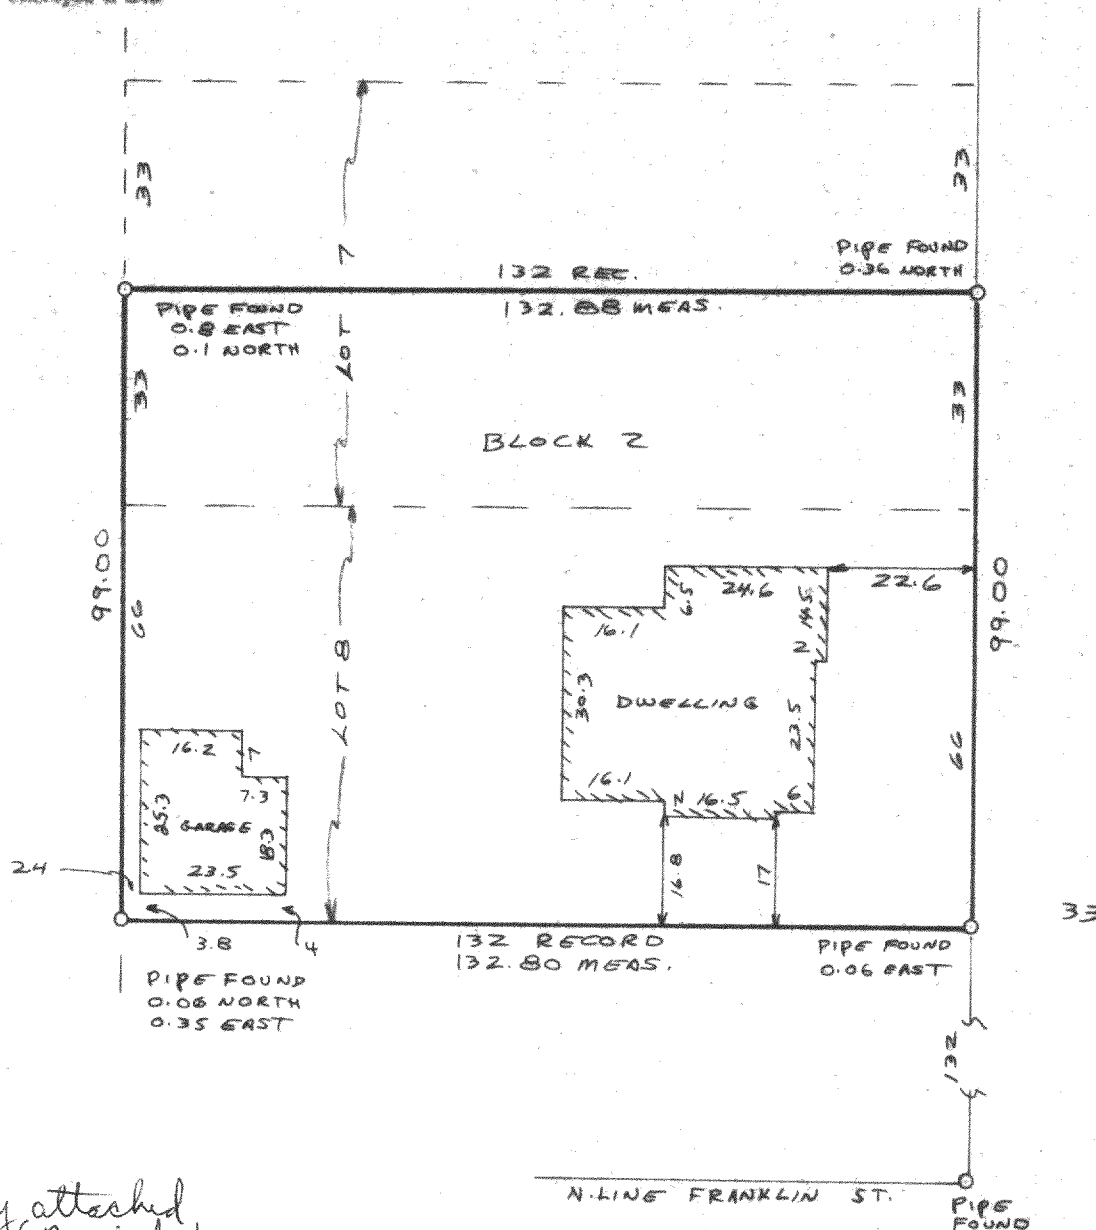

WISCONSIN ST.

see next copy attached
TG-18 (Revised)

6-158

11-13-1 #17