

PLAT OF SURVEY
OF

LOT 1, BLOCK 4, OF GIFFORD'S ADDITION TO THE VILLAGE OF GENEVA CITY, WALWORTH COUNTY, WI.

FOR: BARRY PECK

SCALE 1" = 20'


o = IRON PIPE STAKE SET.

Ø = IRON PIPE FOUND

I have surveyed the above-described property and the map hereon is a true representation thereof and shows the size and location of the property, its exterior boundaries, the location and dimensions of all visible structures thereon, fences, apparent easements and roadways and visible encroachments, if any.

This survey is made for the exclusive use of the present owners of the property, and also those who purchase, mortgage, or guarantee the title thereto, within one year from date hereof.

Dated at Burlington, this 14th day of JUNE 1984
John F. Degen
John F. Degen, Land Surveyor S 242

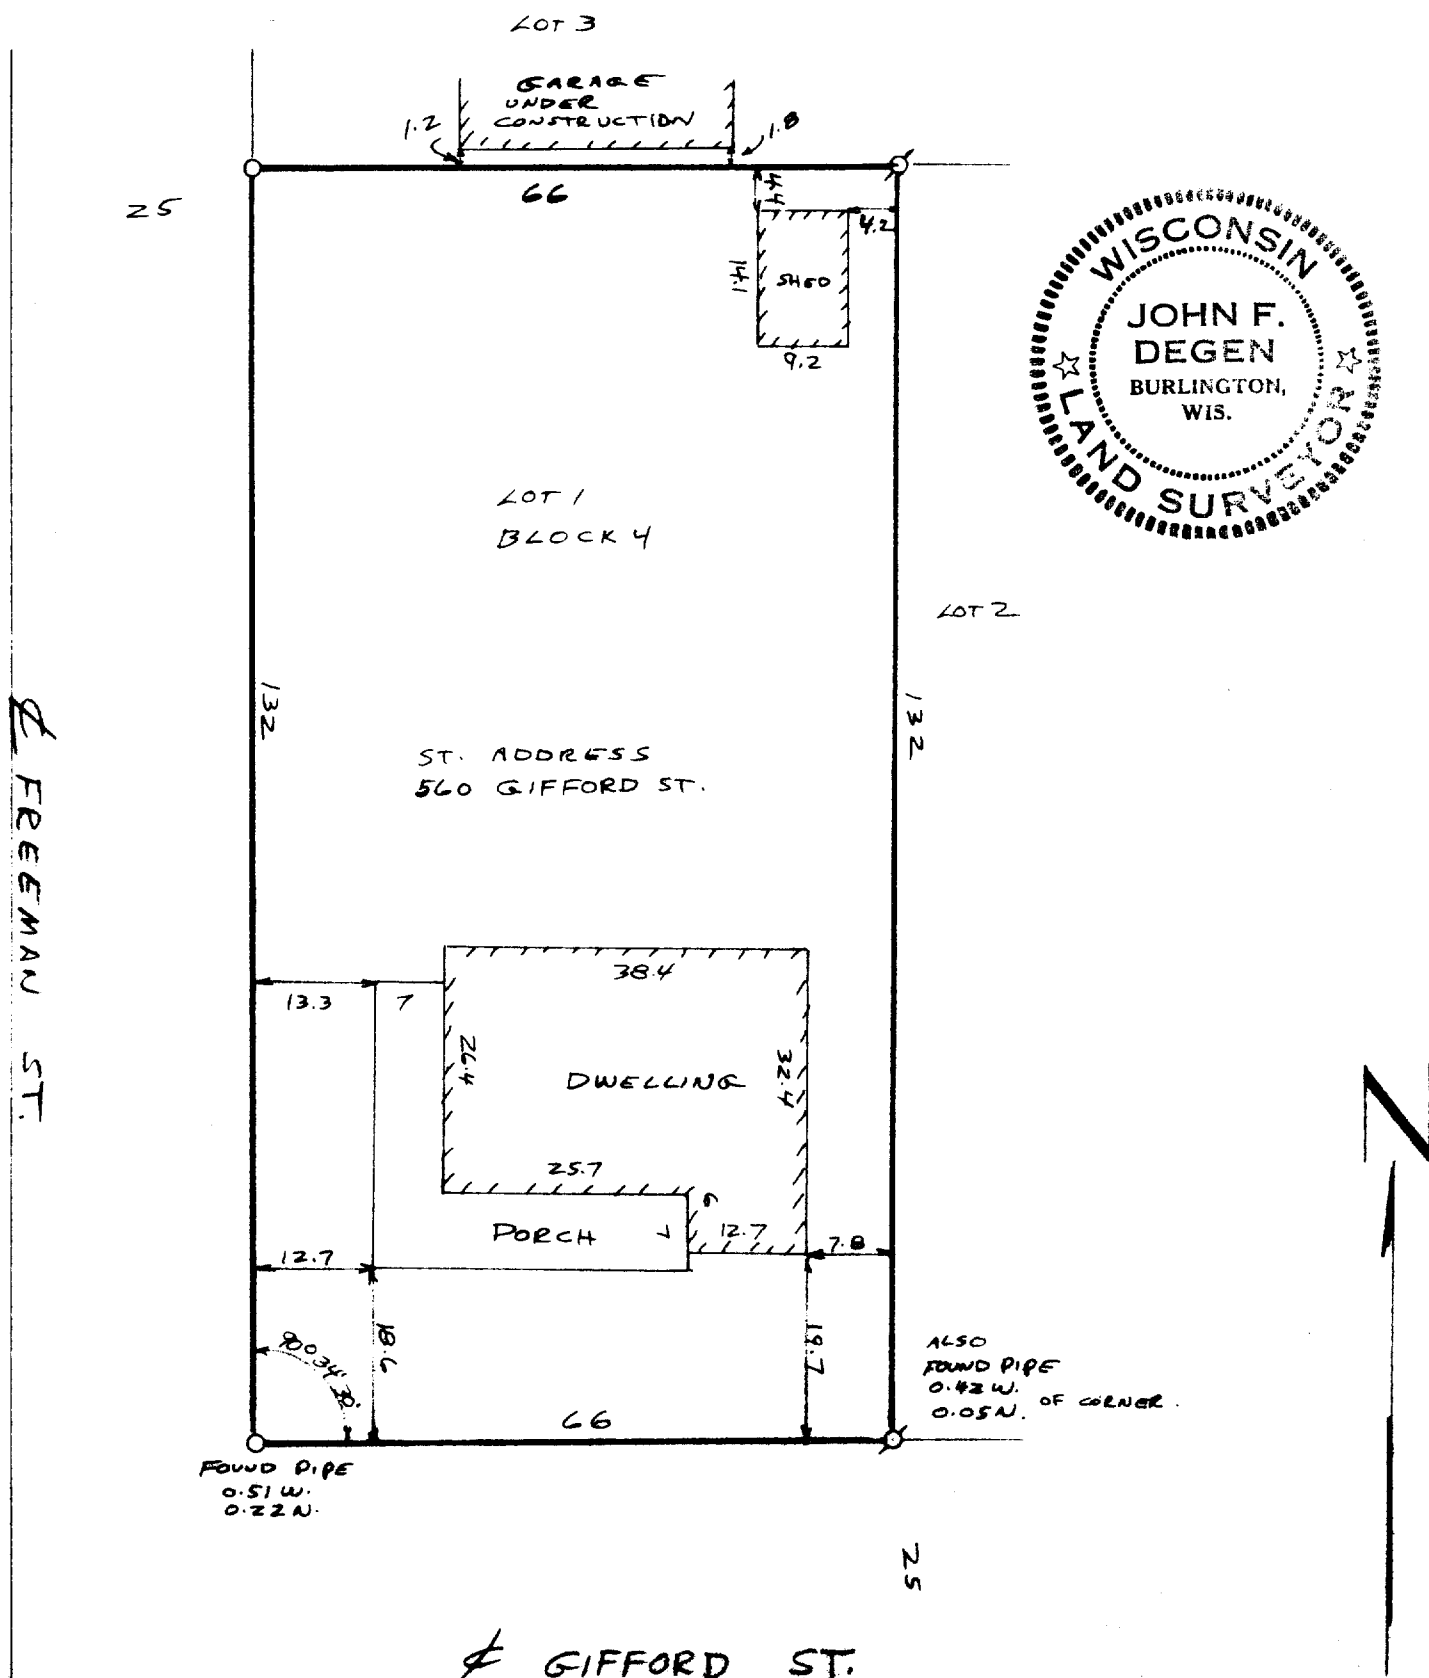

14-17-2

447

TG-26

6-153