



ROBERTS & BOYD, INC.
CONSULTING ENGINEERS
LAND SURVEYORS


109 SOUTH SPRING STREET
BURLINGTON, WISCONSIN 53105
PHONE: 414-763-7834

PLAT OF SURVEY
FOR
FIRST STATE SAVINGS OF WISCONSIN
OF

Lot One (1), except the North Five (5) feet thereof of Certified Survey Map No. 178, located in the Northeast One-quarter (1/4) of Section Thirty-five (35) in Township One (1) North, Range Eighteen (18) East, in the Village of Genoa City, recorded on October 3, 1972, in Volume 1 of Certified Survey Maps at page 178 as Document No. 655570. Together with an easement for ingress and egress by foot, vehicle or animal over the following described real estate: An easement 8.00 feet in width being a part of Lot 1 of Certified Survey Map No. 178 and part of the Northeast 1/4 of Section 35, Township 1 North, Range 18 East, Village of Genoa City, Walworth County, Wisconsin, and described as follows: Commencing at the Northeast corner of said Section 35; thence South 1501.97 feet to the place of beginning; thence North 89°30' West 206.25 feet; thence North 8.00 feet; thence South 89°39' East 206.25 feet; thence South 8.00 feet to the place of beginning.

OWNER:

Randall L. and JoAnne L. Coulman
637 Carter Street
Genoa City, WI 53128

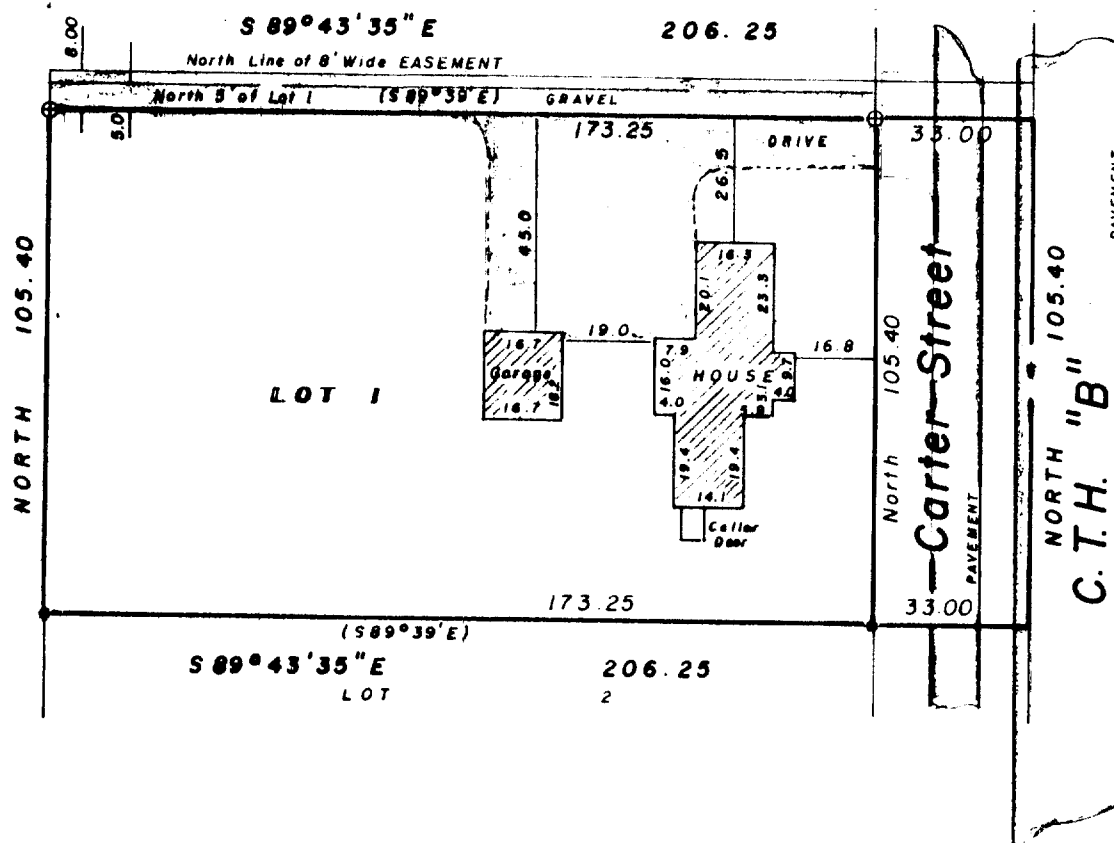

BEARING BASED ON
C. S. M. 178

LEGEND

- + CHISEL CUT IN CONCRETE
- o PK NAIL
- FOUND IRON PIPE - 1"
- FOUND IRON PIPE -
- SET IRON PIPE -
- FOUND BRASS CAPPED MONUMENT
- ⊕ FOUND CONCRETE MONUMENT 6"
- FENCE
- () RECORDED AS
- EXISTING GROUND ELEVATION

SCALE - 1" = 40'

"I hereby certify that I have surveyed the above described property and that the above map is a true representation thereof and shows the size and location of the property, its exterior boundaries, the location of all visible structures and dimensions of all principal buildings thereon, boundary fences, apparent easements, roadways and visible encroachments, if any

"This survey is made for the use of the present owners of the property, and also those who purchase, mortgage, or guarantee the title thereto within one year from date hereof"

NO MONUMENTATION HAS BEEN WAIVED IN ACCORDANCE WITH A-E 5.01(b) OF THE WISCONSIN ADMINISTRATIVE CODE.



Kenneth R. Reesman
WISCONSIN REGISTERED LAND SURVEYOR

7-5-84
DATE

FIELD WORK BY Krr

DRAWN BY Krr

84167
JOB NUMBER