


PLAT OF SURVEY
OF
THE SOUTH 99 FEET OF LOT 8, BLOCK 2 OF STRAIN'S ADDITION TO THE VILLAGE OF GENOA CITY,
WALWORTH COUNTY, WISCONSIN.

FOR: HAROLD LONG

SCALE 1" = 50'

• - IRON PIPE STAKE SET.

⊕ - IRON STAKE FOUND OF TYPE
NOTED ON PLAT.

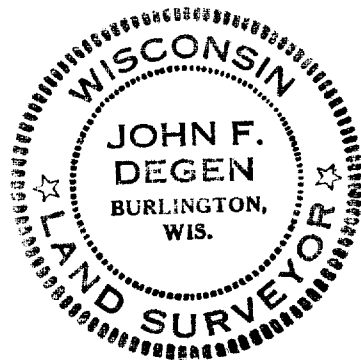

I have surveyed the above-described property
and the map hereon is a true representation
thereof and shows the size and location of the
property, its exterior boundaries, the location
and dimensions of all visible structures, the
fences, apparent easements and roadways and
visible encroachments, if any.


This survey is made for the exclusive use of
the present owners of the property, and binds
those who purchase, mortgage or guarantee
the title thereto, within one year from date
hereof.

Dated at Burlington, this 26th day
of SEPT. 1984

John F. Degen
John F. Degen, Land Surveyor S 242

WALWORTH ST.

WISCONSIN ST.

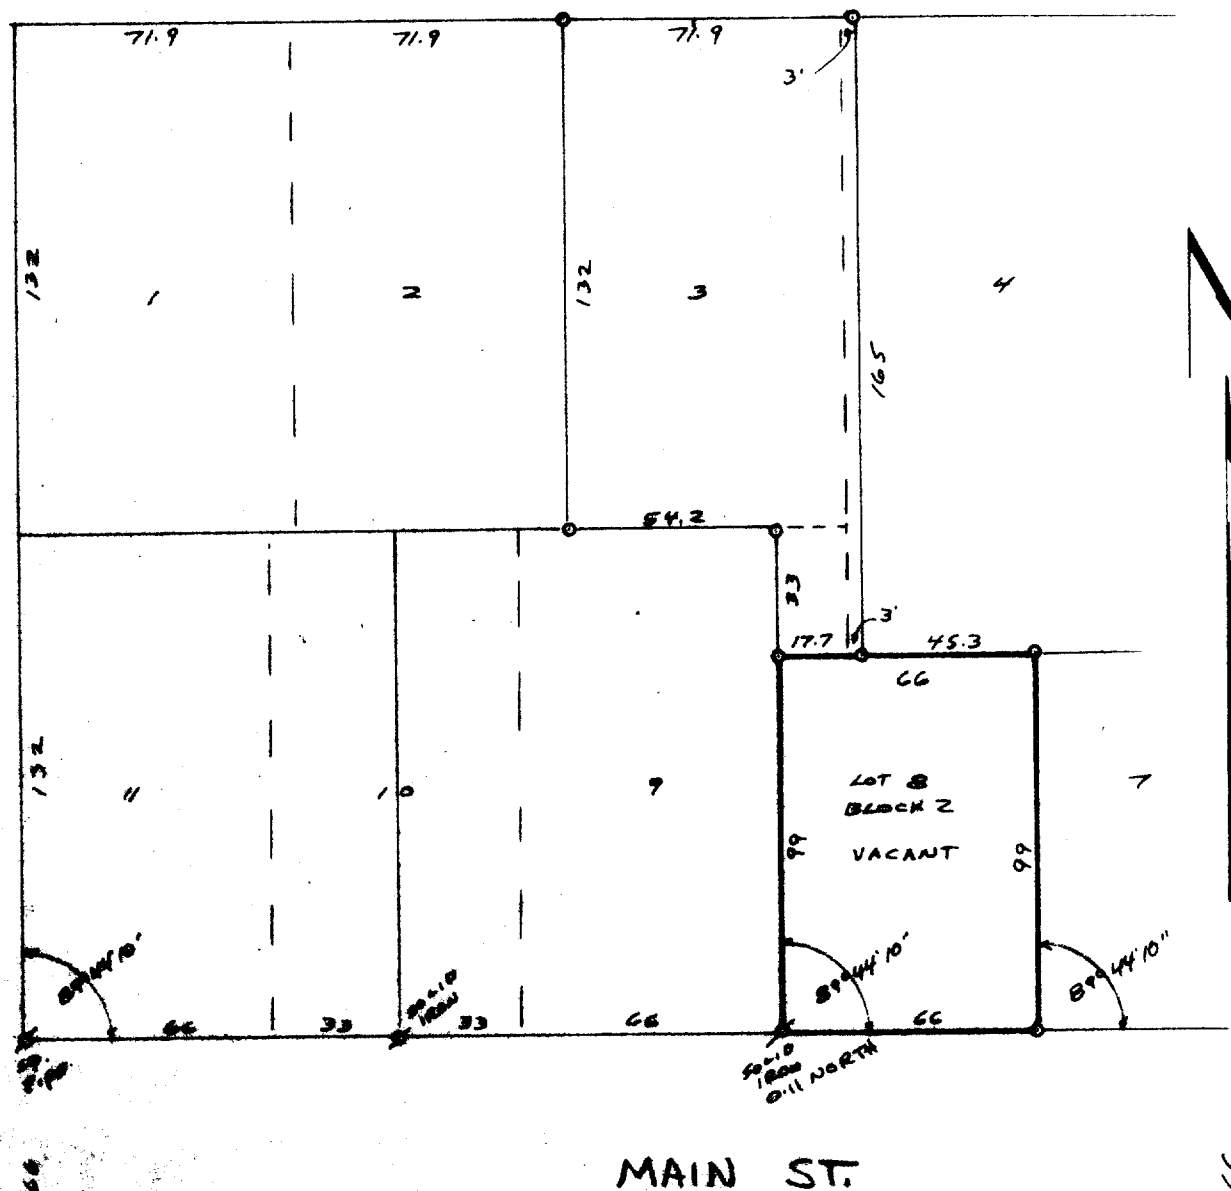

MAIN ST.

6-158