



PLAT OF SURVEY
OF

LOT 7, BLOCK 2, STRAIN'S ADDITION, VILLAGE OF GENOA CITY, WALWORTH COUNTY, WISCONSIN.

FOR: HAROLD LONG

SCALE 1" = 20'

o = IRON PIPE STAKE SET.

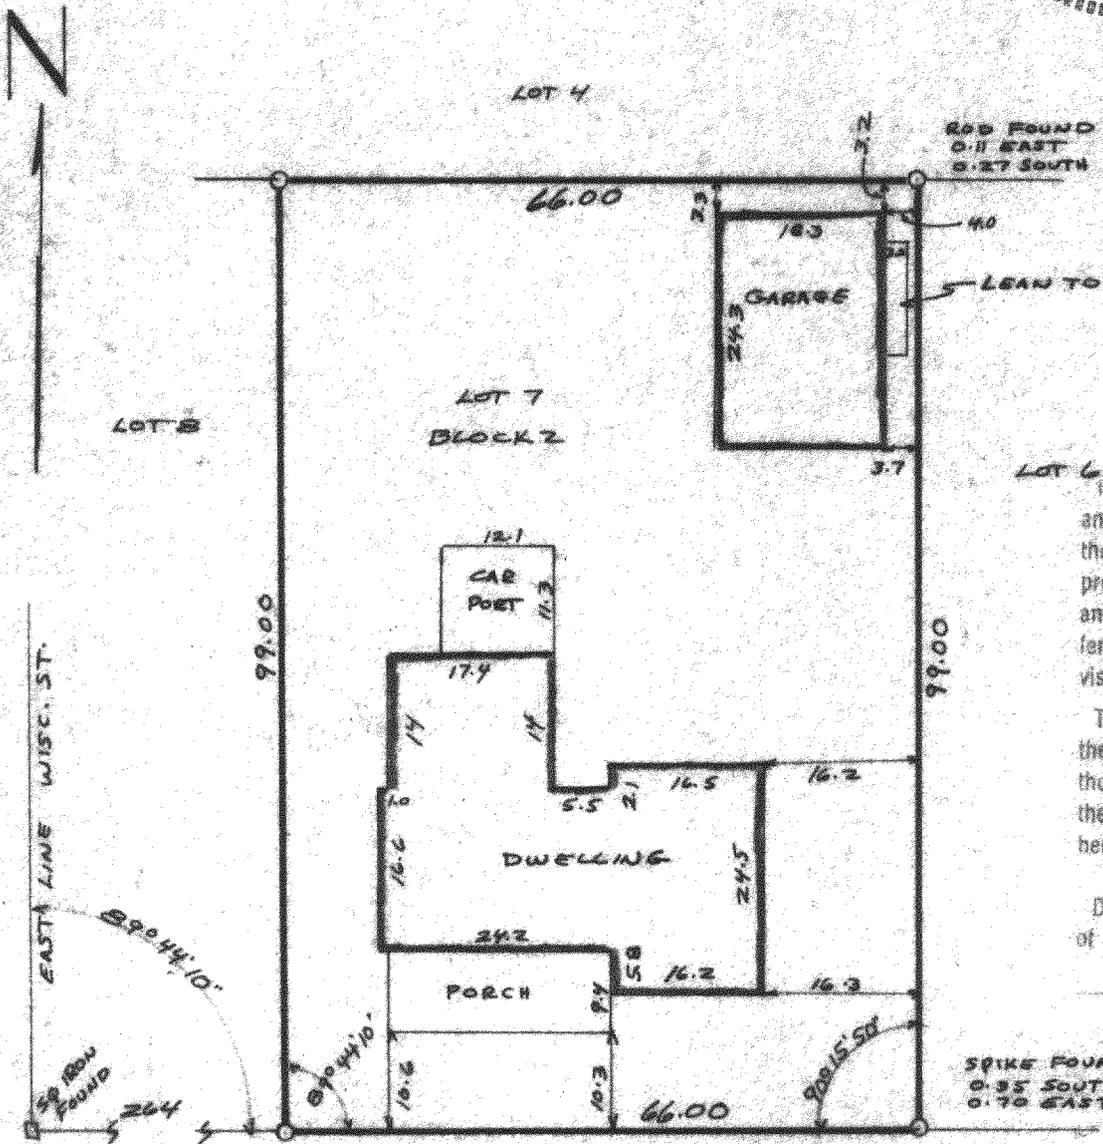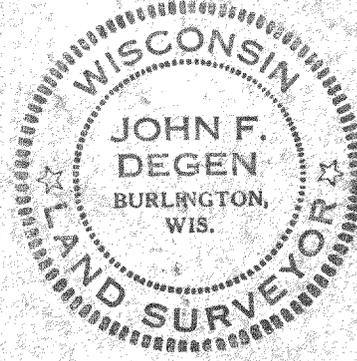

I have surveyed the above-described property, and the map hereon is a true representation thereof and shows the size and location of the property, its exterior boundaries, the location and dimensions of all visible structures thereon, fences, apparent easements and roadways and visible encroachments, if any.

This survey is made for the exclusive use of the present owners of the property, and also those who purchase, mortgage, or guarantee the title thereto, within one year from date hereof.

Dated at Burlington, this 26th day of SEPT. 1984

John F. Degen
John F. Degen, Land Surveyor 242

SPIKE FOUND
0.35 SOUTH
0.70 EAST

E MAIN ST.

TS-00013

6-160