


KOLB LAND CONSULTING, INC.  
LAND SURVEYING • SUBDIVIDING • LAND PLANNING

LAKE GENEVA, WISCONSIN 53147

MAIN STREET

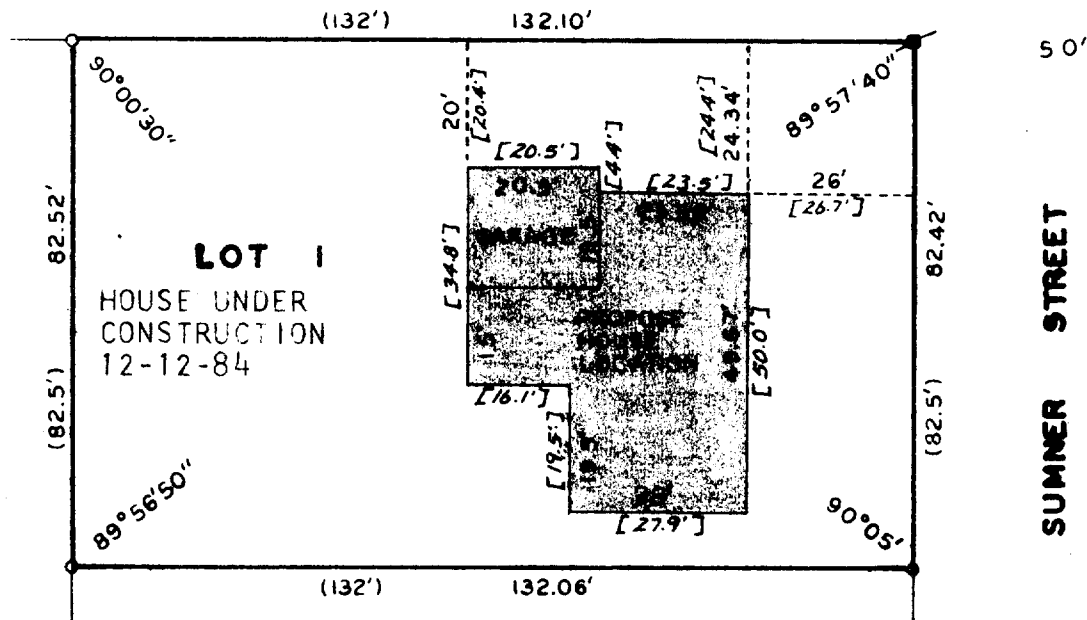

PLAT OF SURVEY OF

LOT 1 OF CAREYS ADDITION TO GENOA CITY, T1N, R18E,  
WALWORTH COUNTY, WISCONSIN.

ORDERED BY: ROBERT GIBSON

NOTE: WOOD STAKES SET AT ALL HOUSE CORNERS.

12-12-84 - RELOCATED PROPERTY CORNERS.  
ORDERED BY: NORTH SHORE SAVINGS & LOAN  
MILWAUKEE, WI



SCALE - 1"=30'

LEGEND

- IRON PIPE SET
- IRON BAR FOUND
- ( ) RECORDED AS
- [ ] MEASUREMENTS TAKEN

I HEREBY CERTIFY THAT I HAVE SURVEYED THE ABOVE DESCRIBED PROPERTY AND THAT THE ABOVE MAP IS A TRUE REPRESENTATION THEREOF AND SHOWS THE SIZE AND LOCATION OF THE PROPERTY, ITS EXTERIOR BOUNDARIES, THE LOCATION OF ALL VISIBLE STRUCTURES AND DIMENSIONS OF ALL PRINCIPAL BUILDINGS THEREON, BOUNDARY FENCES, APPARENT EASEMENTS, ROADWAYS AND VISIBLE ENCROACHMENTS, IF ANY.  
THIS SURVEY IS MADE FOR THE USE OF THE PRESENT OWNERS OF THE PROPERTY, AND ALSO THOSE WHO PURCHASE, MORTGAGE, OR GUARANTEE THE TITLE THERETO WITHIN ONE (1) YEAR FROM DATE HEREOF.

*Harold H. Kolb*  
HAROLD H. KOLB

WISCONSIN REGISTERED LAND SURVEYOR, S-187

DATE Oct. 9, 1984  
REVISED: DEC. 12, 1984

166

TC-1

G.C. TC-1