

PLAT OF SURVEY

OF


LOT 1, BLOCK 3, J. H. ROME'S ADDITION TO THE VILLAGE OF GENEVA CITY, ACCORDING TO THE RECORDED PLAT THEREOF, LOCATED IN THE NORTHEAST 1/4 OF SECTION 35, T. 1 N., R. 18 E. OF THE 4TH P.M., VILLAGE OF GENEVA CITY, COUNTY OF WAJIMORTH, STATE OF WISCONSIN.

FOR: ALBERT DAUM

SCALE 1" = 30'

o = IRON PIPE STAKE
BEARINGS RELATES TO THE
EAST LINE OF BLOCK 3
WHICH WAS ASSIGNED AS
SOUTH.

ST. ADDRESS: 561 WISCONSIN ST.

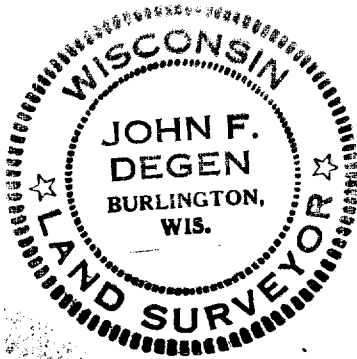


I have surveyed the above-described property and the map hereon is a true representation thereof and shows the size and location of the property, its exterior boundaries, the location and dimensions of all visible structures thereon, fences, apparent easements and roadways and visible encroachments, if any.

This survey is made for the exclusive use of the present owners of the property, and also those who purchase, mortgage, or guarantee the title thereto, within one year from date hereof.

Dated at Burlington, this 10th day of JUNE, 1935

John F. Degen
John F. Degen, Land Surveyor S 202

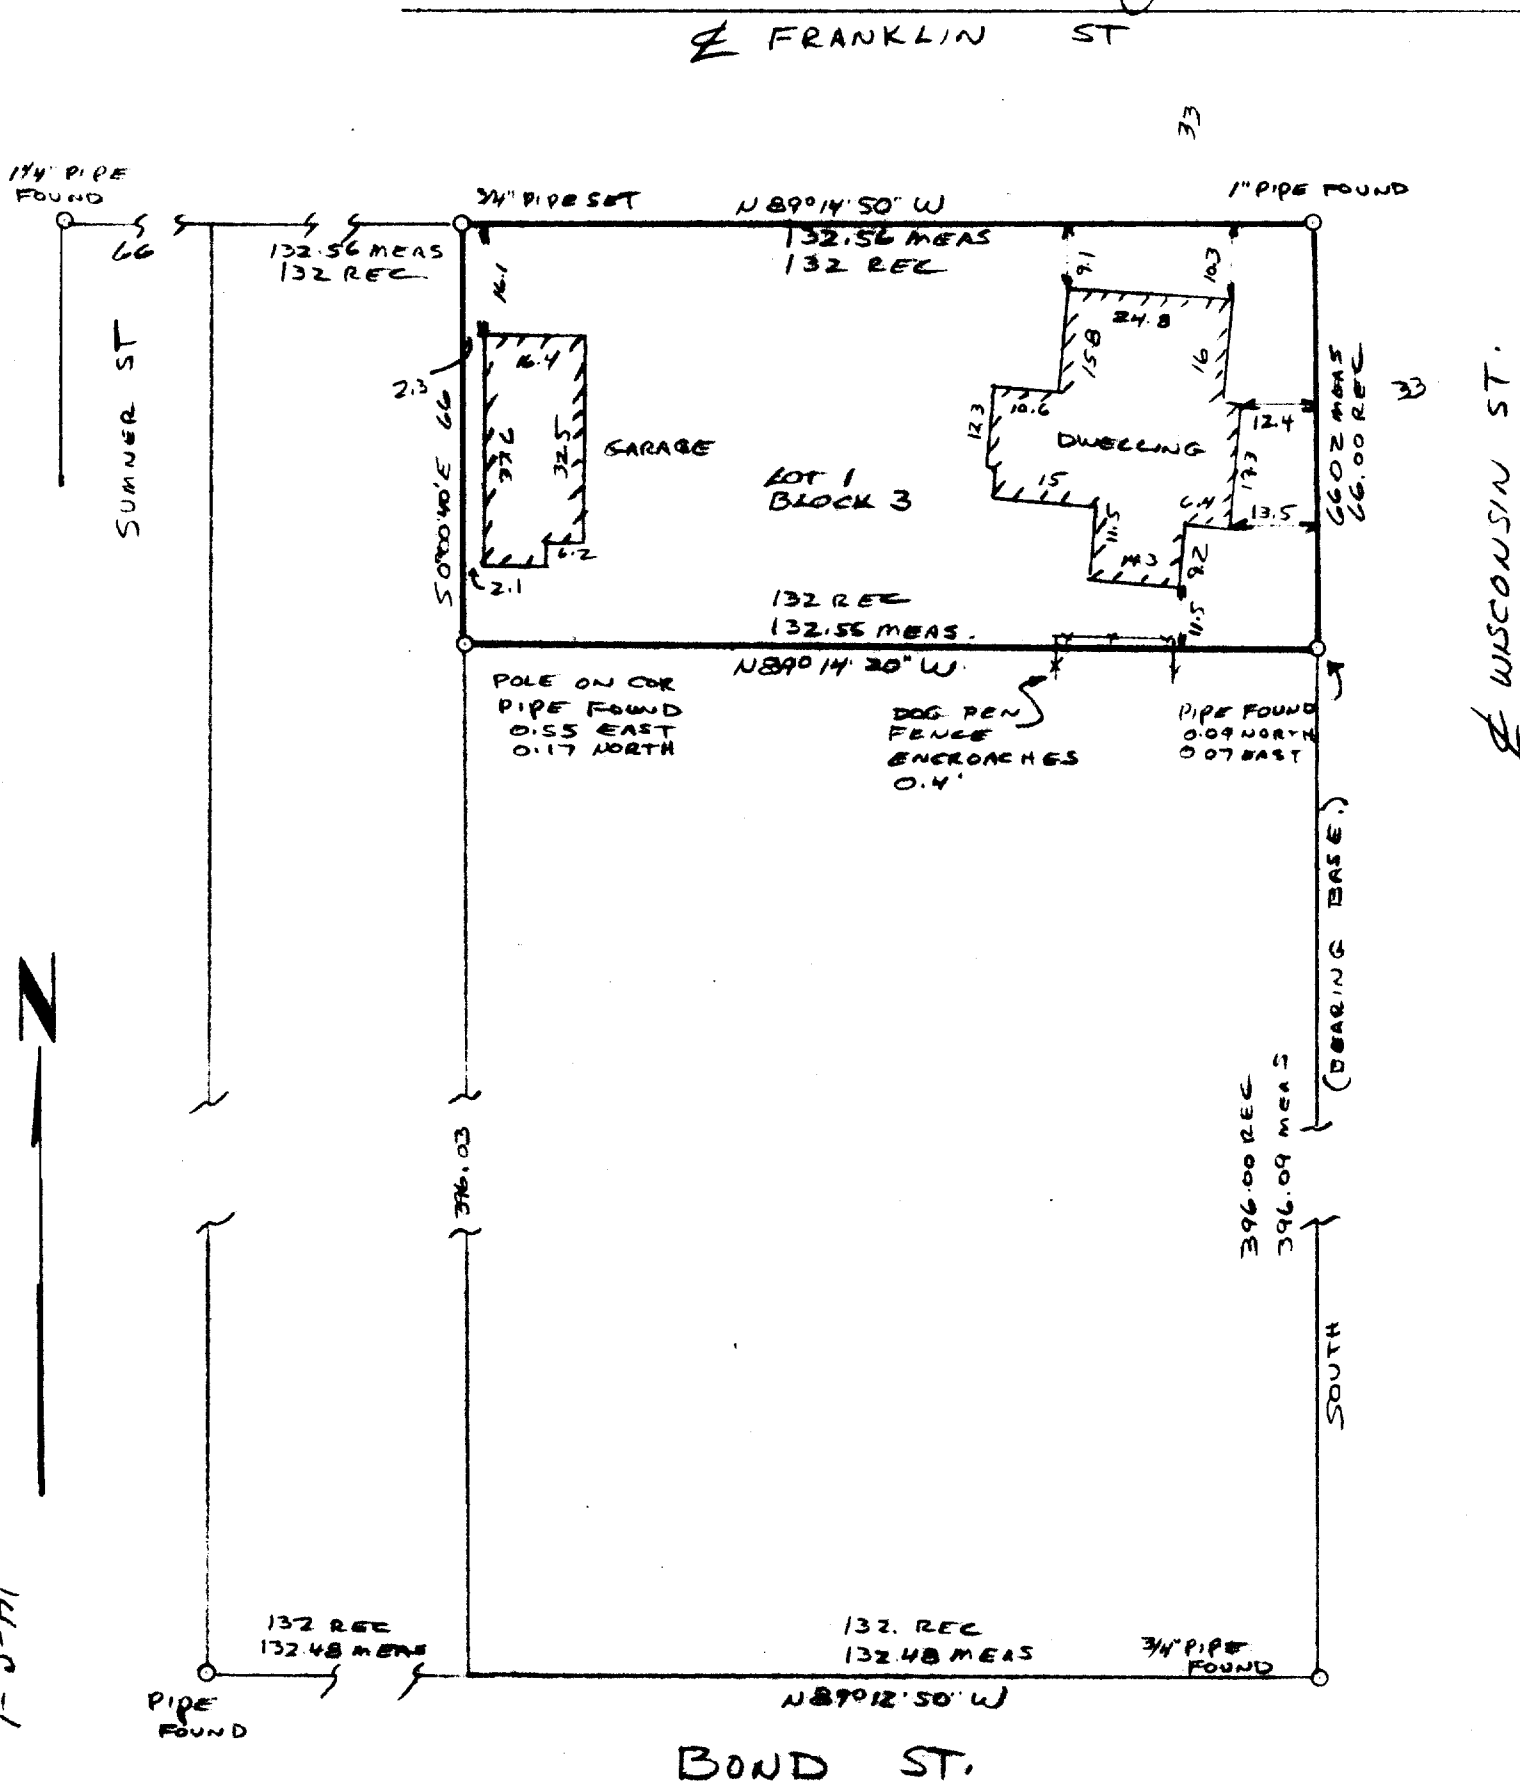

14-2-1
117

TR-1X

6-167