



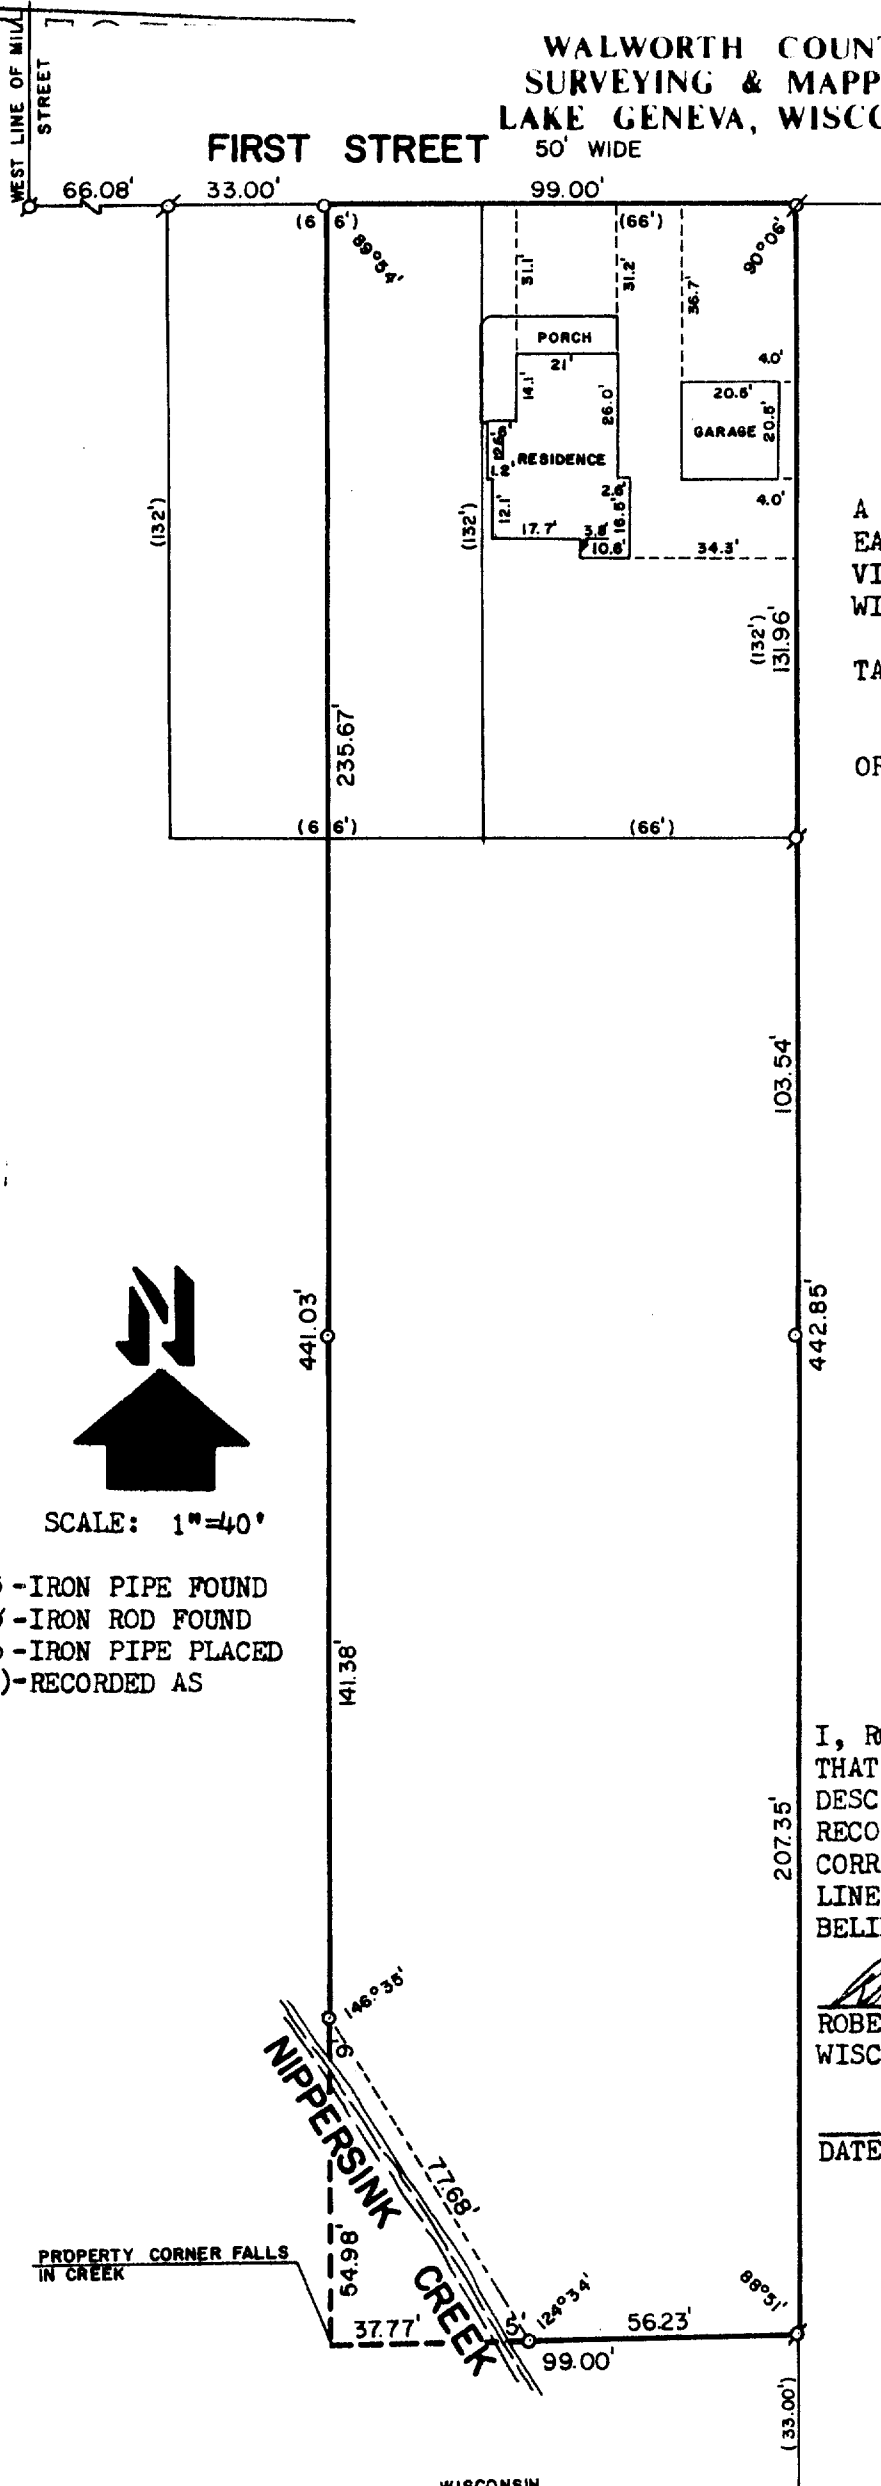

WALWORTH COUNTY
SURVEYING & MAPPING
LAKE GENEVA, WISCONSIN

FIRST STREET

50' WIDE

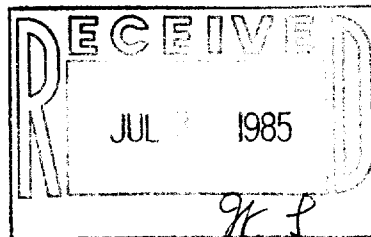


PLAT OF SURVEY OF

A PARCEL OF LAND LOCATED IN THE SOUTH-
EAST 1/4 OF SECTION 35, T 1 N, R 18 E,
VILLAGE OF GENOA CITY, WALWORTH COUNTY,
WISCONSIN.

TAX KEY NO.: TVGC-67
TVGC-68

ORDERED BY: COLDWELL BANKER, GENEVA
LAKES AREA REALTORS
838 MAIN STREET
LAKE GENEVA, WISCONSIN

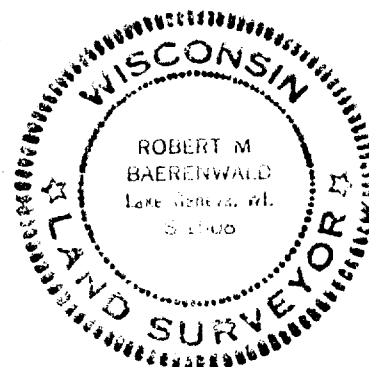

I, ROBERT M. BAERENWALD, DO HEREBY CERTIFY
THAT I HAVE SURVEYED THE PROPERTY HEREON
DESCRIBED ACCORDING TO THE OFFICIAL
RECORDS AND THAT THE PLAT HEREON IS A
CORRECT REPRESENTATION OF THE PROPERTY
LINES TO THE BEST OF MY KNOWLEDGE AND
BELIEF.

Robert M. Baerenwald
ROBERT M. BAERENWALD
WISCONSIN REGISTERED LAND SURVEYOR S-1508

DATE

JULY 3, 1984
JOB NO. 0085

6-168