



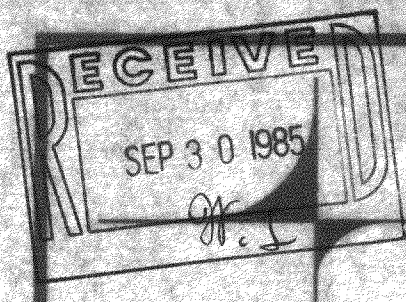

KOLB LAND CONSULTING, INC.
LAND SURVEYING • SUBDIVIDING • LAND PLANNING


929 WILLIAMS STREET LAKE GENEVA, WISCONSIN 53147 414-248-3697

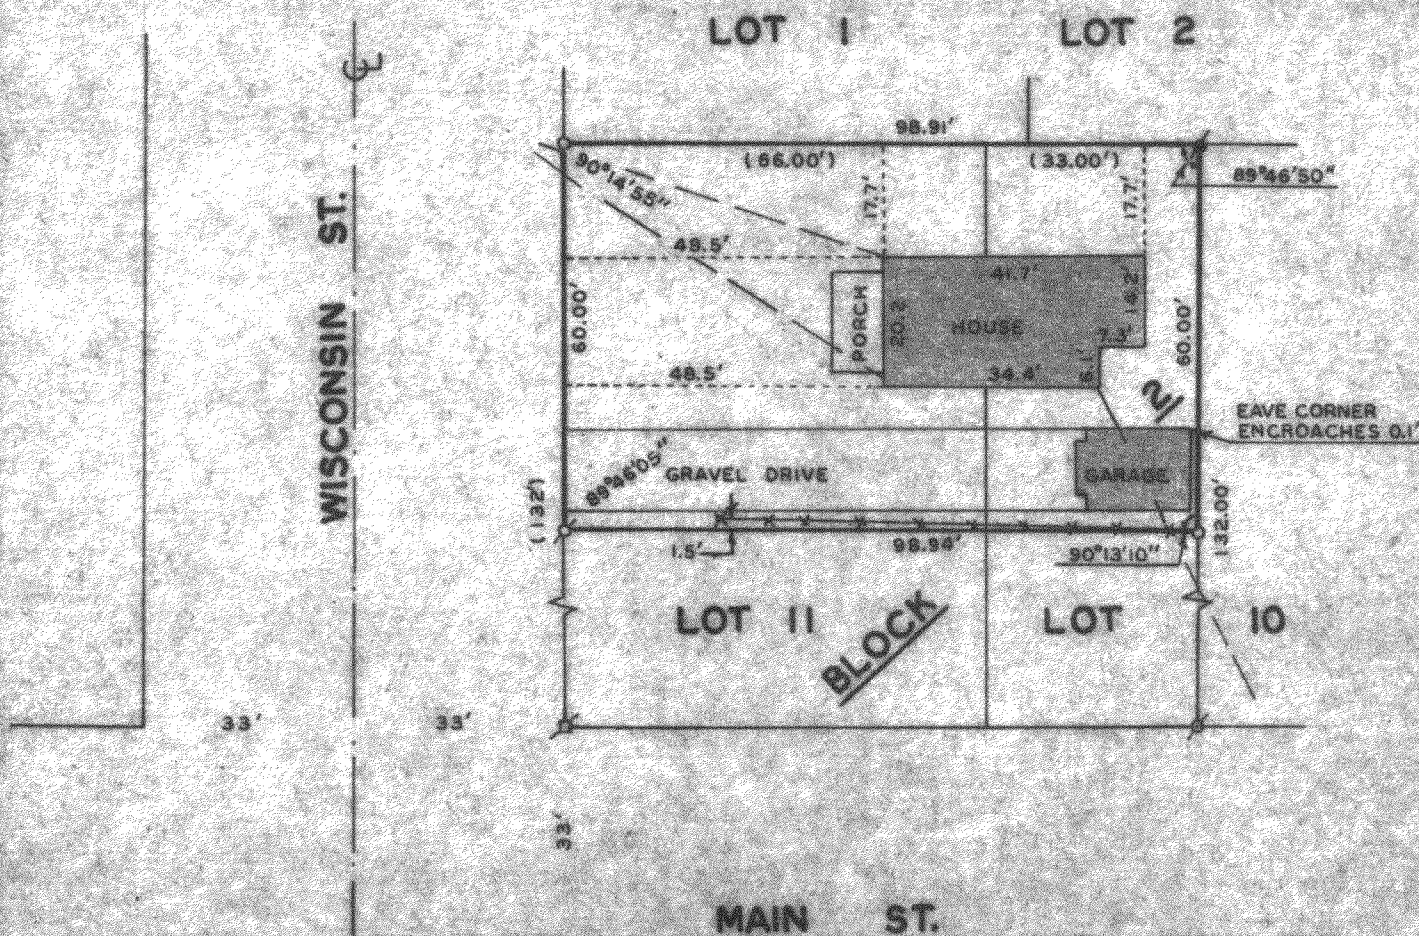

PLAT OF SURVEY OF


THE NORTH 60', OF THE WEST 1/2 OF LOT 10 AND THE NORTH 60'
OF LOT 11, BLOCK 2 OF STRAIN'S ADDITION, VILLAGE OF GENDA,
WALWORTH COUNTY, WISCONSIN.

OWNER: VINCENT THOMAS DOMINO

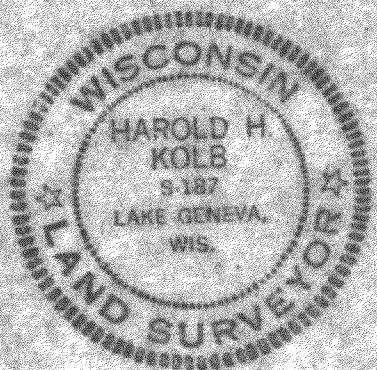

I HEREBY CERTIFY THAT I HAVE SURVEYED THE
ABOVE DESCRIBED PROPERTY AND THAT THE ABOVE
MAP IS A TRUE REPRESENTATION THEREOF AND
SHOWS THE SIZE AND LOCATION OF THE PROPERTY,
ITS EXTERIOR BOUNDARIES, THE LOCATION OF ALL
VISIBLE STRUCTURES AND DIMENSIONS OF ALL
PRINCIPAL BUILDINGS THEREON, BOUNDARY FENCES,
APPARENT EASEMENTS, ROADWAYS AND VISIBLE
ENCROACHMENTS, IF ANY, TO THE BEST OF MY
KNOWLEDGE AND BELIEF.

THIS SURVEY IS MADE FOR THE USE OF THE
PRESENT OWNERS OF THE PROPERTY, AND ALSO
THOSE WHO PURCHASE, MORTGAGE, OR GUARANTEE
THE TITLE THERETO WITHIN ONE (1) YEAR FROM
DATE HEREOF.

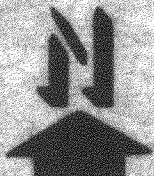

SCALE 1" = 30'

LEGEND

- ✕ IRON PIPE FOUND
- IRON PIPE SET
- ✕ IRON ROD FOUND
- () RECORDED AS
- OVERHEAD UTILITY LINES
- SQ. HOLLOW BAR FOUND

HAROLD H. KOLB

WISCONSIN REGISTERED LAND SURVEYOR, S-187

DATE APRIL 19, 1985

REVISED

REVISED

TS-00016

6-173