

PLAT OF SURVEY

THE SOUTH 43.75 FEET OF LOT 9 AND THE NORTH 11.25 FEET OF LOT 12 IN THE VILLAGE OF GENOA, A PLAT OF RECORD, LOCATED IN THE VILLAGE OF GENOA CITY, WALWORTH COUNTY, WISCONSIN.

FOR: LARRY HODGES CENTURY 21 REALTY
SCALE 1" = 30'
X = IRON PIPE STAKE FOUND.
O = IRON PIPE STAKE SET.
• = RAILROAD SPIKE SET.



I have surveyed the above-described property, and the map hereon is a true representation thereof and shows the size and location of the property, its exterior boundaries, the location and dimensions of all visible structures thereon, fences, apparent easements and roadways and visible encroachments, if any.

This survey is made for the exclusive use of the present owners of the property, and also those who purchase, mortgage, or guarantee the title thereto, within one year from date hereof.


Dated at Burlington, this 23RD day

OCTOBER 1985

John F. Degen
John F. Degen, Land Surveyor S 242

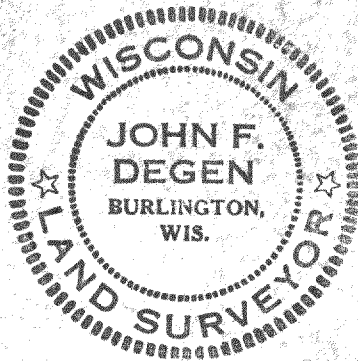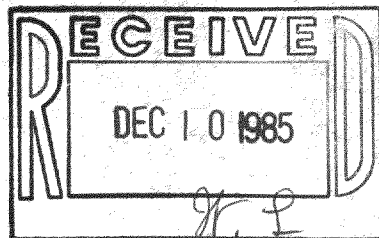

THIS SURVEY IS A RETRACEMENT OF A 1972 SURVEY OF SAME LANDS BY GEO. DUNHAM S306

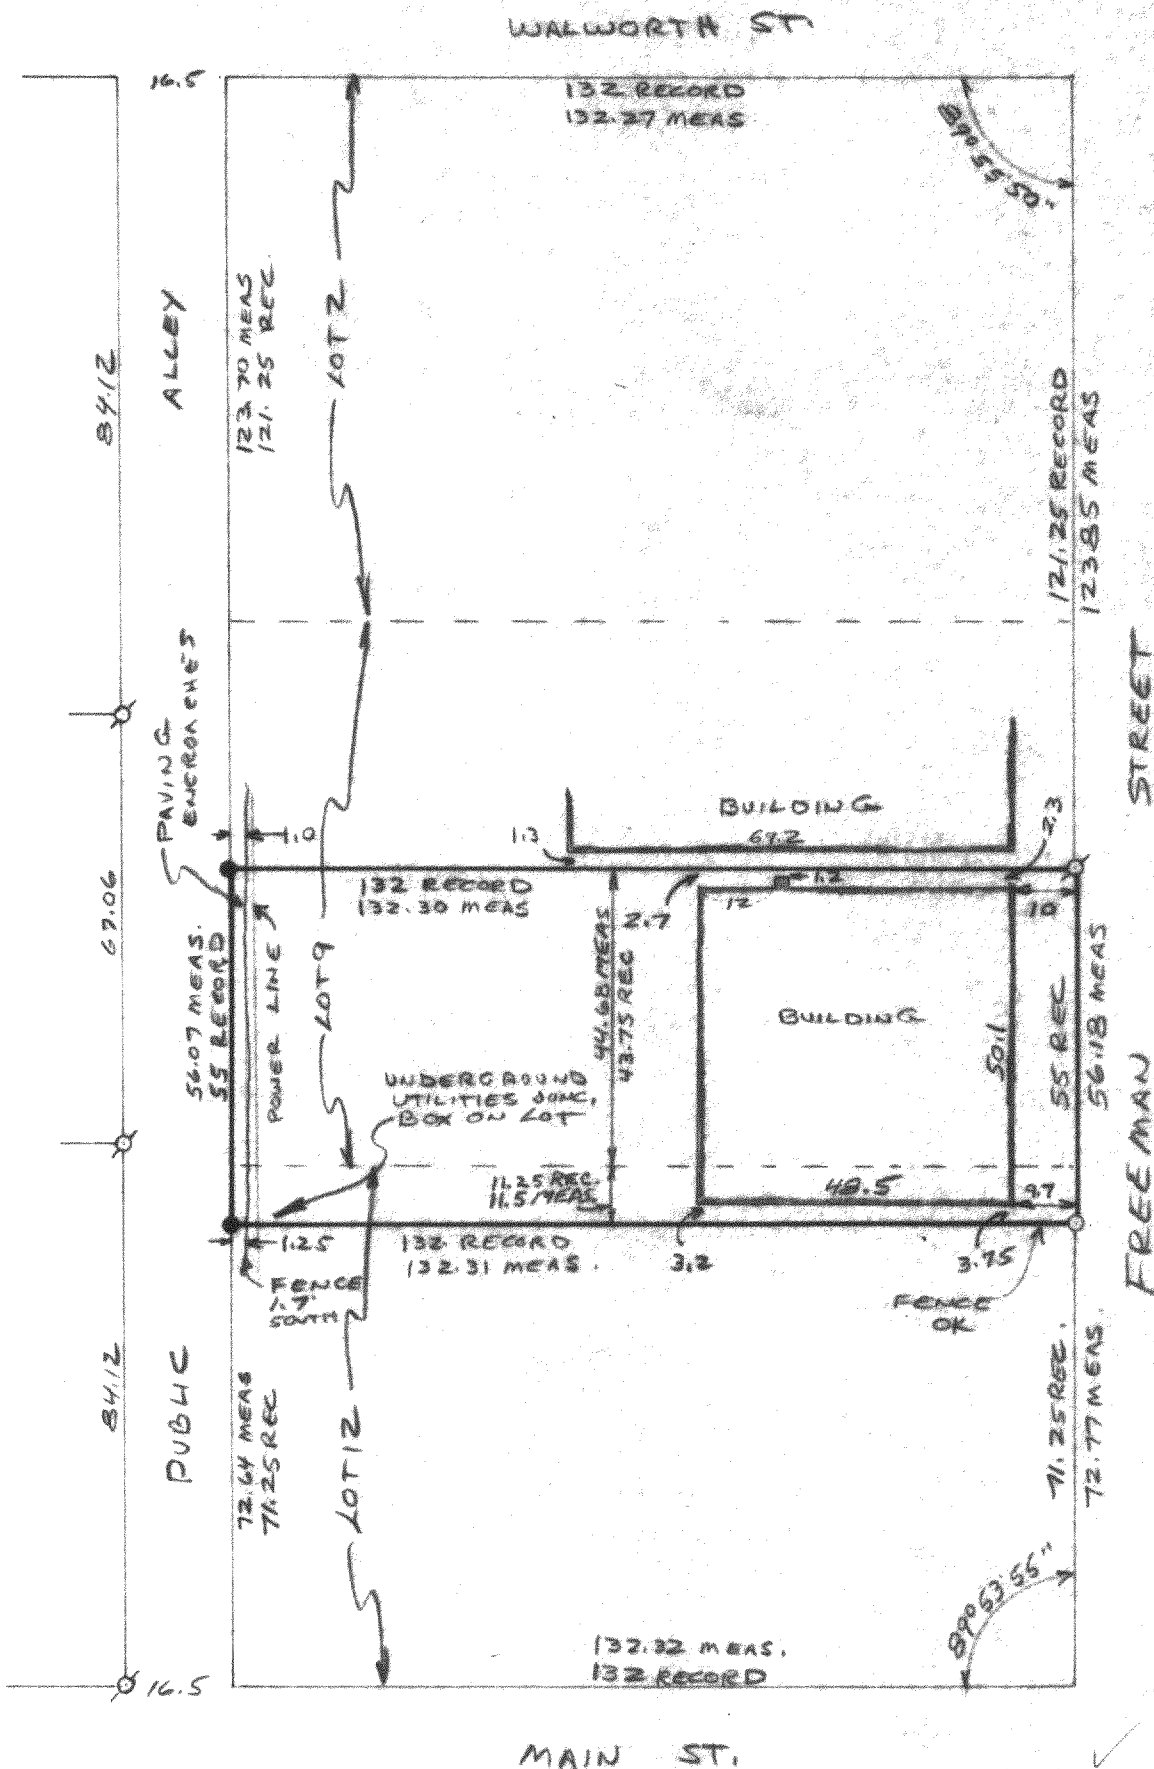

12-D #34

TOP-17

MAIN ST.

6-178