


PLAT OF SURVEY OF
 PART OF A PARCEL OF LAND LOCATED IN THE
 SOUTHEAST 1/4 OF THE SOUTHWEST 1/4 OF
 SECTION 35, T 1 N, R 18 E, VILLAGE OF
 GENOA CITY, WALWORTH COUNTY, WISCONSIN.

ORDERED BY: DOROTHY MARTIN
 BOX 477
 GENOA CITY, WI 53128

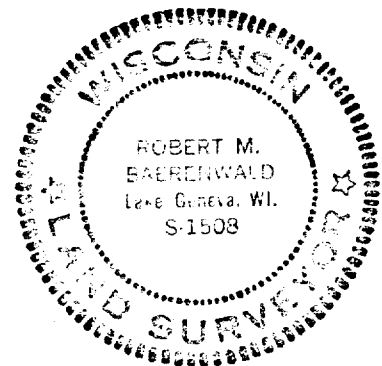


I, ROBERT M. BAERENWALD, DO HEREBY CERTIFY THAT I
 HAVE SURVEYED THE PROPERTY HEREON DESCRIBED ACCORDING
 TO THE OFFICIAL RECORDS AND THAT THE PLAT HEREON IS A
 CORRECT REPRESENTATION OF THE PROPERTY LINES TO THE
 BEST OF MY KNOWLEDGE AND BELIEF.

Robert M. Baerenwald
 ROBERT M. BAERENWALD
 WISCONSIN REGISTERED LAND SURVEYOR, S-1508


Oct. 7, 1985
 DATE JOB NO. 0414

TVG-59-1

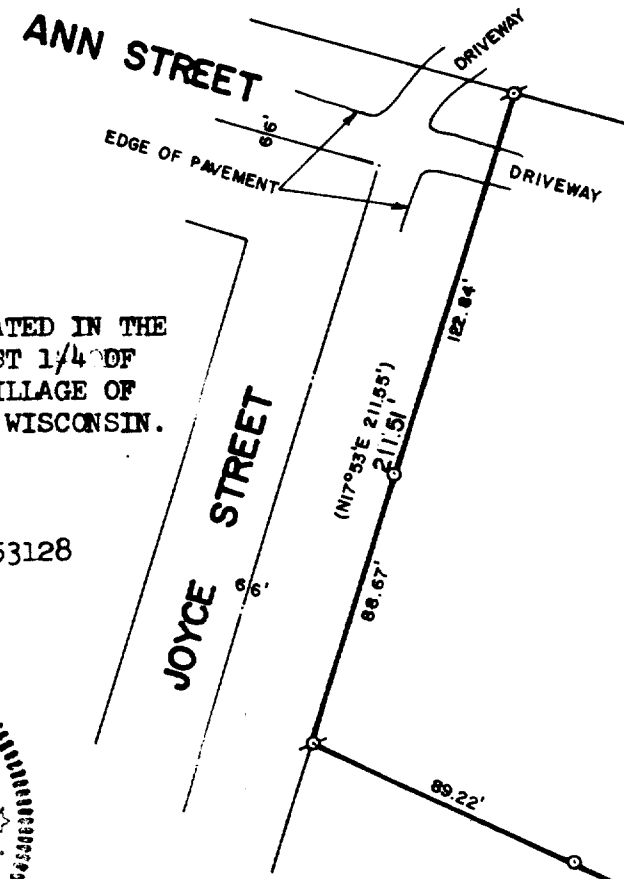

SCALE: 1"=60'

⊙ - IRON PIPE FOUND
 ○ - IRON ROD SET
 () - RECORDED AS

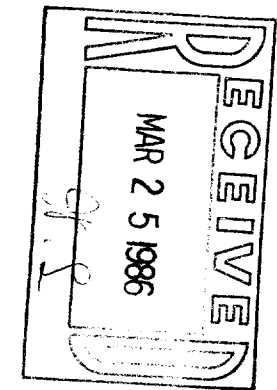

WALWORTH COUNTY
 SURVEYING & MAPPING
 LAKE GENEVA, WISCONSIN

AD81-9