


KOLB LAND CONSULTING, INC.

LAND SURVEYING • SUBDIVIDING • LAND PLANNING

LAKE GENEVA, WISCONSIN 53147

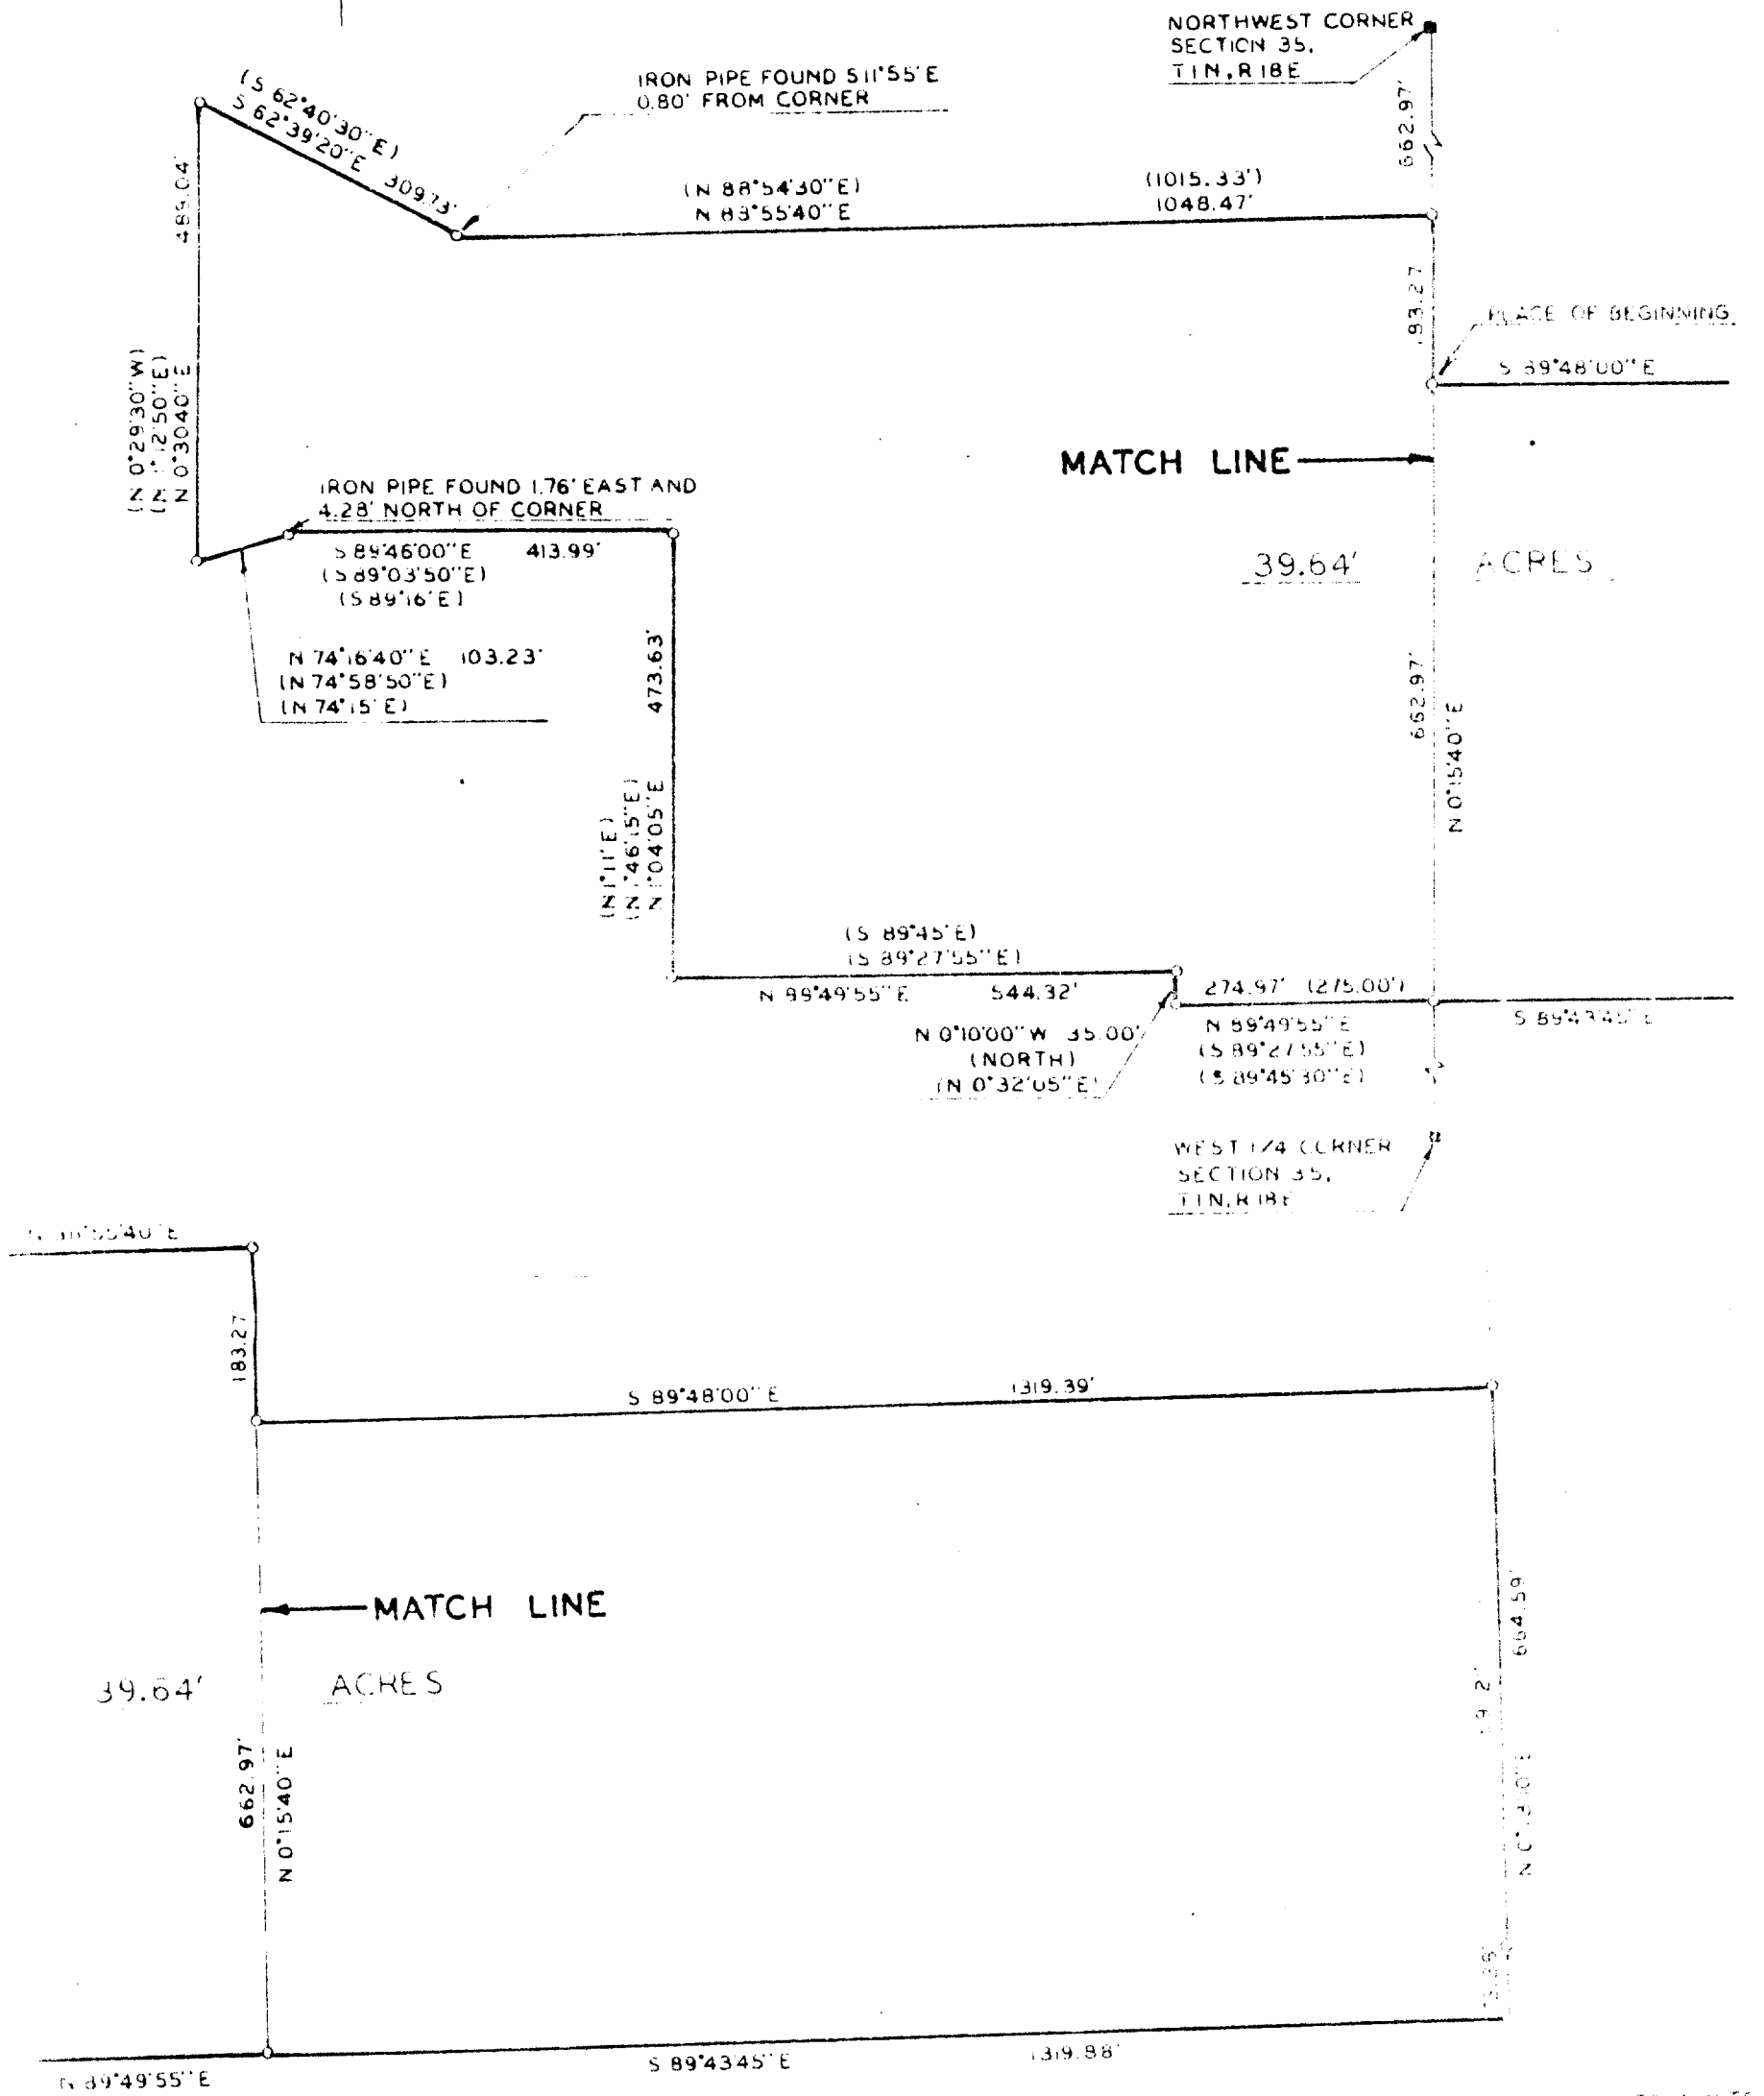


- IRON PIPE FOUND
- CONCRETE MONUMENT FOUND
- () RECORDED AS

HAROLD H. KOLB
WISCONSIN REGISTERED LAND SURVEYOR, S 14
DATE NOVEMBER 15, 1984

KOLB LAND CONSULTING, INC.

LAND SURVEYING • SUBDIVIDING • LAND PLANNING

LAKE GENEVA, WISCONSIN 53147

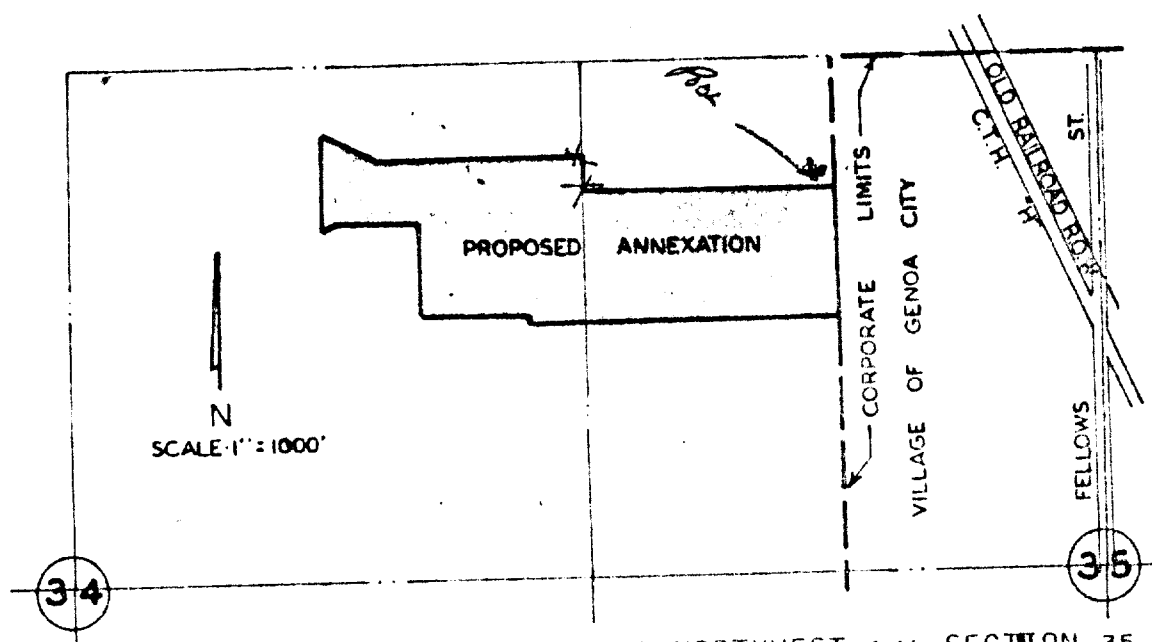

NORTHEAST 1/4 SECTION 34 AND NORTHWEST 1/4 SECTION 35,
TOWN 1 NORTH, RANGE 18 EAST, WALWORTH COUNTY, WISCONSIN.

PLAT OF SURVEY OF A PROPOSED ANNEXATION

LOCATED IN THE NORTHEAST 1/4 OF SECTION 34 AND THE NORTHWEST 1/4 OF SECTION 35, TOWN 1 NORTH, RANGE 18 EAST, WALWORTH COUNTY, WISCONSIN AND DESCRIBED AS FOLLOWS:

COMMENCING AT THE NORTHWEST CORNER OF SAID SECTION 35; THENCE S 0°15'40" W 662.97 FEET TO THE PLACE OF BEGINNING; THENCE S 89°48'00" E 1319.39 FEET; THENCE S 0°13'10" W 664.59 FEET; THENCE N 89°43'45" W 1319.88 FEET; THENCE S 89°49'55" W 274.97 FEET; THENCE N 0°10'00" W 35.00 FEET; THENCE S 89°49'55" W 544.32 FEET; THENCE N 1°04'05" E 473.63 FEET; THENCE N 89°46'00" W 413.99 FEET; THENCE S 74°16'40" W 103.23 FEET; THENCE N 0°30'40" E 489.04 FEET; THENCE S 62°39'20" E 309.73 FEET; THENCE N 88°55'40" E 1048.47 FEET; THENCE S 0°15'40" W 183.27 FEET TO THE PLACE OF BEGINNING, CONTAINING 39.64 ACRES.

NOTE: BEARINGS ARE ASSUMED FROM PREVIOUS SURVEY RECORDS

OWNER: WORKMEN'S BENEFIT RECREATION SOCIETY, INC.
C/O JAMES ARNOLD
133 NORTH ARDMORE
VILLA PARK, IL 60181

ORDERED BY: RANDALL LEECE
SWEET & LEECE
ELKHORN, WI 53121



I, HAROLD H. KOLB, DO HEREBY CERTIFY THAT I HAVE SURVEYED THE PROPERTY HEREON DESCRIBED ACCORDING TO THE OFFICIAL RECORDS, AND THAT THE PLAT HEREON IS A CORRECT REPRESENTATION OF THE LOT LINES TO THE BEST OF MY KNOWLEDGE AND BELIEF.

Harold H. Kolb
HAROLD H. KOLB

WISCONSIN REGISTERED LAND SURVEYOR. S-187