

PLAT OF SURVEY
OF



LOT 2, BLOCK 2, GIFFORD'S ADDITION TO GENOA JUNCTION, LOCATED IN THE VILLAGE OF GENOA
CITY, WALNORTH COUNTY, WISCONSIN.

FOR: ALLEN D. SCHNEIDER
SOUTHEASTERN SAVINGS
FOR TERRY SMITH 1786

SCALE 1" = 30'

o = IRON PIPE STAKE SET.

σ = IRON PIPE STAKE FOUND.

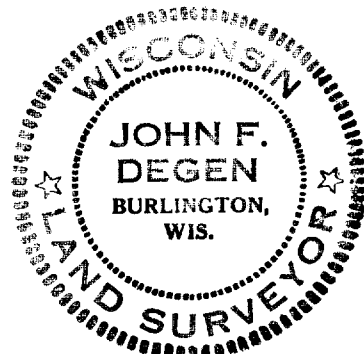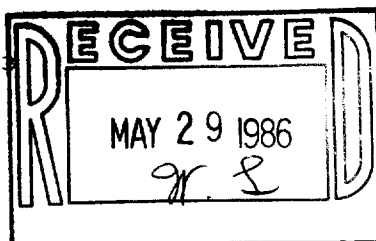


I have surveyed the above described property,
and the map hereon is a true representation
thereof and shows the size and location of the
property, its exterior boundaries, the location
and dimensions of all visible structures thereon,
fences, appurtenant easements and roadways and
visible encroachments, if any.

This survey is made for the exclusive use of
the present owners of the property, and also
those who purchase, mortgage, or guarantee
the title thereto, within one year from date
hereof.

Dated at Burlington, Wis. 21ST day
of DECEMBER, 1983.

John F. Degen
John F. Degen, Land Surveyor S 242
RE-SURVEY 5-5-86

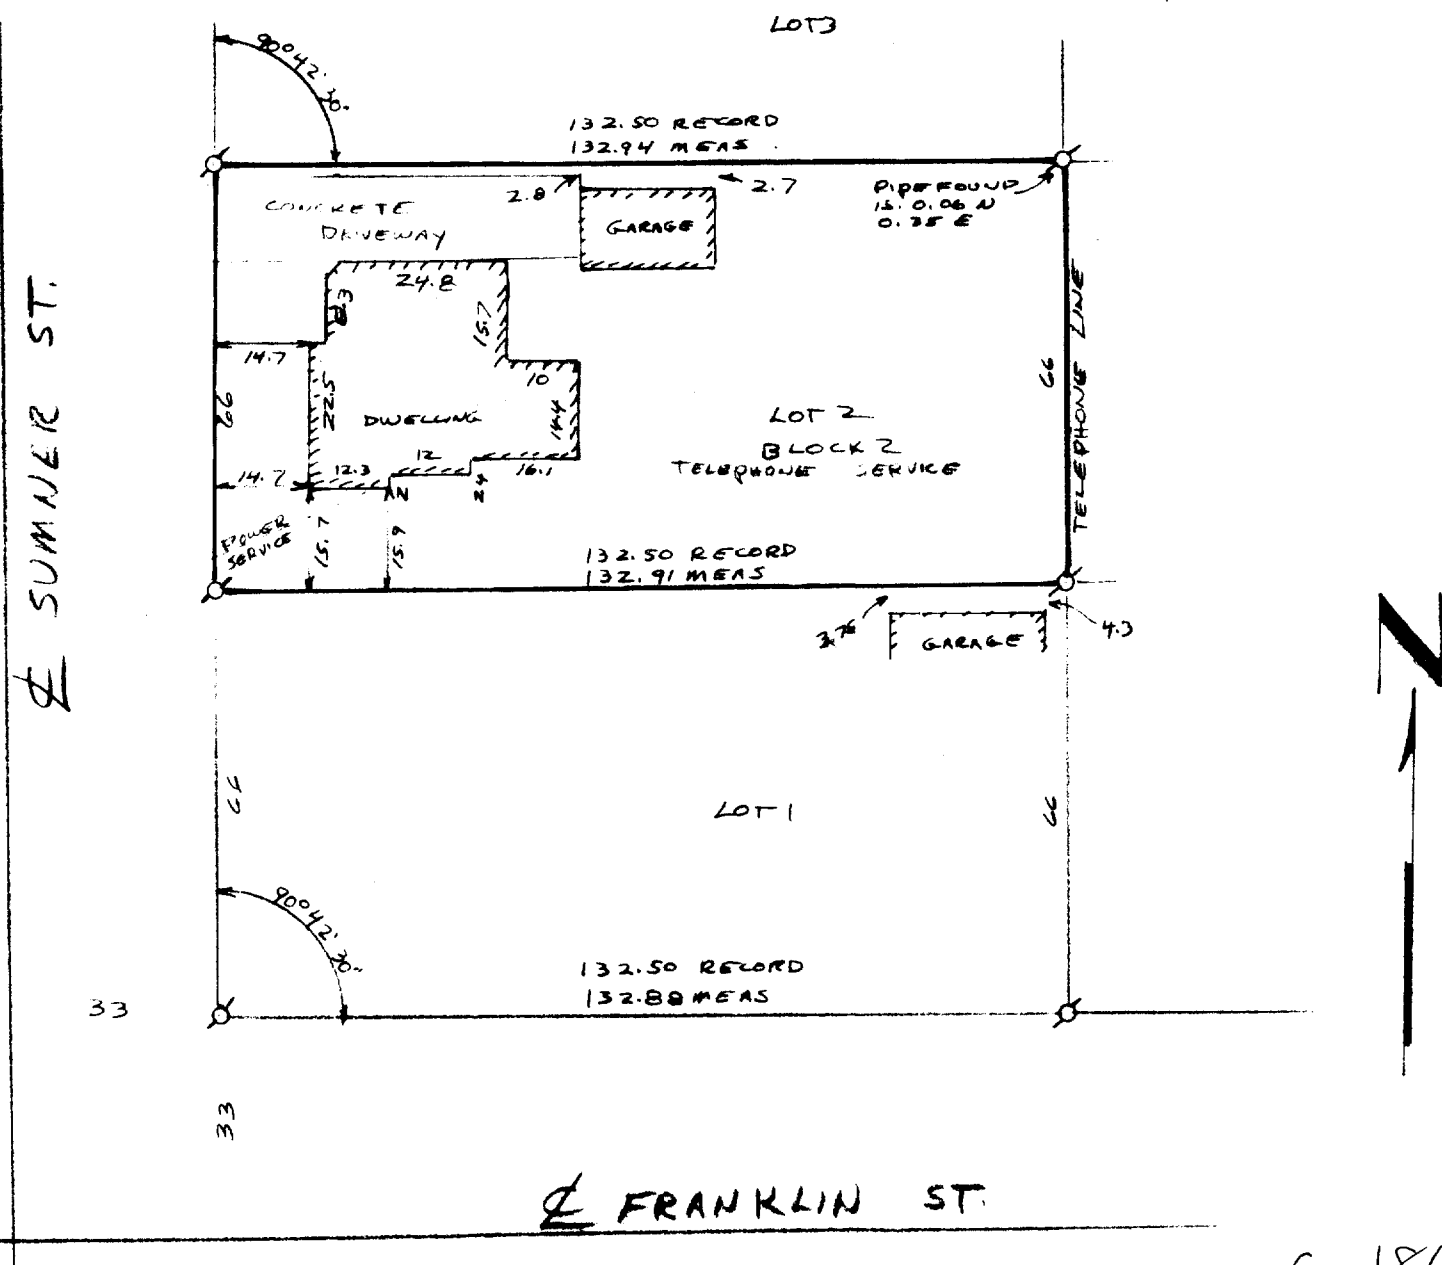

6-186

11-13 H46