



WALWORTH COUNTY
SURVEYING & MAPPING
LAKE GENEVA, WISCONSIN

PLACE OF BEGINNING

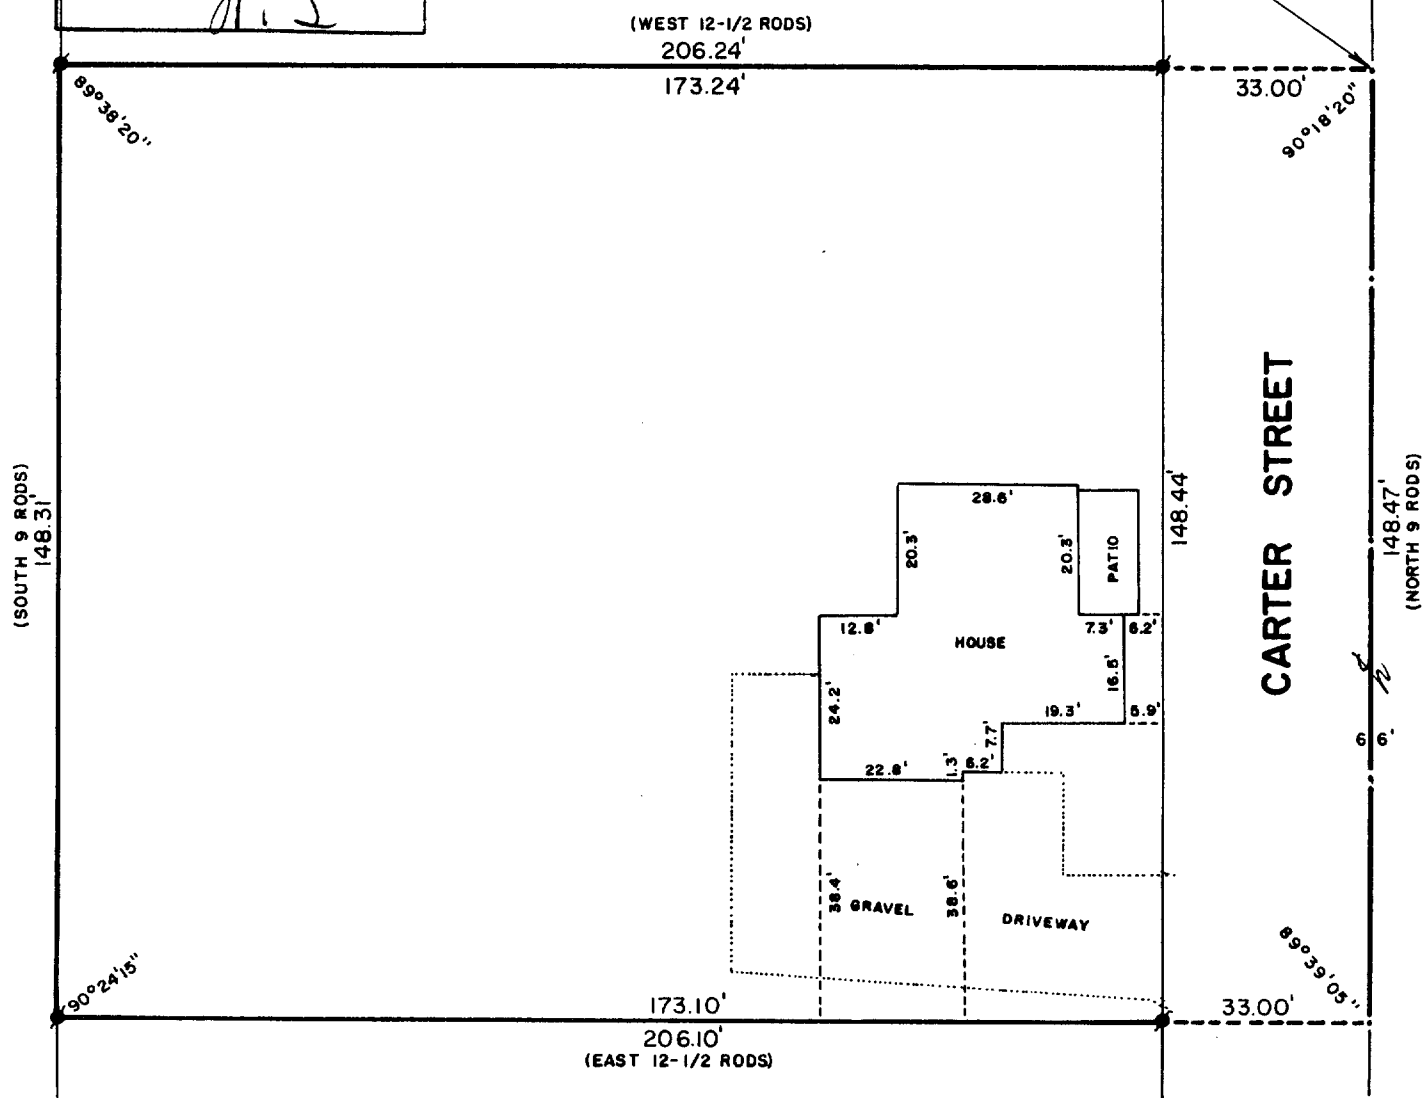

PLAT OF SURVEY OF

A PARCEL OF LAND LOCATED IN THE NORTHEAST 1/4 OF SECTION 35, T 1 N, R 18 E,
VILLAGE OF GENOA CITY, WALWORTH COUNTY, WISCONSIN, DESCRIBED AS FOLLOWS:
COMMENCING AT A POINT IN THE CENTER OF THE HIGHWAY 27 FEET SOUTH OF THE
SOUTH LINE OF THE GENOA JUNCTION CEMETERY; THENCE RUNNING WEST 12-1/5 RODS;
THENCE SOUTH 9 RODS; THENCE EAST 12-1/5 RODS; THENCE NORTH TO THE PLACE OF
BEGINNING, SITUATED IN THE VILLAGE OF GENOA JUNCTION, TOWNSHIP OF BLOOMFIELD,
WALWORTH COUNTY, WISCONSIN.

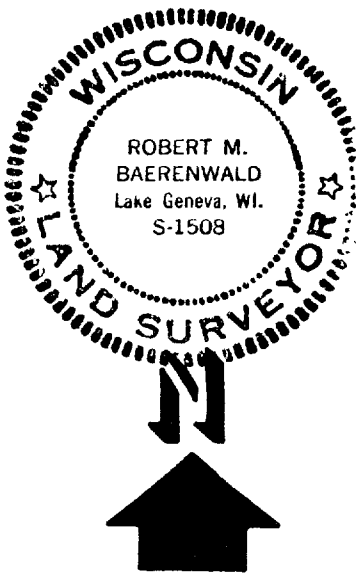

ORDERED BY: KENOSHA SAVINGS & LOAN
410 BROAD STREET
LAKE GENEVA, WISCONSIN 53147

I, ROBERT M. BAERENWALD, DO HEREBY CERTIFY THAT I
HAVE SURVEYED THE PROPERTY HEREON DESCRIBED ACCORDING
TO THE OFFICIAL RECORDS AND THAT THE PLAT HEREON IS A
CORRECT REPRESENTATION OF THE PROPERTY LINES TO THE
BEST OF MY KNOWLEDGE AND BELIEF.

Robert M. Baerenwald
ROBERT M. BAERENWALD
WISCONSIN REGISTERED LAND SURVEYOR, S-1508

May 22, 1986
DATE JOB NO. 0548

SCALE: 1"=30'

• - CONCRETE MONUMENT FOUND
() - RECORDED AS

6-187