
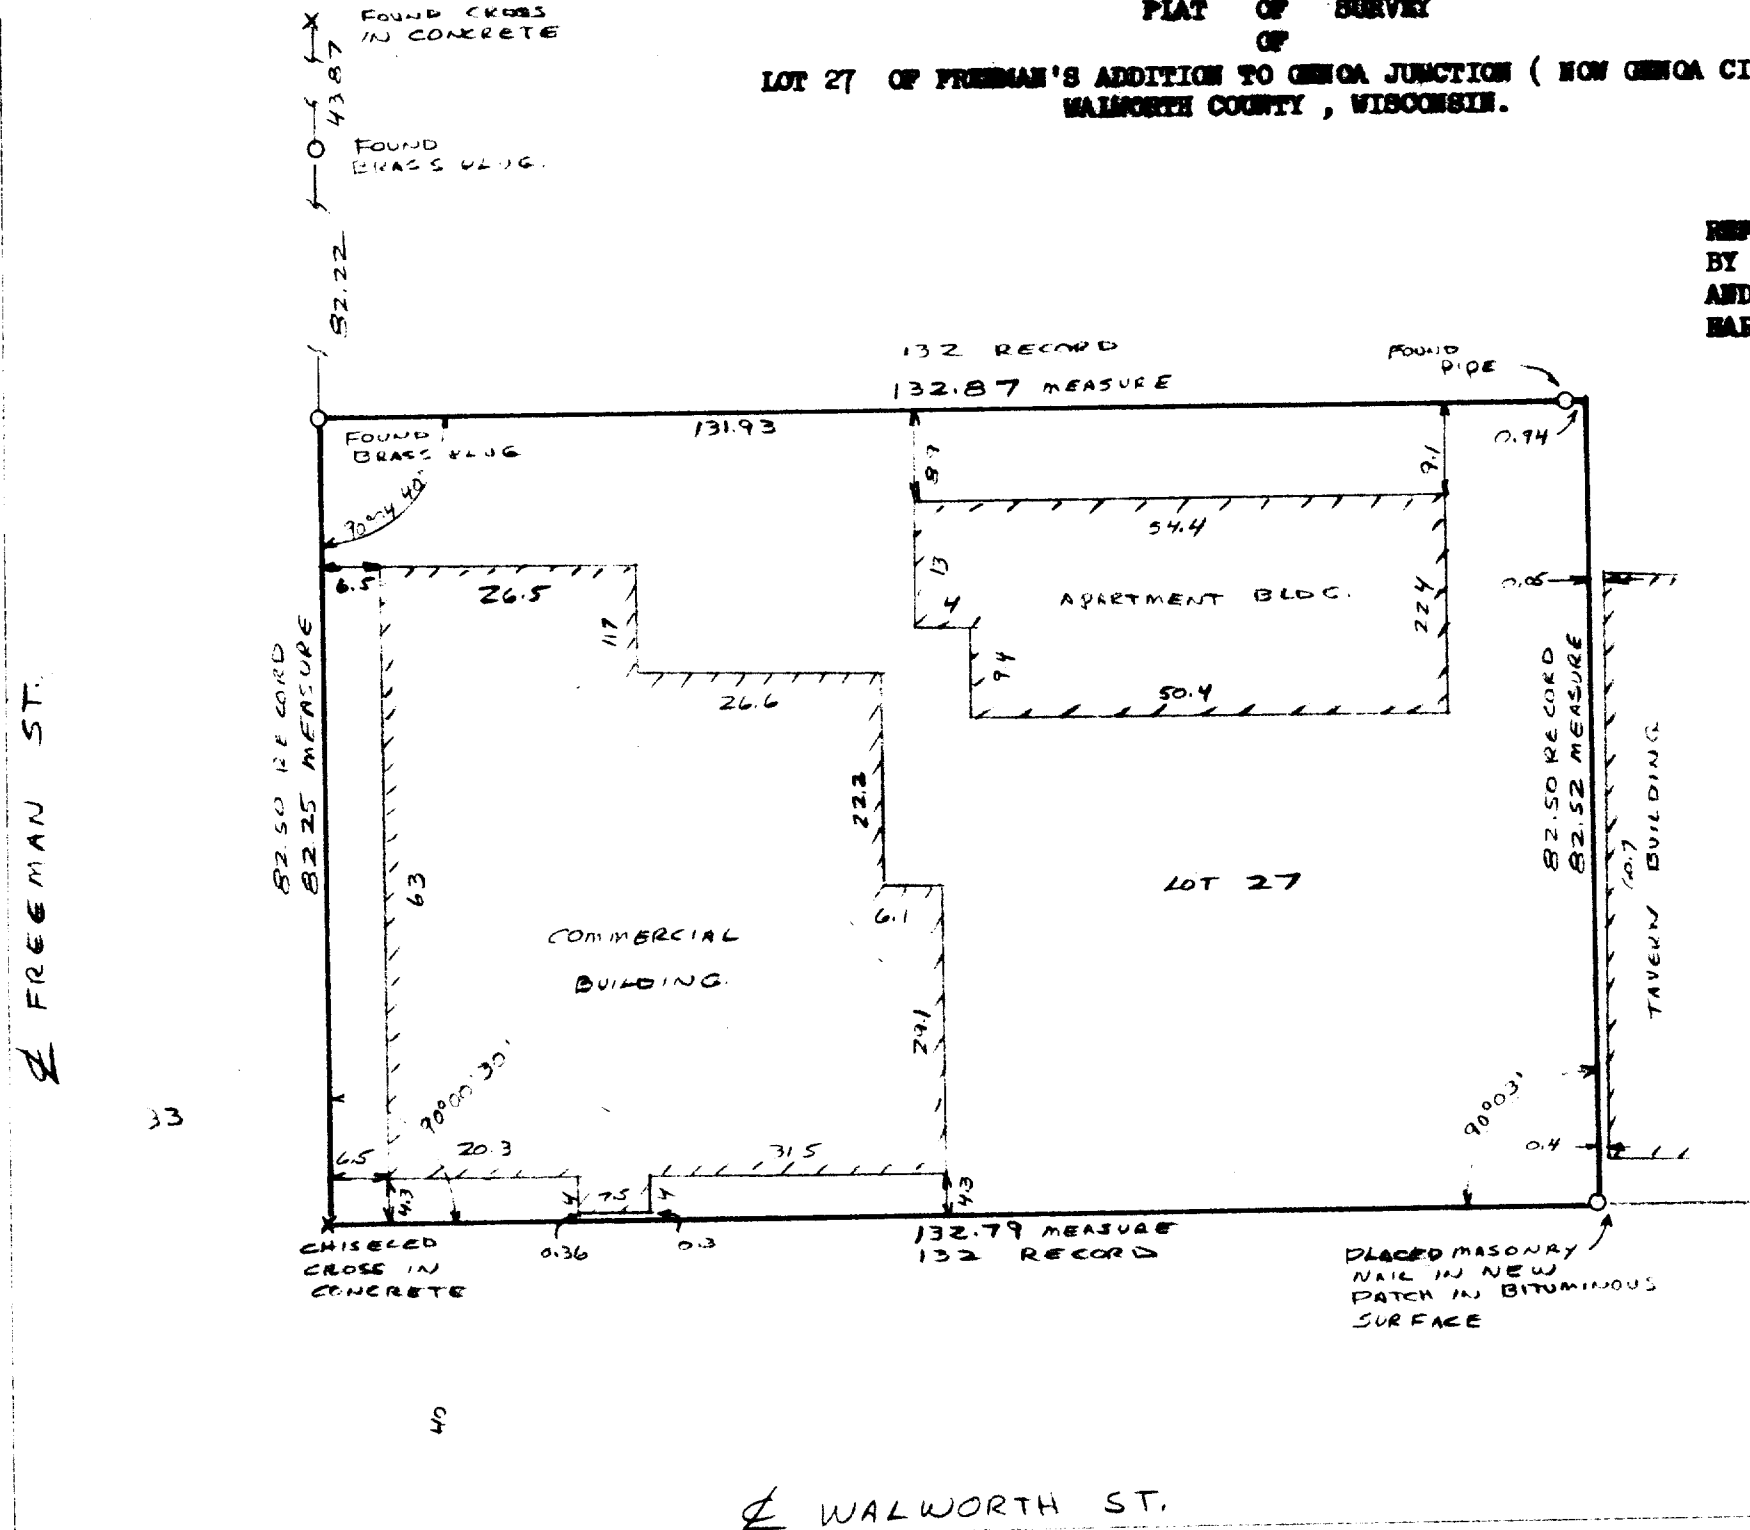


PLAT OF SURVEY OF

LOT 27 OF FREEMAN'S ADDITION TO GENOA JUNCTION (NOW GENOA CITY)
WALWORTH COUNTY, WISCONSIN.

FOR: JOE. MOOS
SCALE 1" = 20'
TYPE OF STAKES FOUND OR PLACED
AS NOTED ON PLAT.

REFERENCE IS MADE TO PRIOR SURVEY OF SAME LANDS
BY MCNEERY COUNTY LAND SURVEYORS DATED 5-20-80
AND TO SURVEY OF LANDS ADJOINING TO THE NORTH BY
HAROLD KOLB DATED 6-23-78

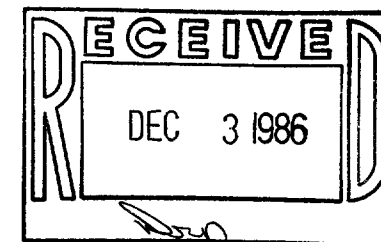

I have surveyed the above-described property and the map hereon is a true representation thereof and shows the size and location of the property, its exterior boundaries, the location and dimensions of all buildings thereon, fences, apparent easements, and roadways and visible encroachments.

This survey is made for the exclusive use of the present owner of the property, and also those who purchase, mortgage, or guarantee the title thereto within one year from date hereof.

Witness my hand and seal at Burlington, this 19th day
NOVEMBER 1986
John F. Dager
County Land Surveyor S 242

6-196

14-D-1 #51