


**WALWORTH COUNTY
SURVEYING & MAPPING
LAKE GENEVA, WISCONSIN**

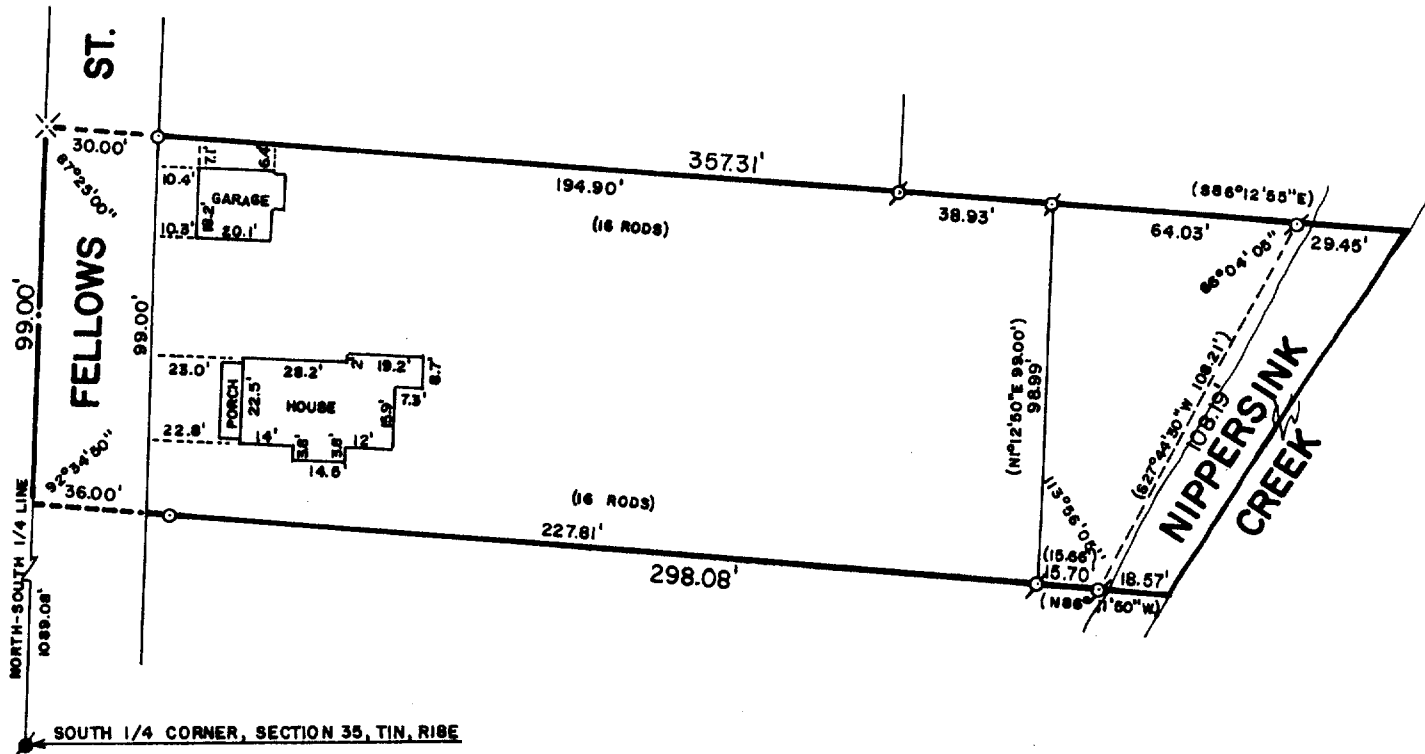


PLAT OF SURVEY OF

Commencing at a point six (6) rods North of the intersection of the North and South quarter ($\frac{1}{4}$) section line of Section 35, Town 1 North, Range 18 East, with the North line of Main Street in the Village of Genoa City; thence East parallel with the North line of said street sixteen (16) rods; thence North six (6) rods; thence West sixteen (16) rods to a cement post; thence South six (6) rods to the place of beginning.

Also, commencing at the Southwest corner of Lot 28 of Freeman's Addition to said Village; thence N $89^{\circ}00'00''$ W 269.69 feet to the Westerly right-of-way line of the Abandoned Chicago & Northwestern Railroad; thence S $35^{\circ}15'00''$ W 5.16 feet along the Westerly right-of-way line of said Railroad; thence N $16^{\circ}22'35''$ W 65.36 feet; thence N $87^{\circ}03'10''$ W 209.48 feet; thence S $18^{\circ}32'45''$ E 256.76 feet to the Westerly right-of-way line of said Railroad; thence S $35^{\circ}31'30''$ W 164.43 feet along the Westerly right-of-way line of said Railroad to a point on the North line of Main Street; thence N $86^{\circ}30'35''$ W 217.54 feet along the North line of said Street; thence N $1^{\circ}12'50''$ E 66.00 feet to the place of beginning; thence continue N $1^{\circ}12'50''$ E 99.00 feet; thence S $86^{\circ}12'55''$ E 64.03 feet to a point on a meanderline which is N $86^{\circ}12'55''$ W 29.45 feet from the centerline of Nippersink Creek; thence S $27^{\circ}44'30''$ W 108.21 feet along a meanderline to a point which is N $86^{\circ}11'50''$ W 18.57 feet from the centerline of said Creek; including all land between said meanderline and the centerline of said Creek; thence N $86^{\circ}11'50''$ W 15.66 feet to the place of beginning.

Tax Key No. TVGC-50
Tax Key No. TVGC-50A

ORDERED BY: BEAR REALTY
RT. 2, BOX 39
SALEM, WISCONSIN 53168

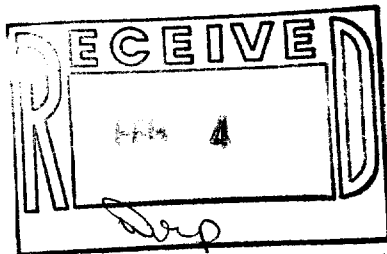

SCALE: 1"=50'

- ⊙ - IRON PIPE FOUND
- - CONCRETE MONUMENT FOUND
- - IRON ROD PLACED
- () - RECORDED AS

I, ROBERT M. BAERENWALD, DO HEREBY CERTIFY THAT I HAVE SURVEYED THE PROPERTY HEREON DESCRIBED ACCORDING TO THE OFFICIAL RECORDS AND THAT THE PLAT HEREON IS A CORRECT REPRESENTATION OF THE PROPERTY LINES TO THE BEST OF MY KNOWLEDGE AND BELIEF.

Robert M. Baerenwald
ROBERT M. BAERENWALD
WISCONSIN REGISTERED LAND SURVEYOR, S-1508

Nov. 24, 1936
DATE JOB NO. 0841

NOTE: THIS IS NOT A CERTIFIED COPY UNLESS SEALED.