
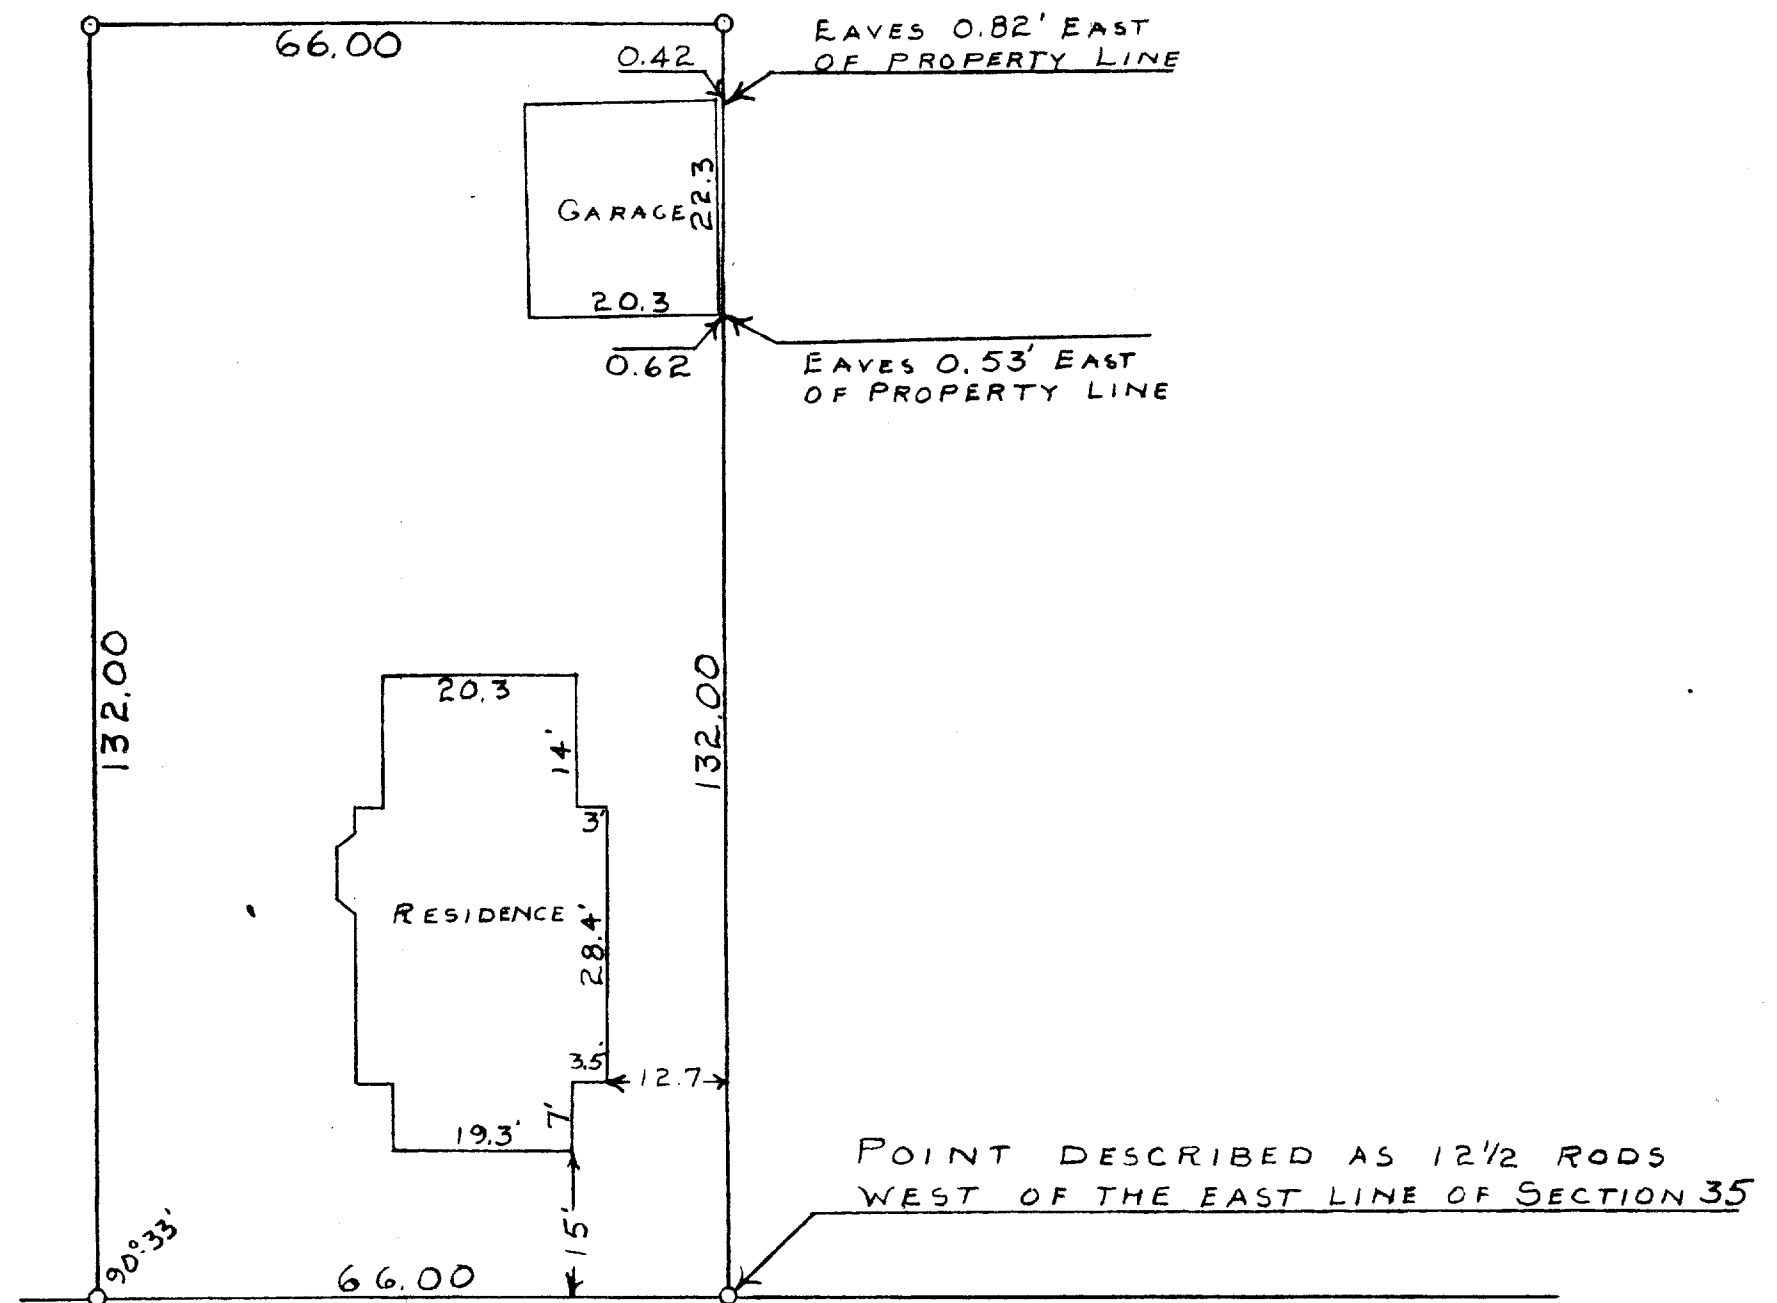


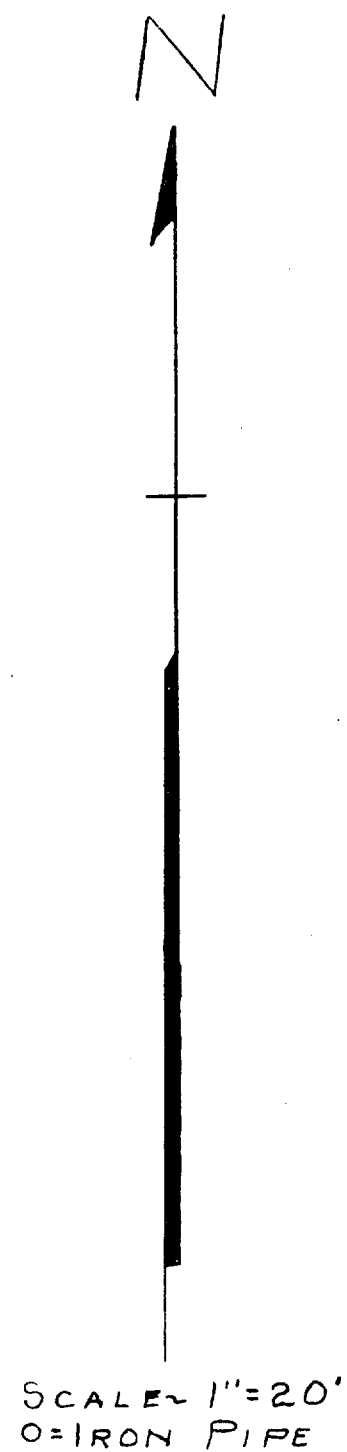

PLAT OF SURVEY OF A PARCEL OF LAND LOCATED IN THE NE 1/4 OF SECTION 35, T18N R18E OF THE VILLAGE OF GENOA CITY, WALWORTH COUNTY, WISCONSIN
AUGUST 30, 1955

George T. Dunham
GEORGE T. DUNHAM, SURVEYOR
DELAN, WISCONSIN

6-2

ATUG 6-12
K6C-22