


LOTS 1 AND 4, BLOCK 2 OF J. H. ROWE'S ADDITION TO GENOA JUNCTION, A SUBDIVISION LOCATED IN THE VILLAGE OF GENOA CITY, WALWORTH COUNTY, WISCONSIN.


O = IRON PIPE STAKE SET. 1983 {FOUND 1986}
{FOUND 1987}

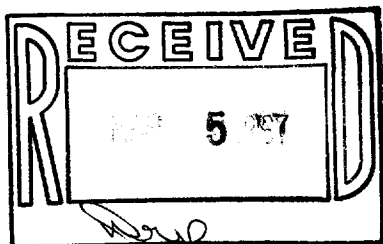

These surveys of the above-mentioned parameters and the map information are presented in the form of maps, the location and situation of the property, its external features, the lot area and dimensions, the number of floors, the floor area, apparent condition and techniques of using, and so on, as follows:

This survey is related to the survey carried out in the present work, but it is not possible to compare the two populations because of the lack of information on the size of the sample with respect to the number of subjects.

MAILED AT P. O. DAYTON, OH. 20th APR 1983
APRIL 83
John F. Degeen
John F. Degeen, Ford County, Ohio, 45340
RE-SURGE / 5-16-86
RE-SURGE / 2-20-87

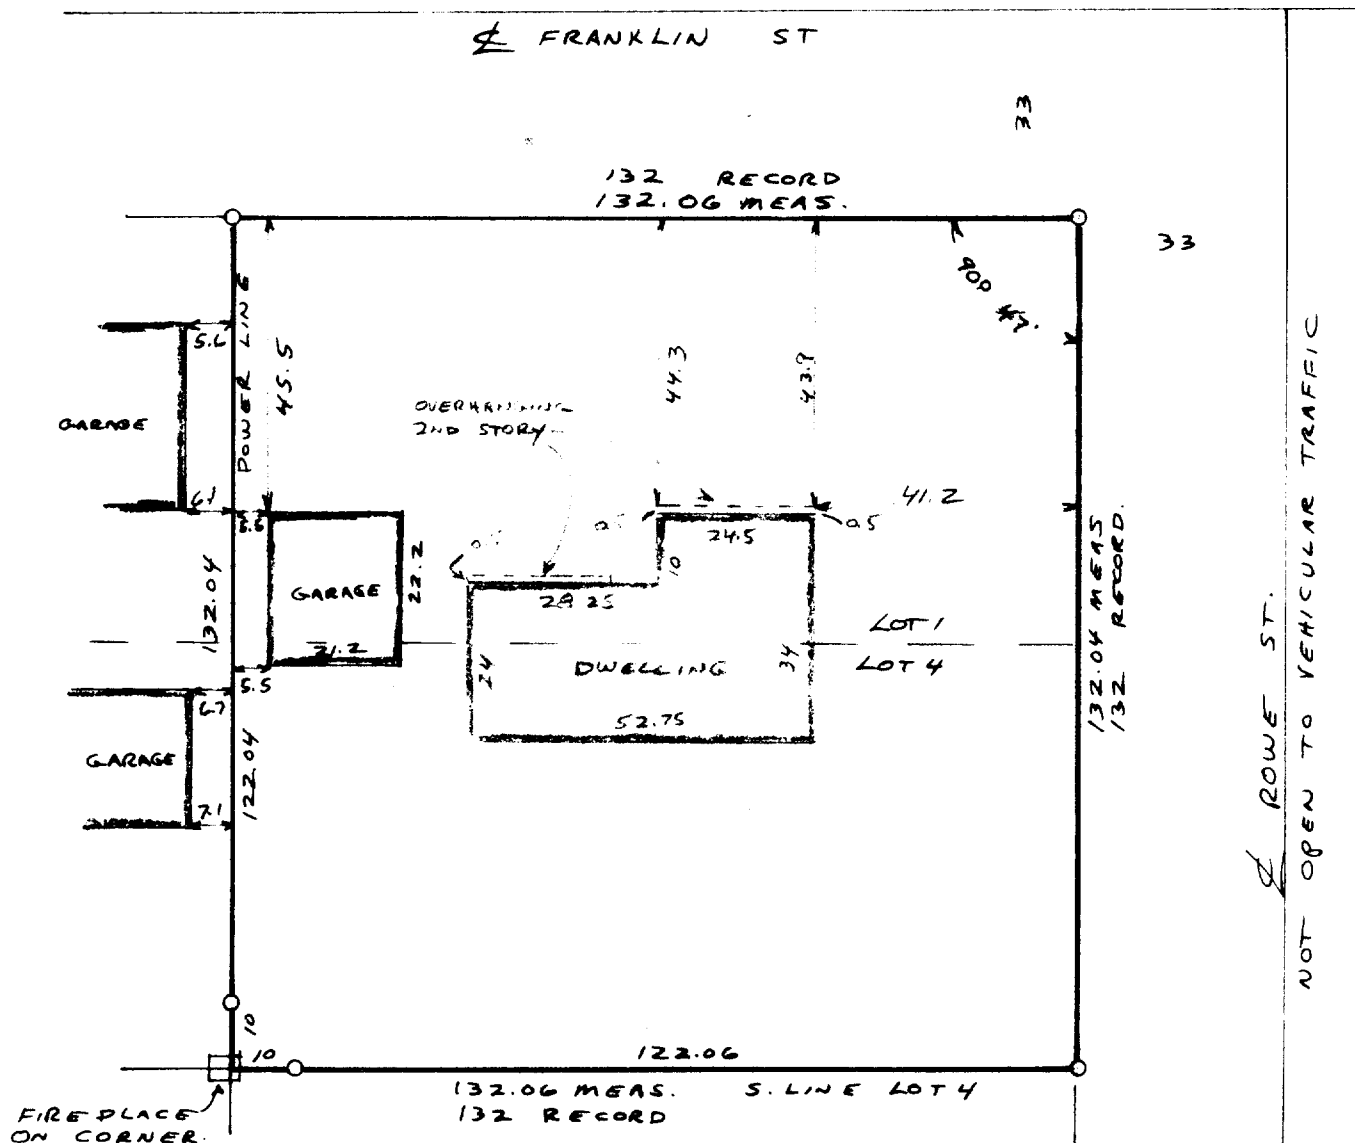

10

6-301