

PLAT OF SURVEY

THE SOUTH 1/2 OF LOT 7 AND THE SOUTH 1/2 OF LOT 8 AND ALL OF LOT 9, IN BLOCK 7 OF FREEMAN'S 2ND ADDITION TO THE VILLAGE OF GENOVA, A SUBDIVISION LOCATED IN THE WEST PART OF THE NORTHEAST 1/4 OF THE SOUTHEAST 1/4 OF SECTION 35, T. 1 N., R. 18 E. OF THE 4TH P.M. VILLAGE OF GENOVA CITY, WALNORTH COUNTY, WISCONSIN.

FOR: THE ESTATE OF EIMA E. LINK
1/4 LEE SWENSON

SCALE 1" = 40'


o = IRON STAKE FOUND.

o = IRON PIPE STAKE SET.

X = CROSS CHISELED IN CONCRETE
(FOUND IN PLACE.)

MEAS. DENOTES MEASURED LENGTH

REC. DENOTES RECORDED LENGTH.

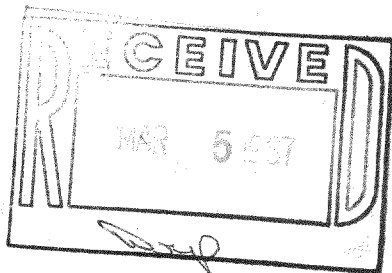

I have surveyed the above-described property, and the map herein is a true representation thereof and shows the size and location of the property, its exterior boundaries, the location and dimensions of all visible structures thereon, fences, apparent easements and roadways and visible encroachments, if any.

This survey is made for the exclusive use of the present owners of the property, and also those who purchase, mortgage, or guarantee the title thereto, within one year from date hereof.

Dated at Burlington, this 2ND day
of FEBRUARY, 1937
John F. Deegen
John F. Deegen, Land Surveyor 8242

