


PLAT OF SURVEY
OF

LOT 4, BLOCK 7, OF FREEMAN'S 2nd ADDITION TO THE VILLAGE OF GENOA CITY, A SUBDIVISION LOCATED IN THE WEST PART OF THE NORTHEAST 1/4 OF THE SOUTHEAST 1/4 OF SECTION 35, T. 1 N., R. 18 E. OF THE 4TH P.M., VILLAGE OF GENOA CITY, WALWORTH COUNTY, WISCONSIN.

FOR: GEORGE AND DEBBY MILLER

SCALE 1" = 20'

o = IRON PIPE STAKE SET.

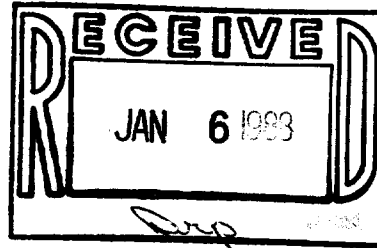


I have surveyed the above-described property and the map hereon is a true representation thereof and shows the size and location of the property, its exterior boundaries, the location and dimensions of all visible structures thereon, fences, apparent easements and roadways and visible encroachments, if any.

This survey is made for the exclusive use of the present owners of the property, and also those who purchase, mortgage, or guarantee the title thereto, within one year from date hereof.

Dated at Burlington, this 8th day of DECEMBER, 1982.

John F. Degen
John F. Degen, Lead Surveyor S 242

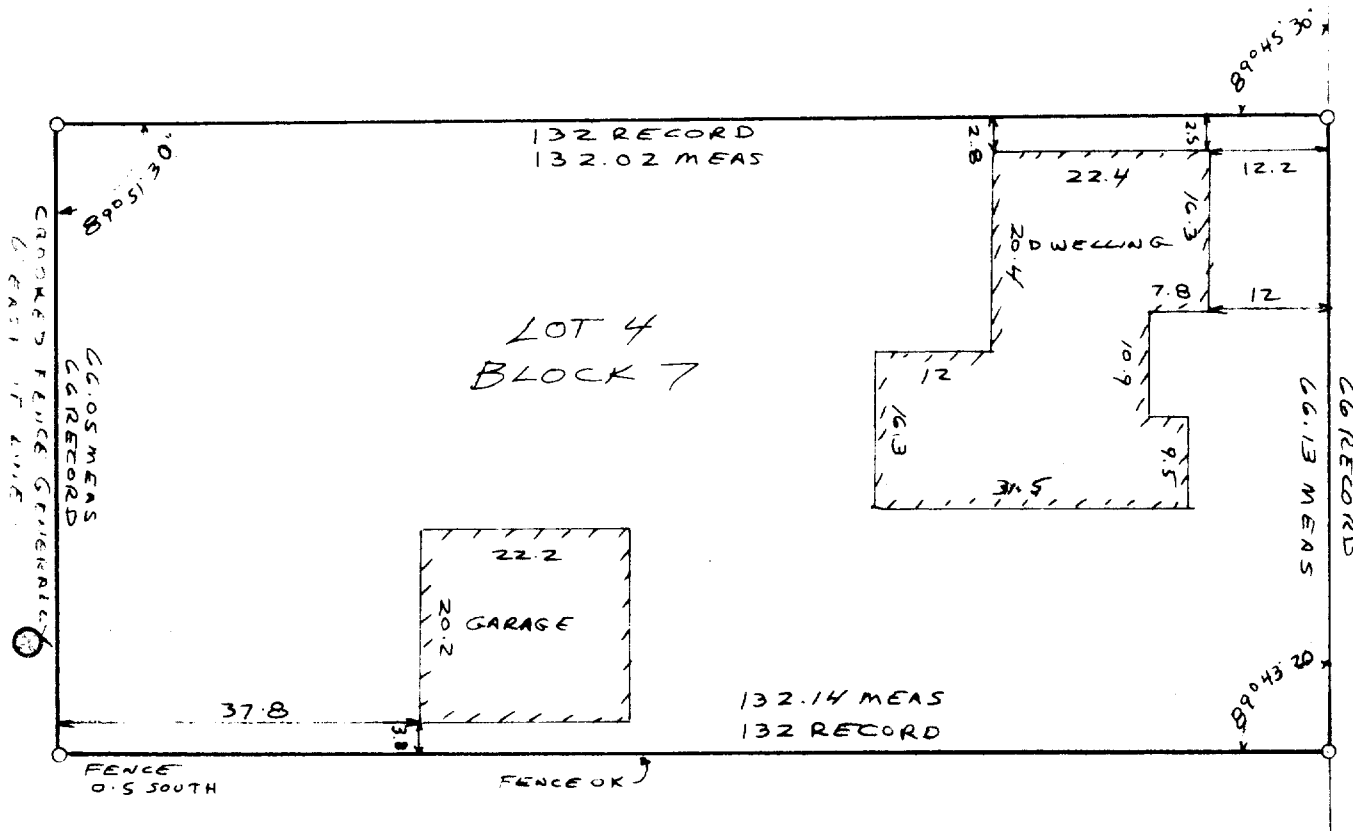

WISCONSIN ST.

