



SCALE 1" = 30'

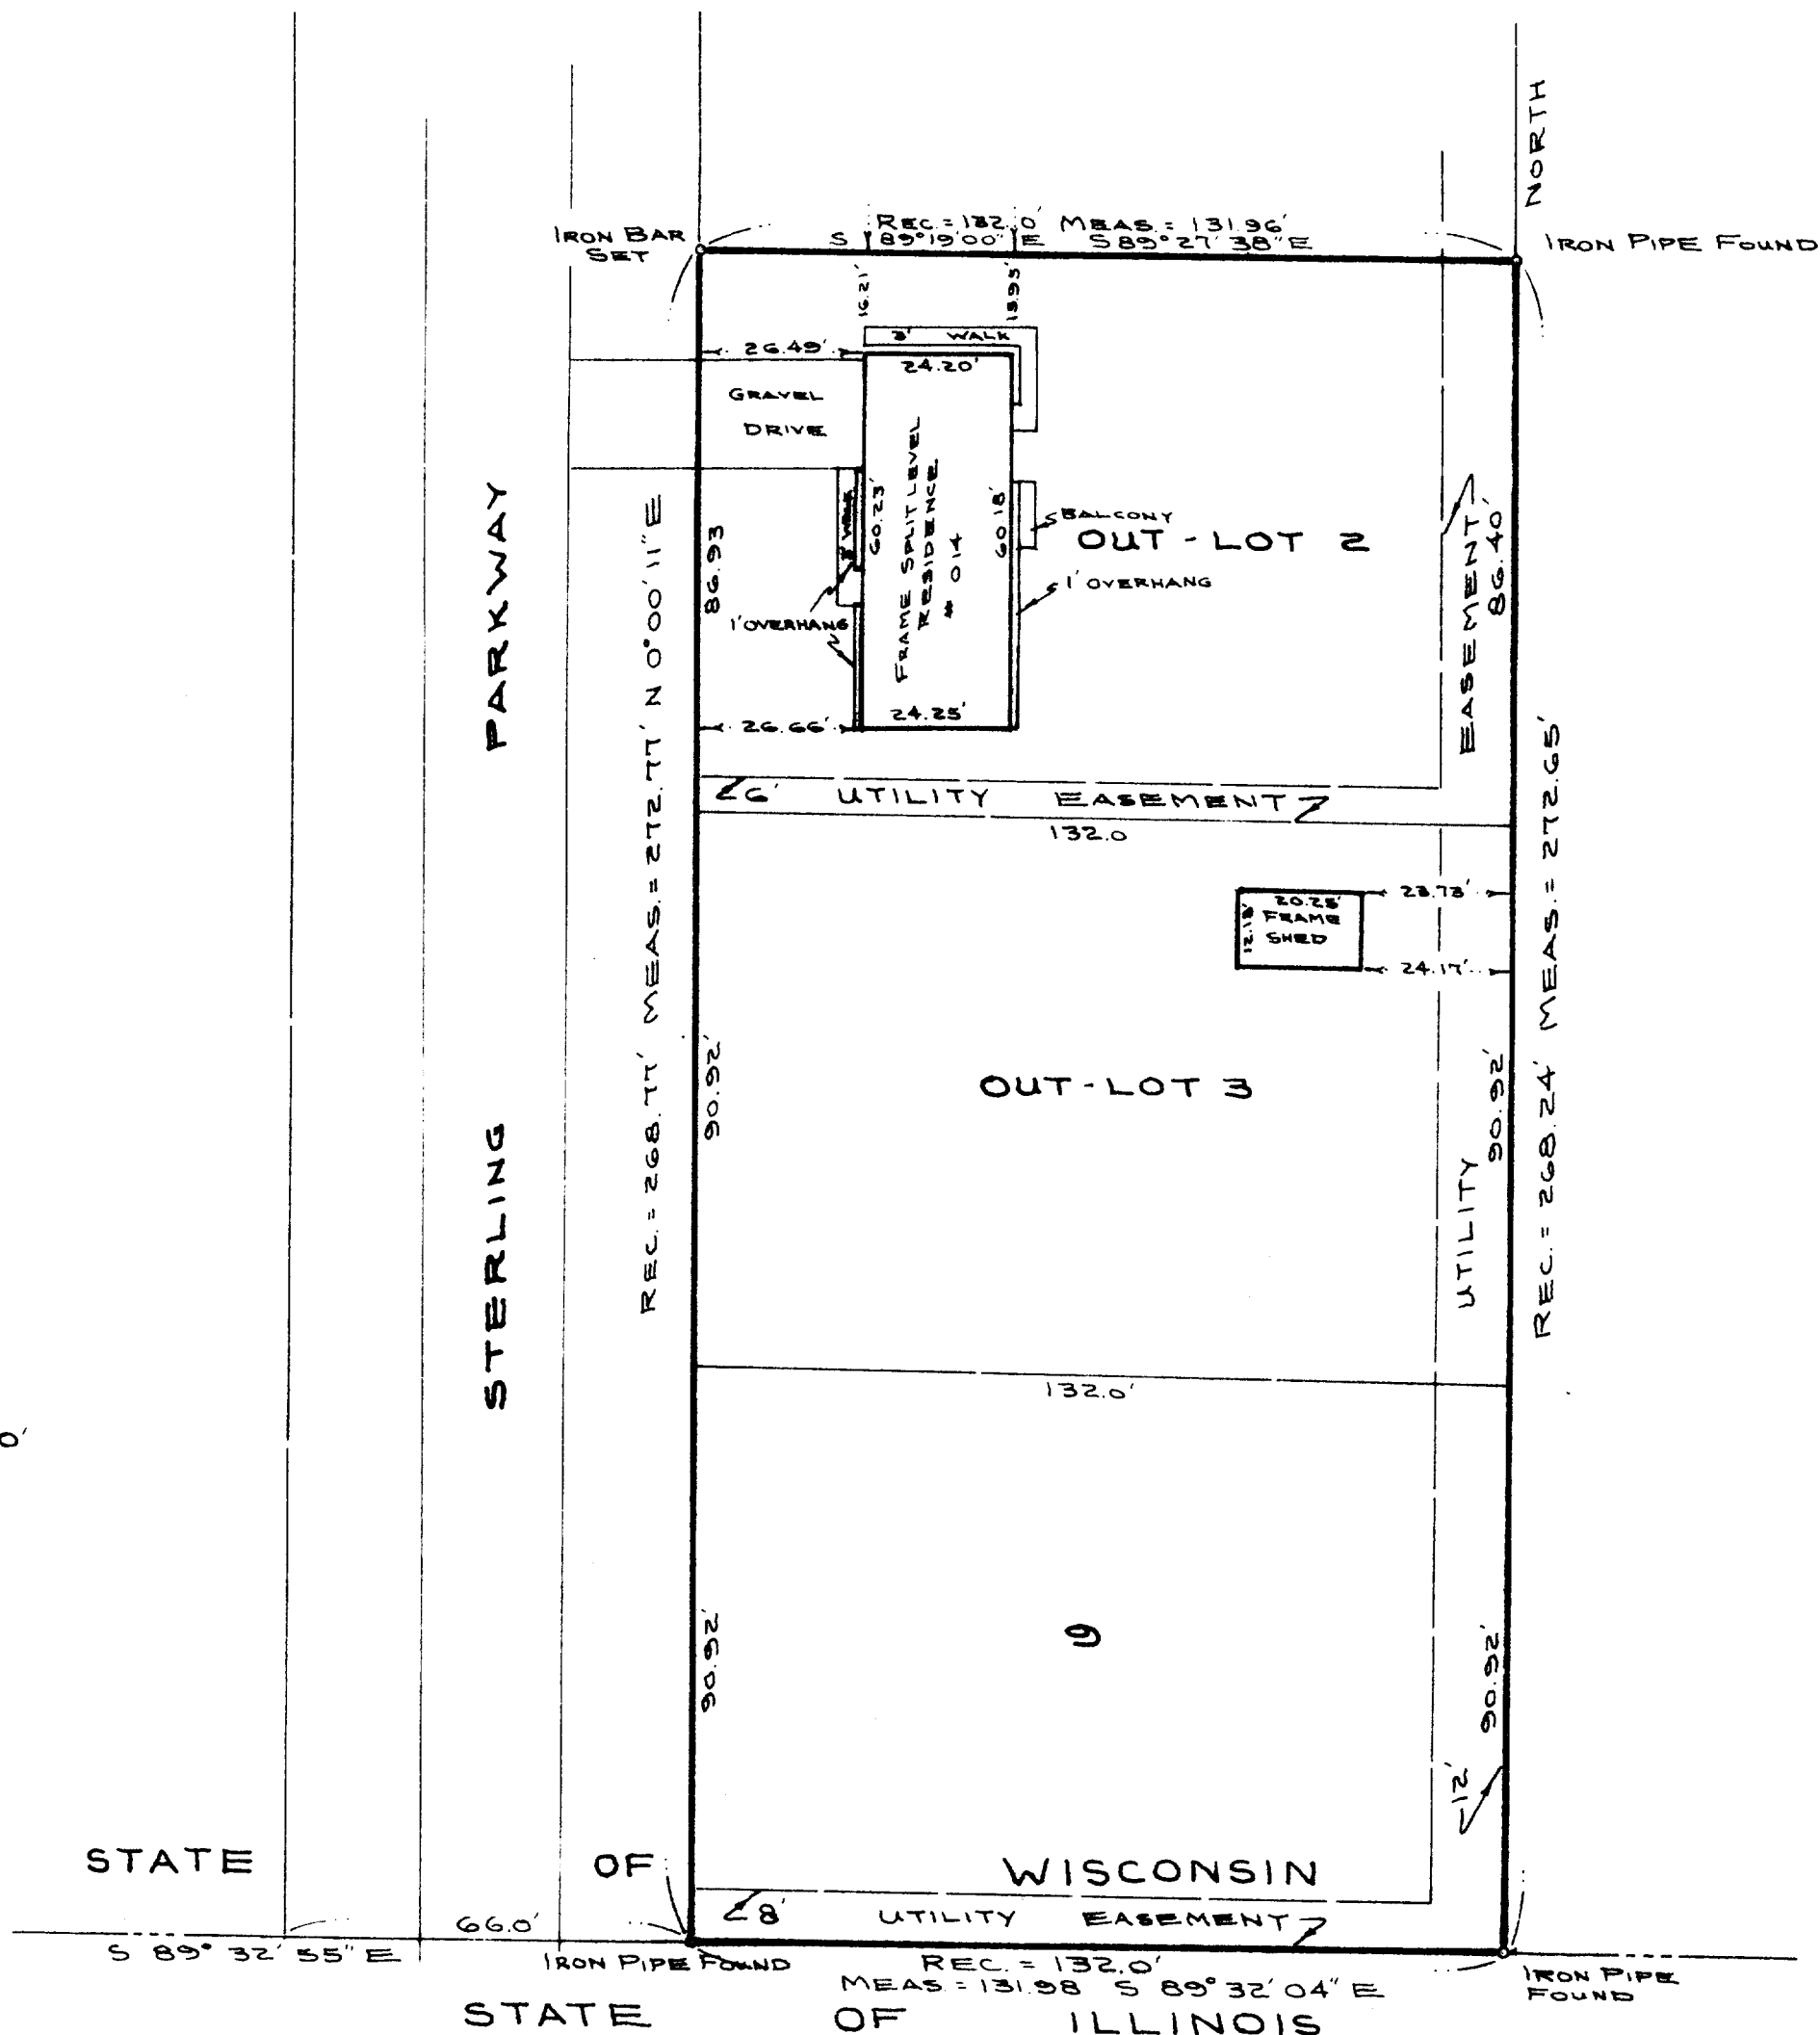

I, MARK A. BOLENDER, DO HEREBY CERTIFY THAT I HAVE ~~SURVEYED~~ THE PROPERTY HEREON DESCRIBED ACCORDING TO THE OFFICIAL RECORDS, AND THAT THE PLAT HEREON IS A CORRECT REPRESENTATION OF THE LOT LINES TO THE BEST OF MY KNOWLEDGE AND BELIEF.

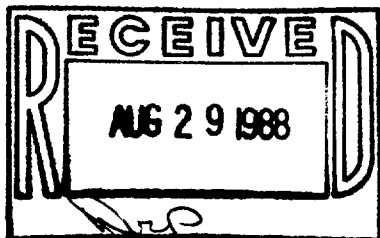

Mark A. Bolender
MARK A. BOLENDER
WISCONSIN REGISTERED LAND SURVEYOR, S-1784