


WALWORTH COUNTY
SURVEYING & MAPPING
LAKE GENEVA, WISCONSIN

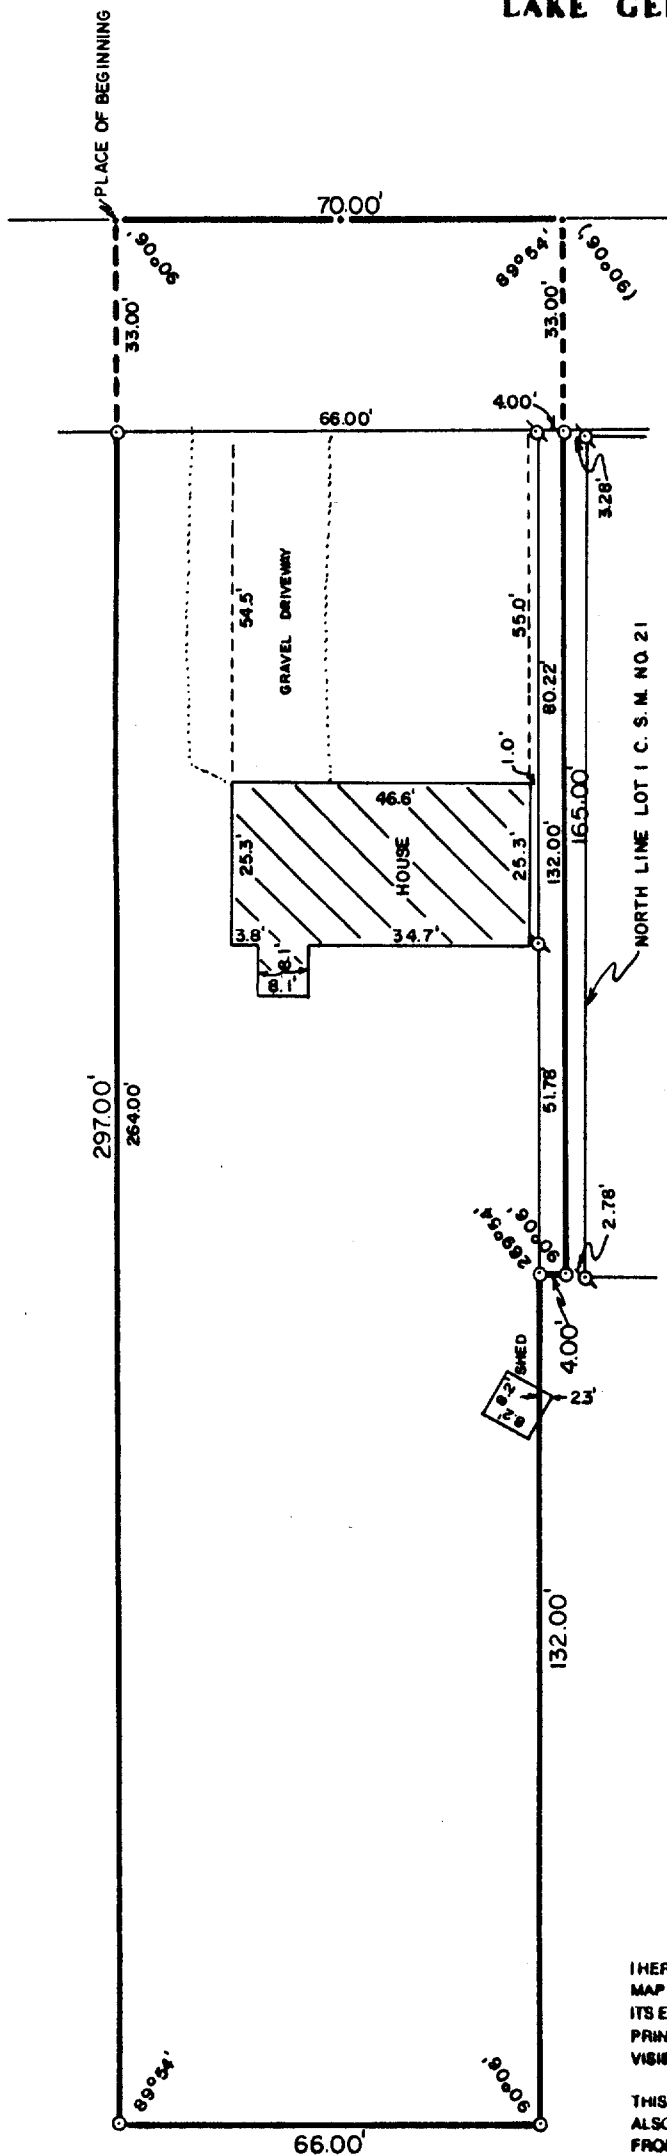


PLAT OF SURVEY OF

BEGINNING AT THE NORTHEAST CORNER OF SECTION 35, T 1 N, R 18 E, THENCE SOUTH 4 RODS TO THE PLACE OF BEGINNING OF PARCEL HEREBY DESCRIBED; THENCE SOUTH ON THE EAST SECTION LINE 4 RODS AND 4 FEET; THENCE WEST PARALLEL WITH THE NORTH LINE OF SAID SECTION 10 RODS; THENCE NORTH PARALLEL WITH THE EAST LINE OF SAID SECTION 4 FEET; THENCE WEST PARALLEL WITH THE NORTH LINE OF SAID SECTION 8 RODS; THENCE NORTH PARALLEL WITH THE EAST LINE OF SAID SECTION 4 RODS; THENCE EAST 18 RODS TO THE PLACE OF BEGINNING IN THE VILLAGE OF GENOA CITY, WALWORTH COUNTY, WISCONSIN.

ORDERED BY: KENOSHA SAVINGS & LOAN
410 BROAD STREET
LAKE GENEVA, WISCONSIN

NOTE: THIS SURVEY IS BASED ON A PLAT OF SURVEY BY GEORGE DUNHAM DATED OCTOBER 14, 1954.

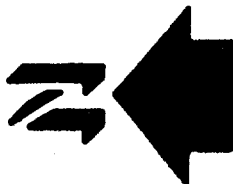


SCALE: 1"=30'

○ - IRON PIPE FOUND
○ - IRON ROD PLACED
() - RECORDED AS

I HEREBY CERTIFY THAT I HAVE SURVEYED THE ABOVE DESCRIBED PROPERTY AND THAT THE ABOVE MAP IS A TRUE REPRESENTATION THEREOF AND SHOWS THE SIZE AND LOCATION OF THE PROPERTY, ITS EXTERIOR BOUNDARIES, THE LOCATION OF ALL VISIBLE STRUCTURES AND DIMENSIONS OF ALL PRINCIPAL BUILDINGS THEREON, BOUNDARY FENCES, APPARENT EASEMENTS AND ROADWAYS AND VISIBLE ENCROACHMENTS, IF ANY.

THIS SURVEY IS MADE FOR THE EXCLUSIVE USE OF THE PRESENT OWNERS OF THE PROPERTY, AND ALSO THOSE WHO PURCHASE, MORTGAGE, OR GUARANTEE THE TITLE THERETO WITHIN ONE (1) YEAR FROM DATE HEREOF.

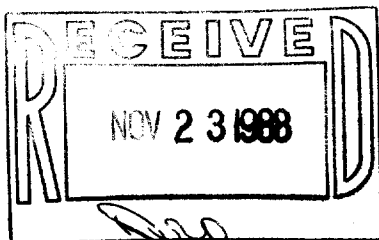

Robert M. Baerenwald
ROBERT M. BAERENWALD
WISCONSIN REGISTERED LAND SURVEYOR, S-1508

Sept. 13, 1988
DATE JOB NO. 1674

NOTE: THIS IS NOT A CERTIFIED COPY UNLESS SEALED.

6-222