

KOLB LAND CONSULTING, INC.
LAND SURVEYING • SUBDIVIDING • LAND PLANNING


929 WILLIAMS STREET

LAKE GENEVA, WISCONSIN 53147

414-248-3697



SCALE 1" = 40'

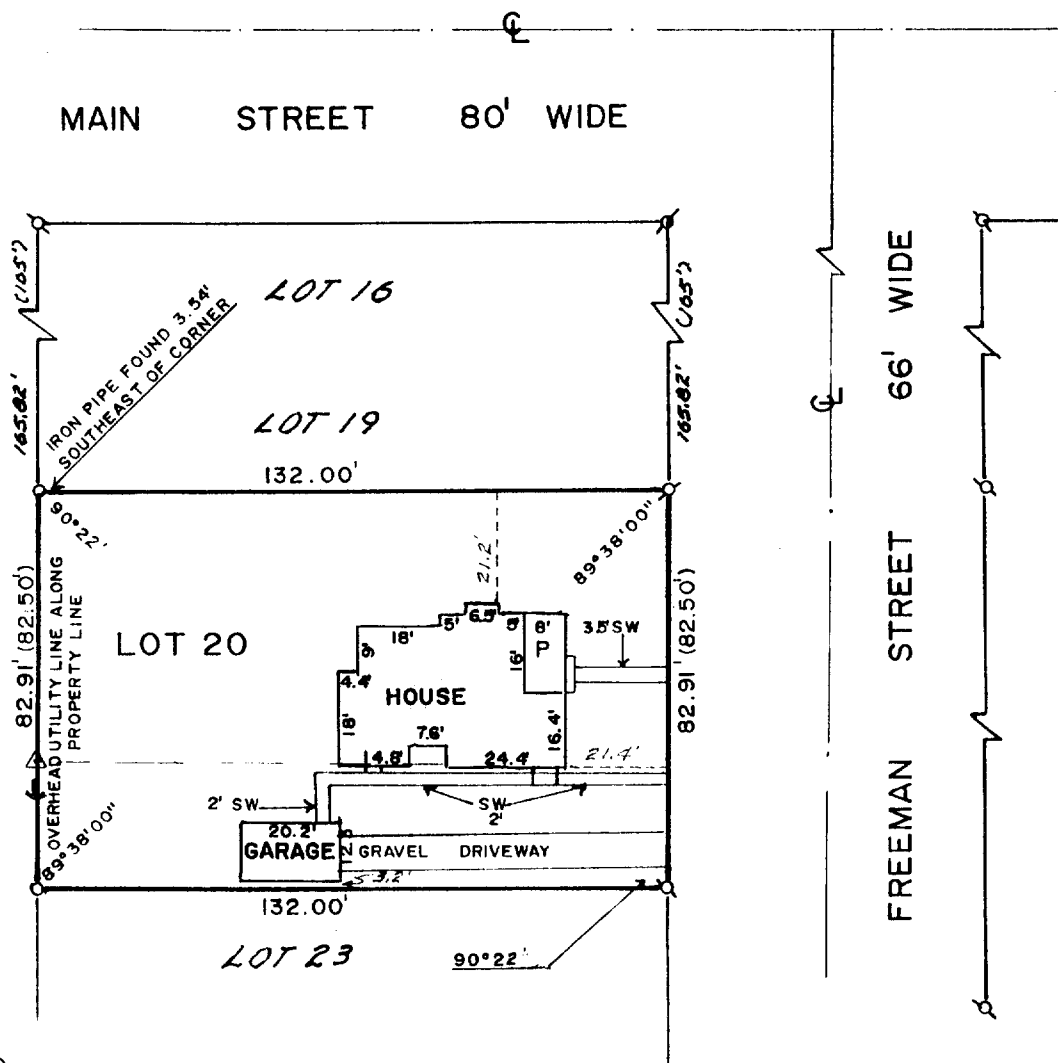

LEGEND

- ⊗ - IRON PIPE FOUND
- ⊗ - IRON ROD FOUND
- - IRON PIPE SET
- △ - UTILITY POLE
- SW - SIDEWALK
- P - PORCH
- - OVERHEAD UTILITY LINE
- () - AS RECORDED
- ↓ - UTILITY POLE ANCHOR

PLAT OF SURVEY OF

LOT 20, OF THE ORIGINAL PLAT, OF THE
VILLAGE OF GENOA CITY, WALWORTH COUNTY
WISCONSIN.

I HEREBY CERTIFY THAT I HAVE SURVEYED THE
ABOVE DESCRIBED PROPERTY AND THAT THE ABOVE
MAP IS A TRUE REPRESENTATION THEREOF AND
SHOWS THE SIZE AND LOCATION OF THE PROPERTY,
ITS EXTERIOR BOUNDARIES, THE LOCATION OF ALL
VISIBLE STRUCTURES AND DIMENSIONS OF ALL
PRINCIPAL BUILDINGS THEREON, BOUNDARY FENCES,
APPARENT EASEMENTS, ROADWAYS AND VISIBLE
ENCROACHMENTS, IF ANY TO THE BEST OF MY
KNOWLEDGE AND BELIEF.

THIS SURVEY IS MADE FOR THE USE OF THE
PRESENT OWNERS OF THE PROPERTY, AND ALSO
THOSE WHO PURCHASE, MORTGAGE, OR GUARANTEE
THE TITLE THERETO WITHIN ONE (1) YEAR FROM
DATE HEREOF.

SURVEY NOT VALID UNLESS SURVEYOR'S
SIGNATURE IS IN RED.

HAROLD H. KOLB

WISCONSIN REGISTERED LAND SURVEYOR, S-187

DATE JULY 21, 1988

REVISED

REVISED

ORDERED BY: CORA HOBBS

123 S. FREEMAN ST.
GENOA CITY, WI
53128

