


PLAT OF SURVEY  
OF

LOT 2, BLOCK 1 OF STRAIN'S ADDITION, VILLAGE OF GENOA CITY, WALWORTH COUNTY, WISCONSIN.

FOR: JERRY JONES

SCALE 1" = 30'

o = IRON STAKE FOUND.

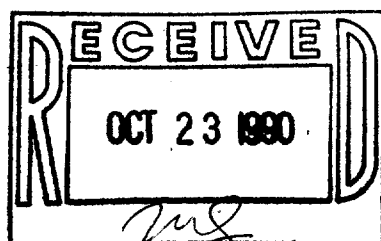


I have surveyed the above-described property, and the map hereon is a true representation thereof and shows the size and location of the property, its exterior boundaries, the location and dimensions of all visible structures thereon, fences, apparent easements and roadways and visible encroachments, if any.

This survey is made for the exclusive use of the present owners of the property, and also those who purchase, mortgage, or guarantee the title thereto, within one year from date hereof,

Dated at Burlington, this 15<sup>TH</sup> day, of OCTOBER, 1990

John F. Degan  
John F. Degan, Land Surveyor S 242  
589 W. Pine St. Burlington, WI 53105

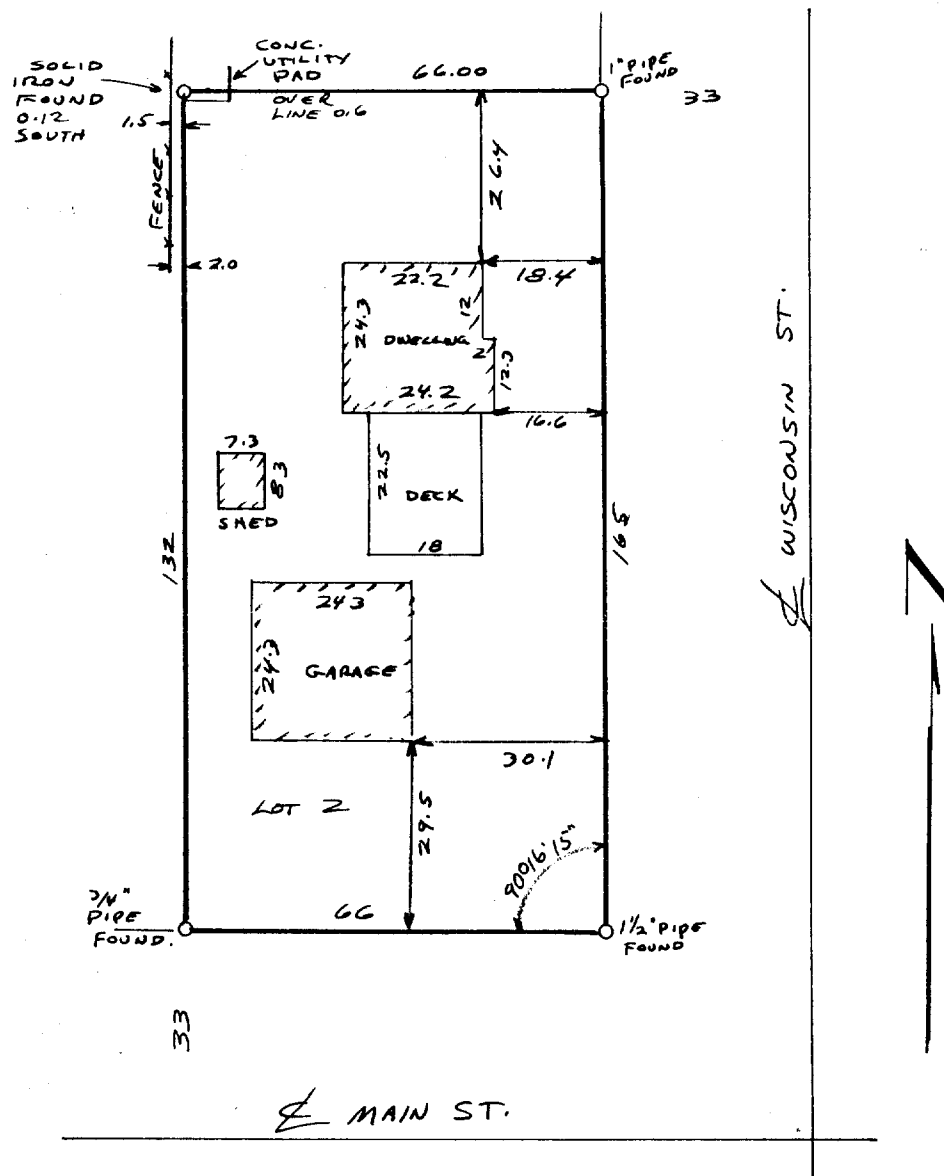

TAX KEY # TS 00002

6-249