

WALWORTH COUNTY
SURVEYING & MAPPING
LAKE GENEVA, WISCONSIN
414-248-0505

3

(66')
66.03'

89°39'

90°25'

GRAVEL DRIVEWAY

BLOCK 4

(132')
131.99'

132.06'
(132')

2

PLAT OF SURVEY OF

LOT 1, BLOCK 4 OF GIFFORD'S
ADDITION TO THE VILLAGE OF
GENOA CITY, WALWORTH COUNTY,
WISCONSIN.

ORDERED BY: REMA PLAZA
4005 KANE AVENUE
MCHEERY, ILLINOIS

FREEMAN STREET

20.6'

8'

38.5'

RESIDENCE

20.3'

25.5'

25.8'

PORCH


12.7'

90°35'


89°25'

66.18'
(66')

GIFFORD STREET

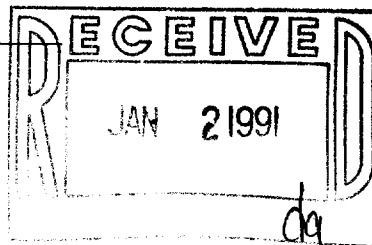

SCALE IN FEET

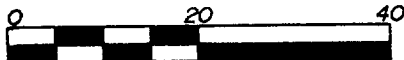

⊕-IRON PIPE FOUND
()-RECORDED AS

I HEREBY CERTIFY THAT I HAVE SURVEYED THE ABOVE DESCRIBED PROPERTY AND THAT THE ABOVE MAP IS A TRUE REPRESENTATION THEREOF AND SHOWS THE SIZE AND LOCATION OF THE PROPERTY, ITS EXTERIOR BOUNDARIES, THE LOCATION OF ALL VISIBLE STRUCTURES AND DIMENSIONS OF ALL PRINCIPAL BUILDINGS THEREON, BOUNDARY FENCES, APPARENT EASEMENTS AND ROADWAYS AND VISIBLE ENCROACHMENTS, IF ANY, TO THE BEST OF MY KNOWLEDGE AND BELIEF.

THIS SURVEY IS MADE FOR THE USE OF THE PRESENT OWNERS OF THE PROPERTY AND ALSO THOSE WHO PURCHASE, MORTGAGE OR GUARANTEE THE TITLE THEREIN WITHIN ONE (1) YEAR FROM DATE HEREOF.

Robert M. Baerenwald
ROBERT M. BAERENWALD
WISCONSIN REGISTERED LAND SURVEYOR, S-1508

DATE *Oct. 29, 1989*
JOB NO. 2249

NOTE: THIS IS NOT A CERTIFIED COPY UNLESS SEALED

Survey # 106-251

TAX KEY # 106-251